


POLK COUNTY

SCALE 1"=400'

SEE MAP NO. 6 6 30

25 | 30  
36 | 31

30 | 29  
31 | 32

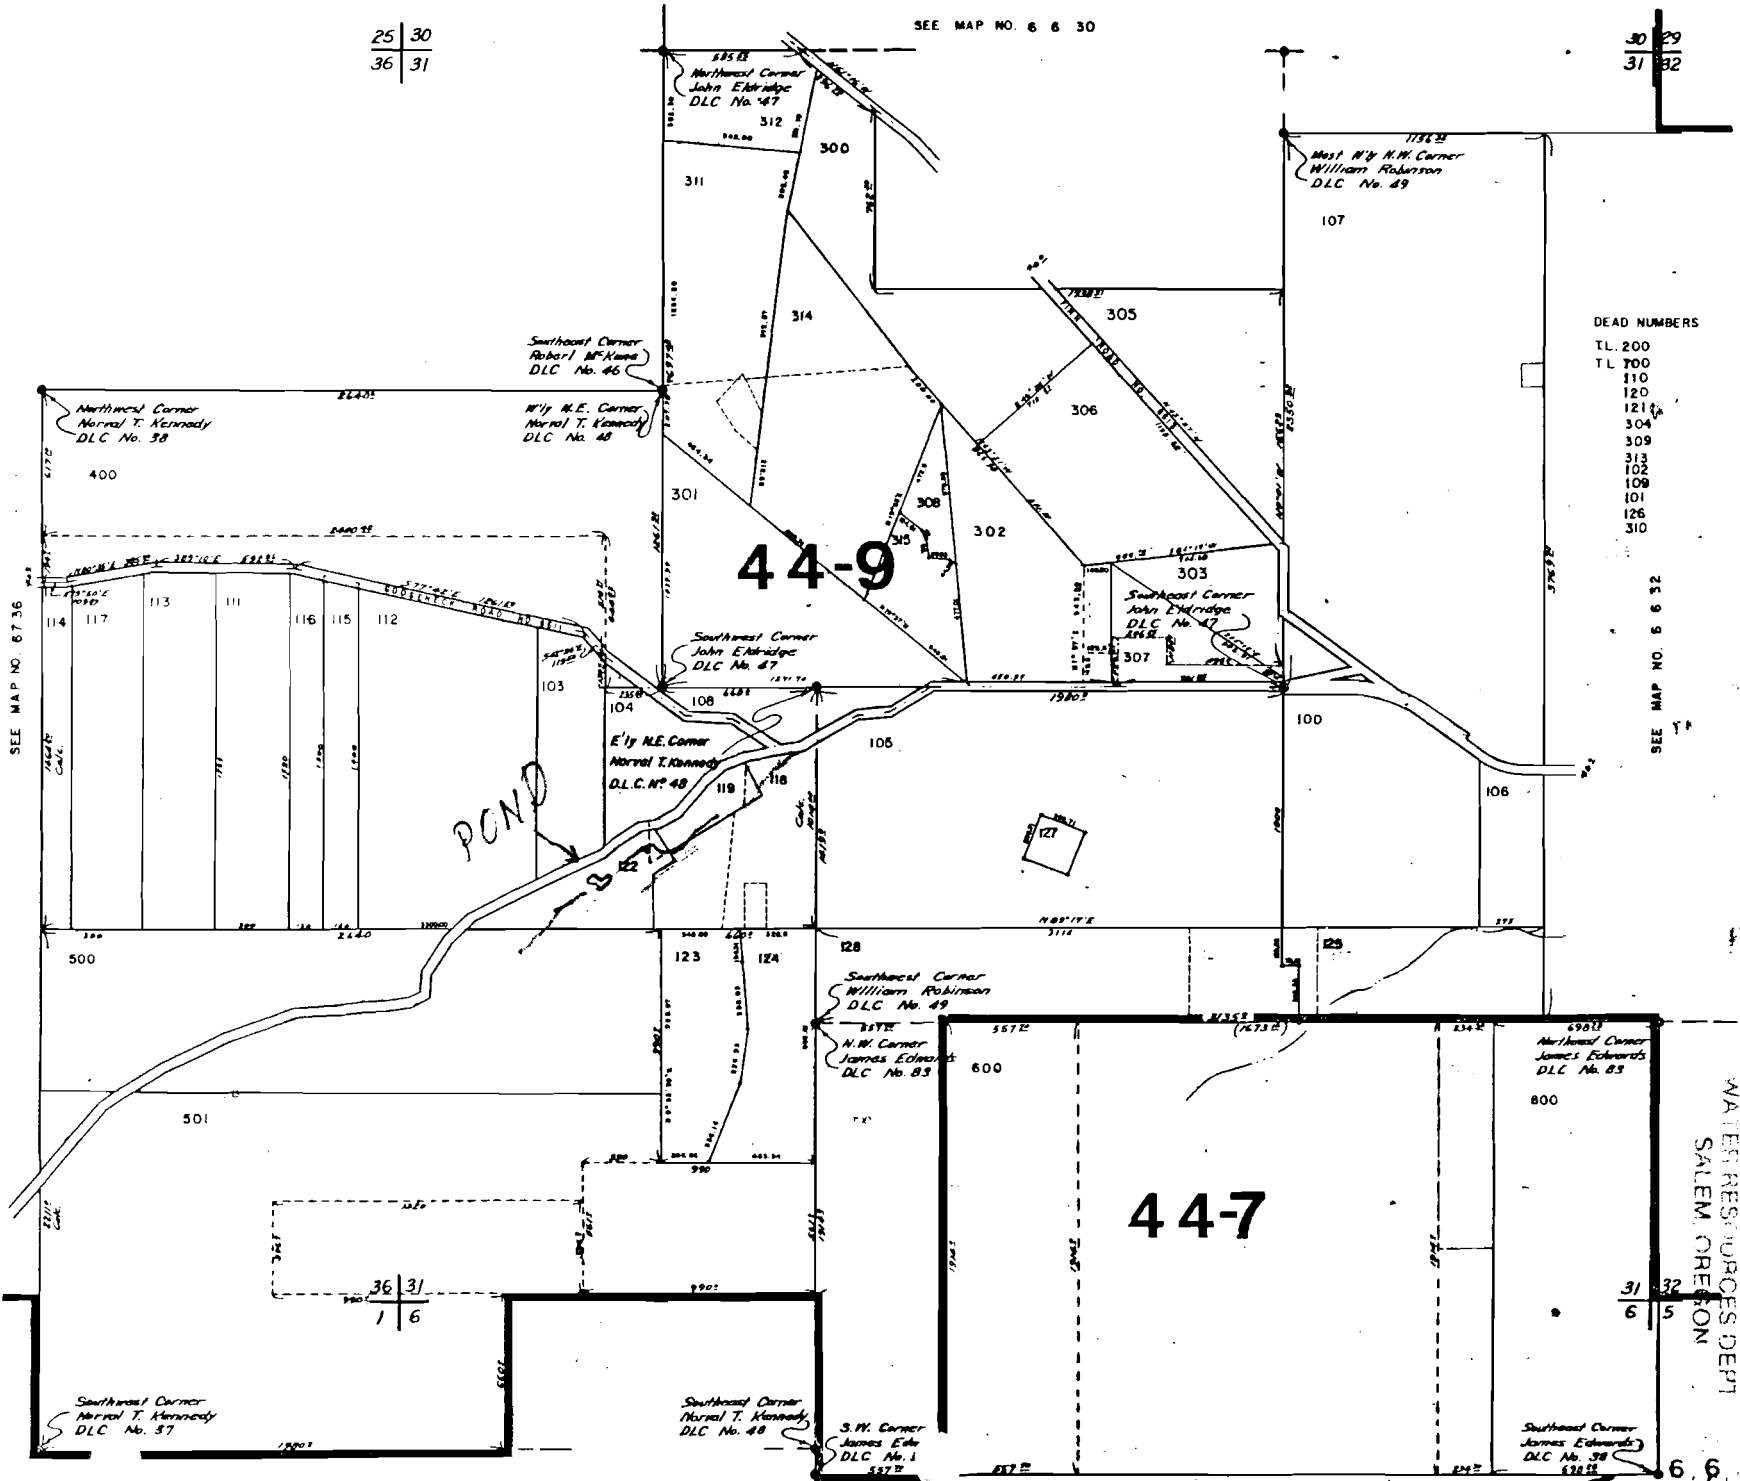

69862

DEC 27 1994

RECEIVED

6 9