


1"-400'

Application No *R-75888*
Permit No. .

SEE MAP 23 4 28

"CERTIFICATE NO. 69879

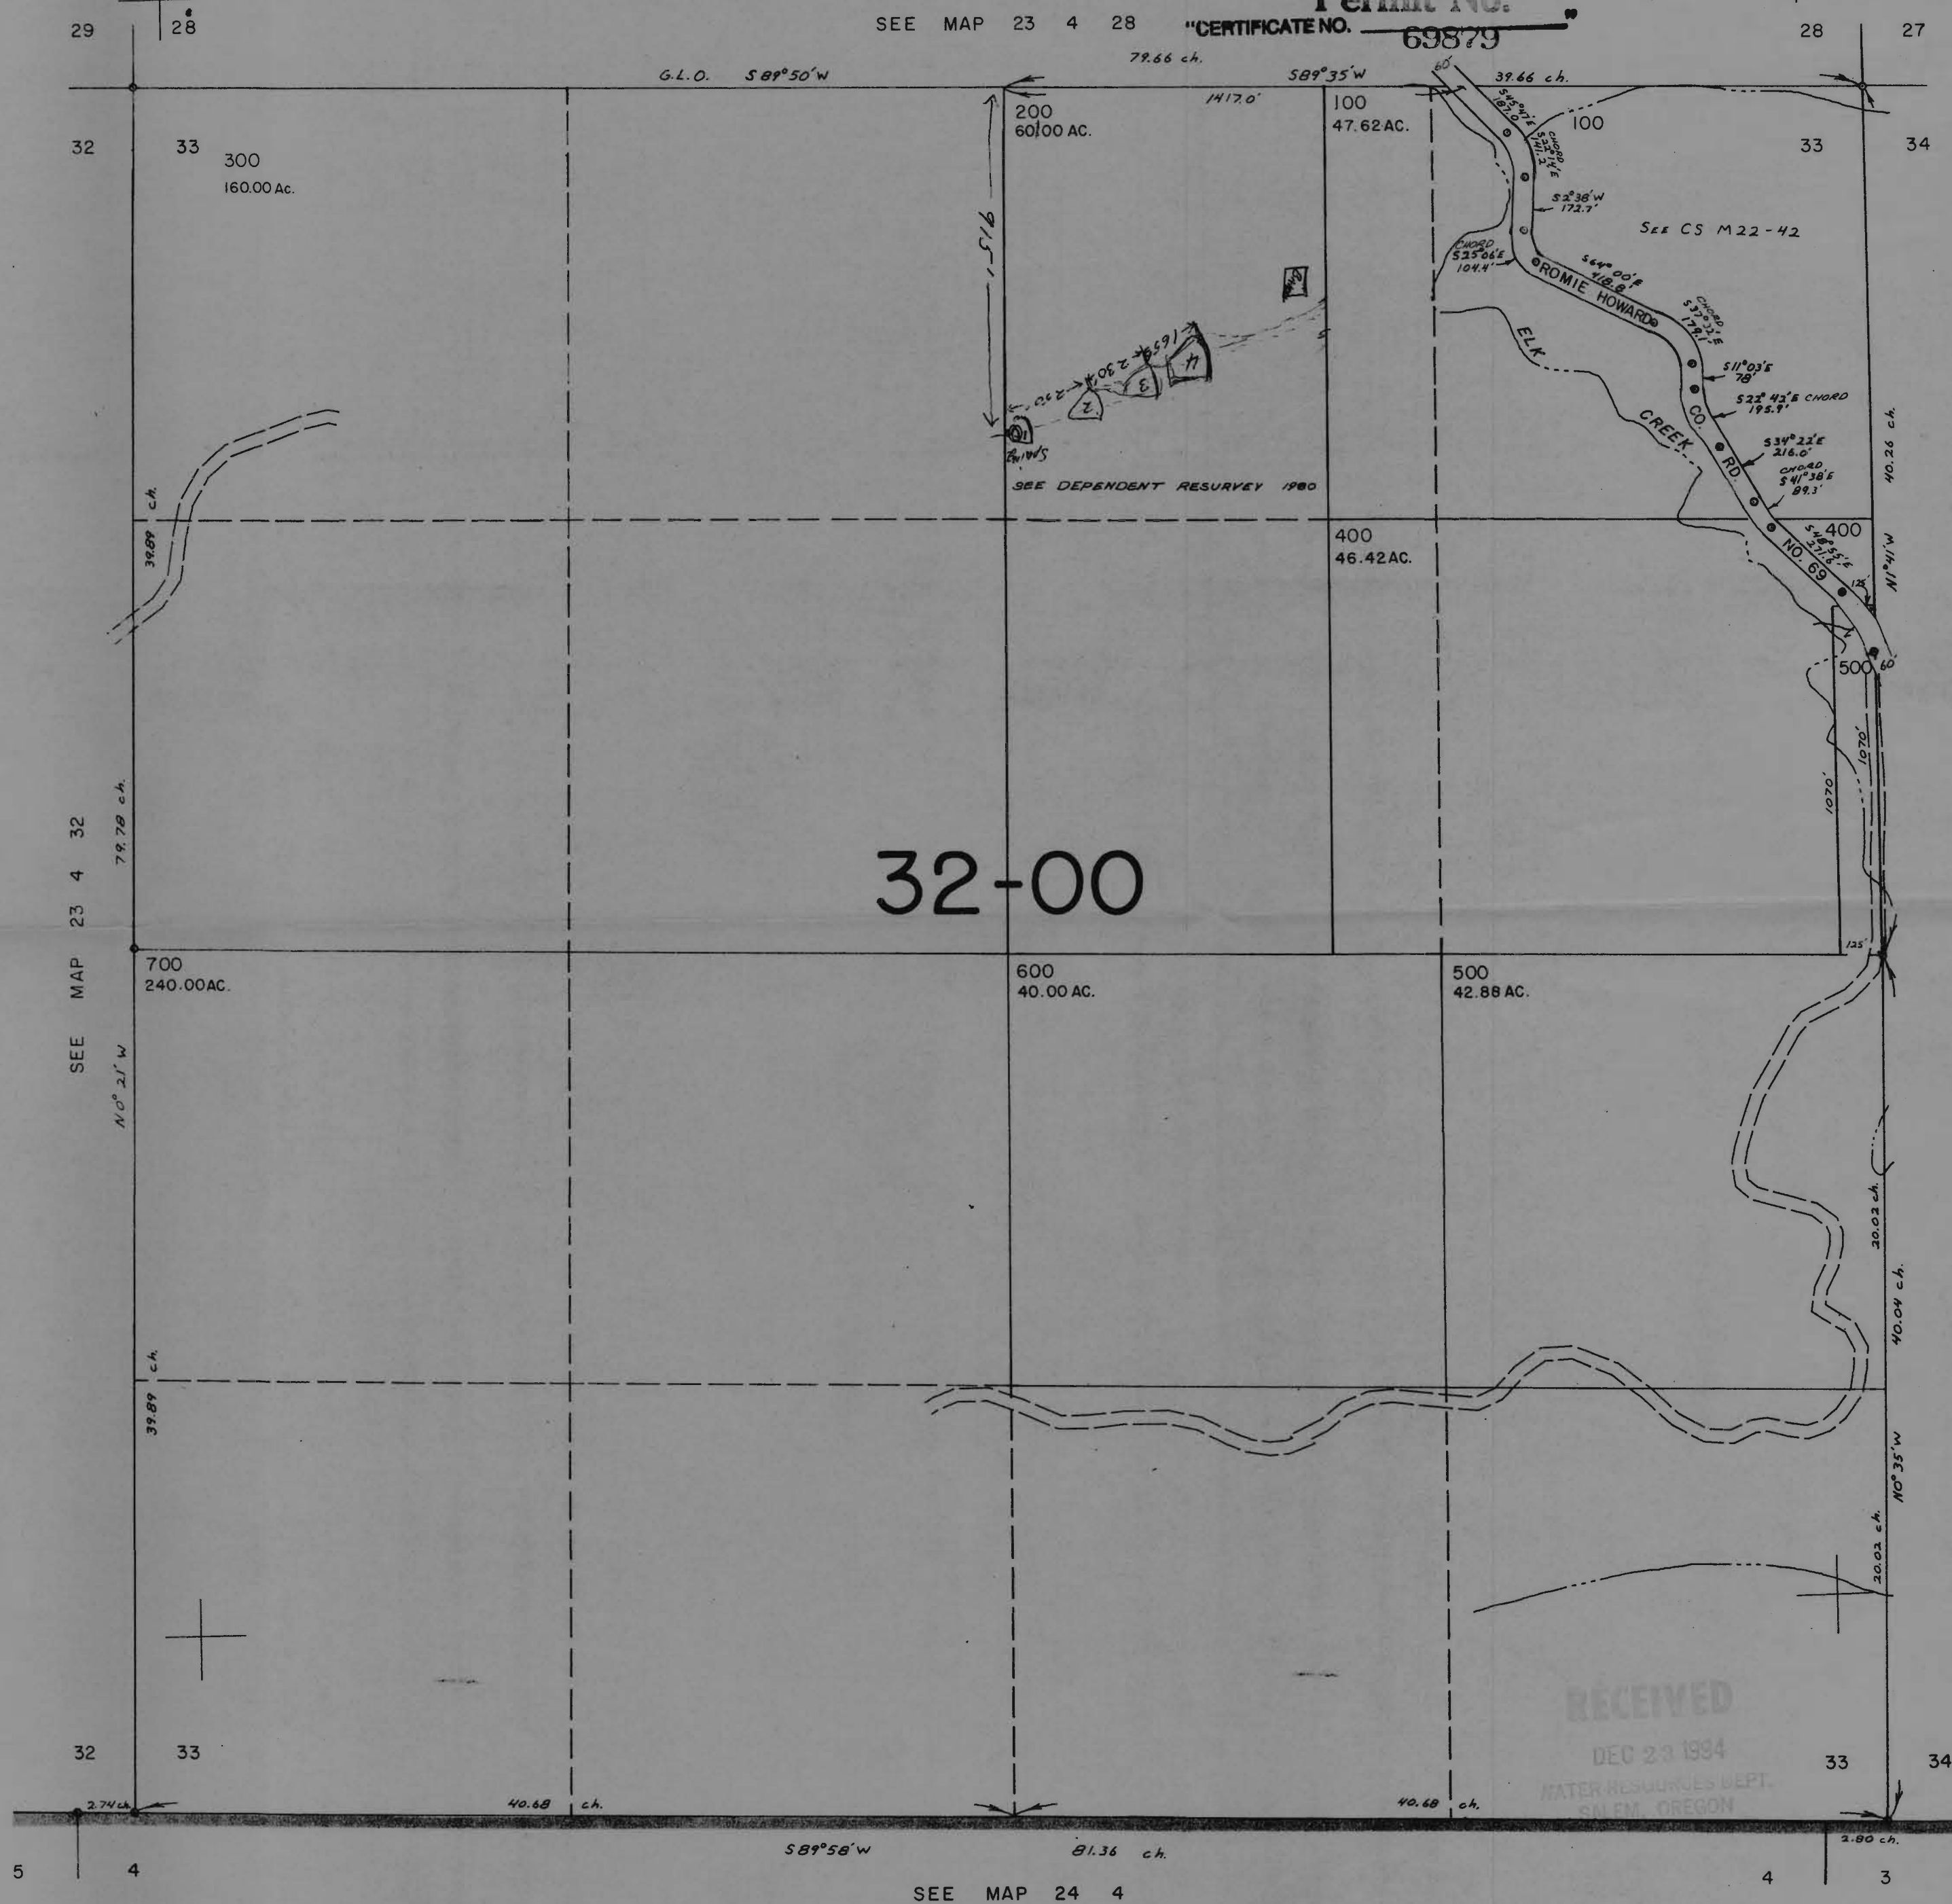

687,00

1,293,000