


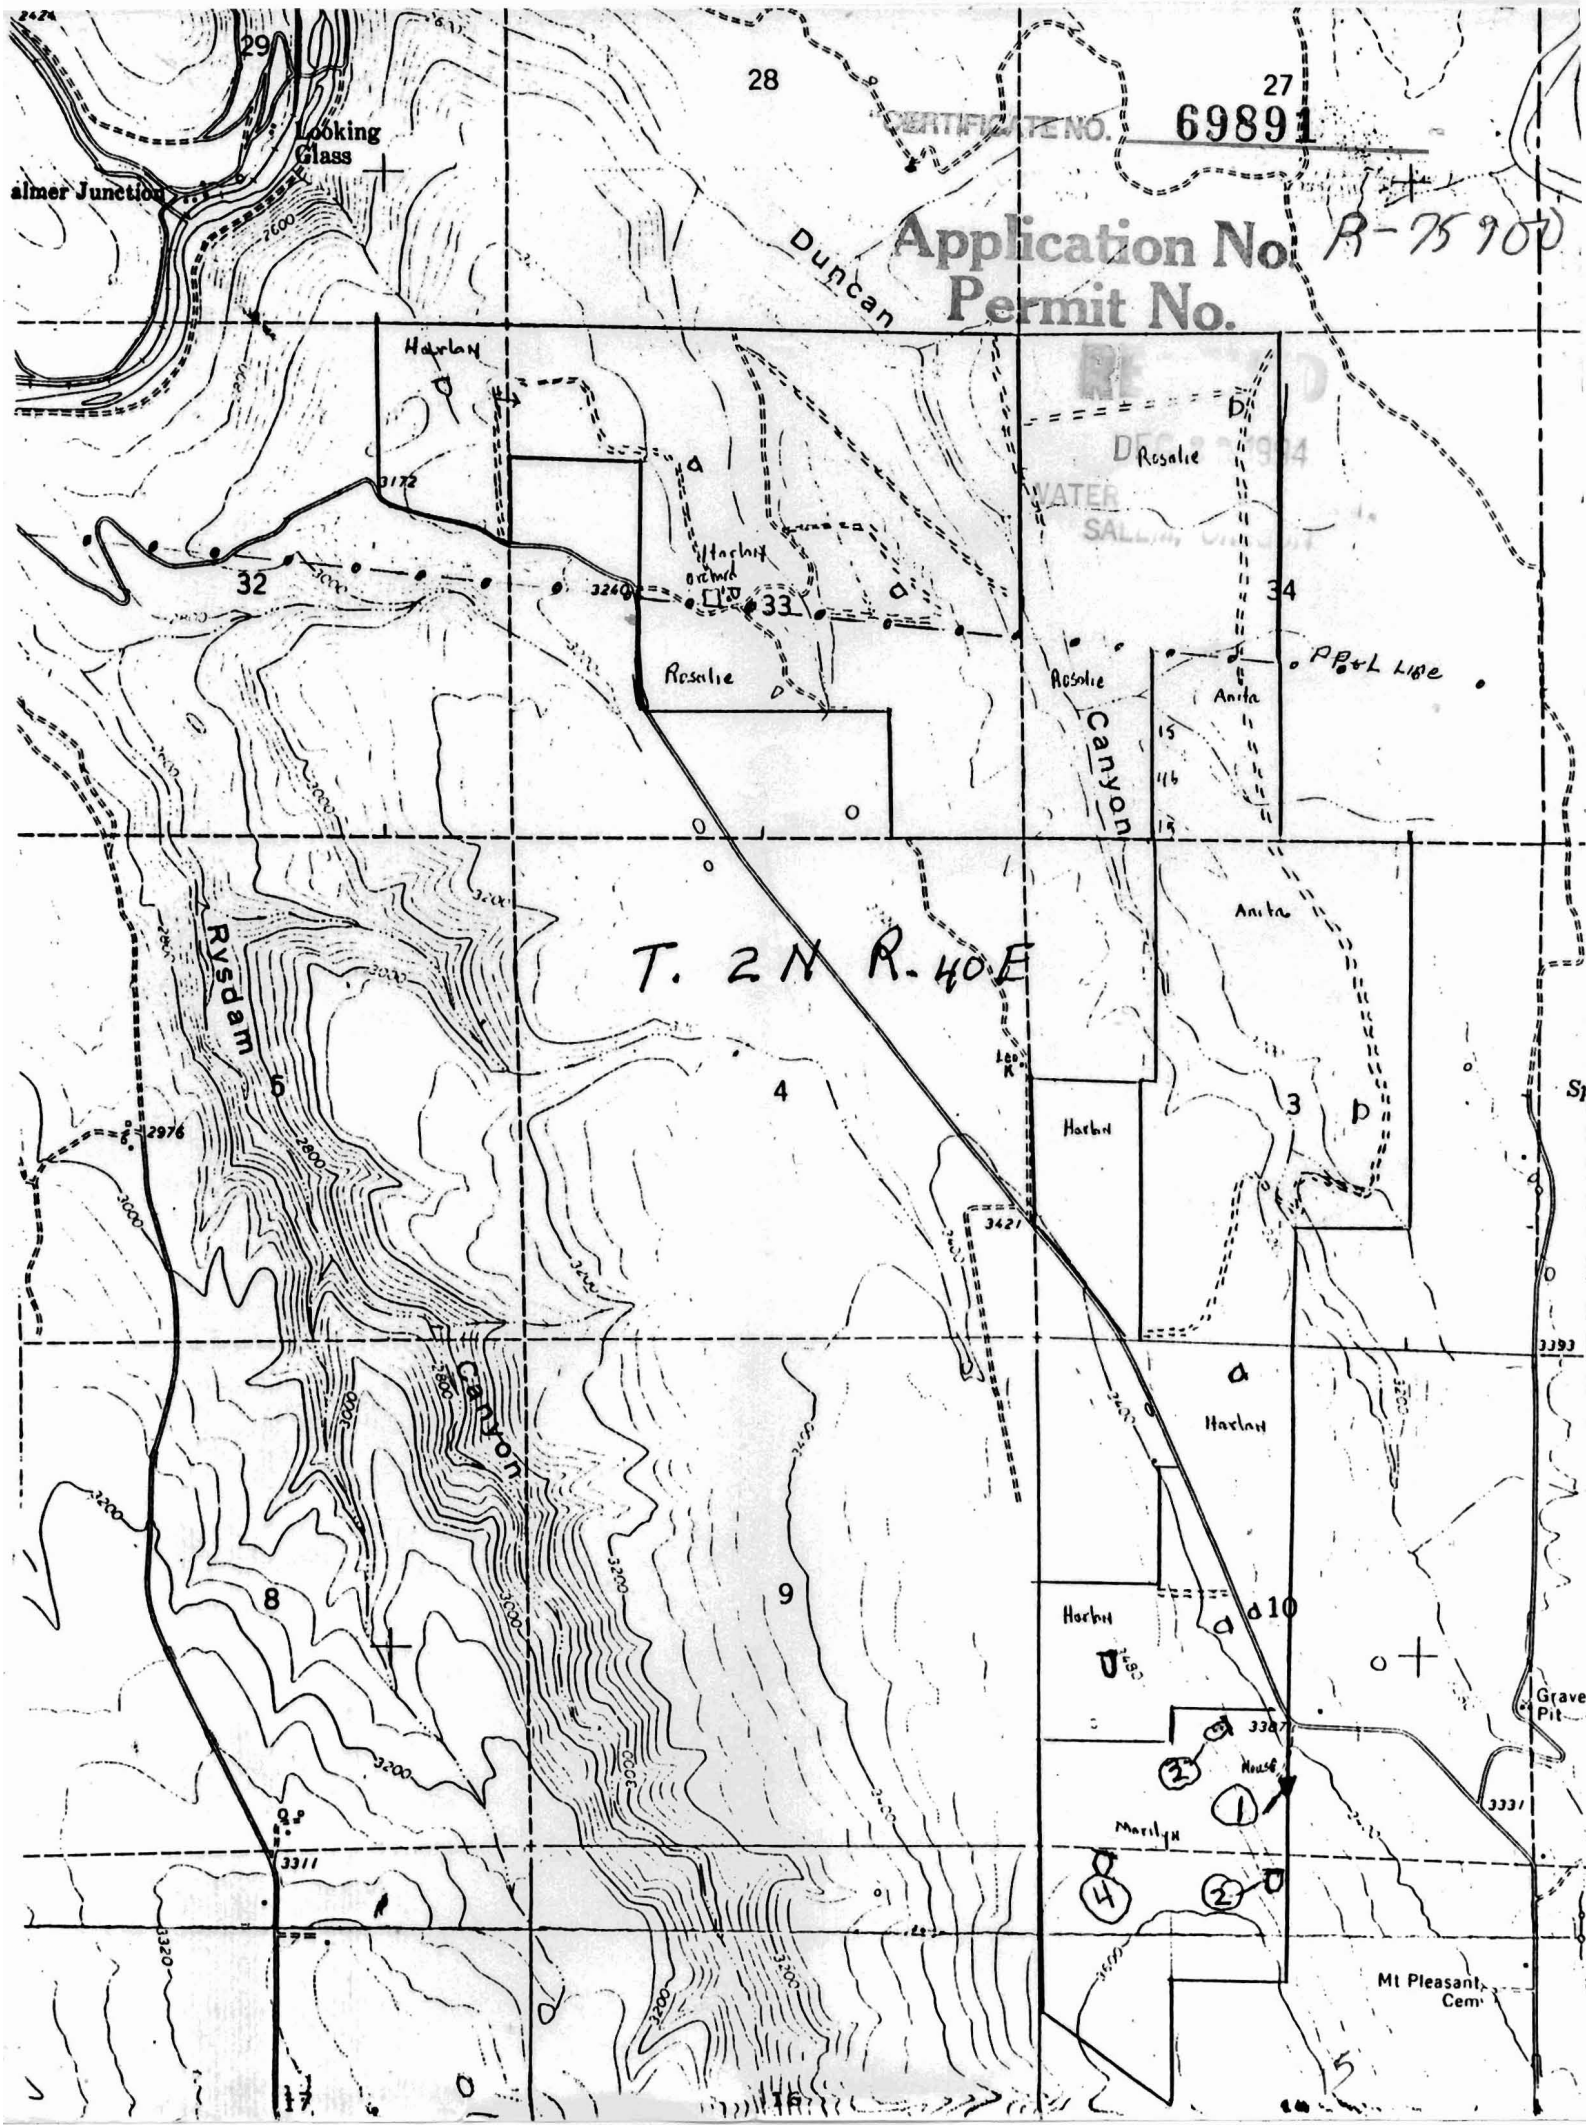

69891

Application No R-75900
Permit No.

T. 2 N R. 40 E

Looking Glass
almer Junction

Rysdam

Duncan

Rosalie

Canyon

Anita

Harlan

Harlan

Harlan

Marilyn

House

Mt Pleasant Cem

Grave Pit