


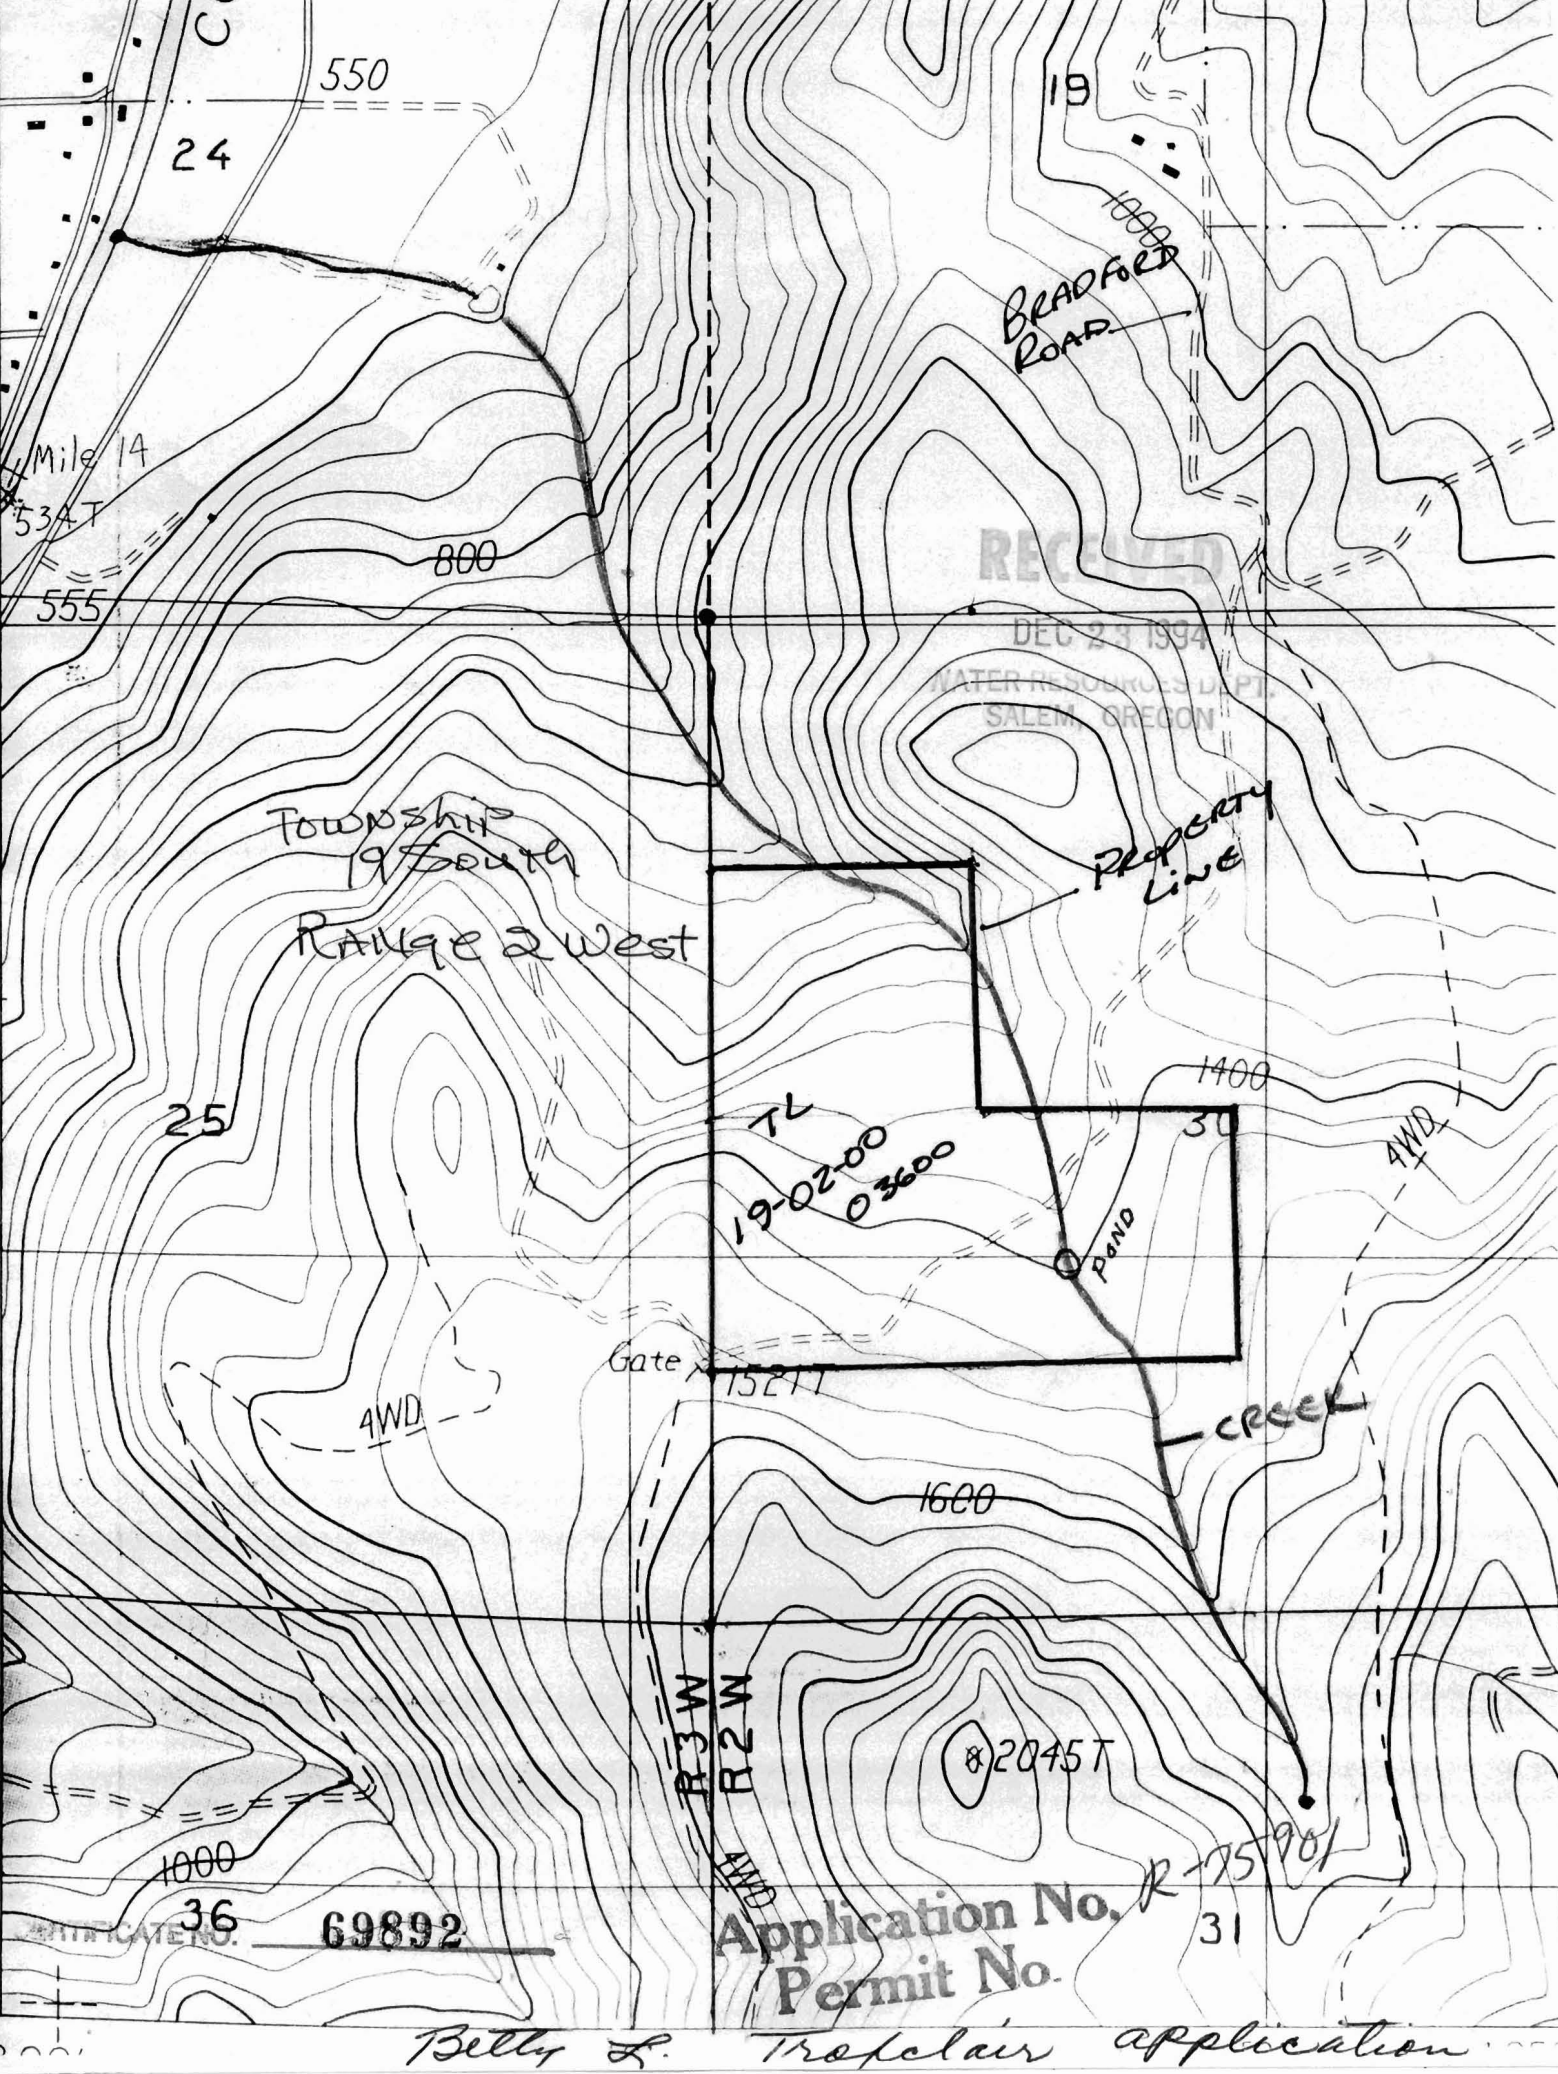

550
24
Mile 14
534T
555
800

BRADFORD ROAD

RECEIVED

DEC 29 1994

WATER RESOURCES DEPT.
SALEM, OREGON

TOWNSHIP 19 South
Range 2 West

Property Line

25

TL
19-02-00
03600

1400

30

POND

Gate

15211

4WD

4WD

CREEK

1600

R3W
R2W

82045T

R-75901

31

Application No.
Permit No.

69892
36

Betty L. Troclair application