


LANE COUNTY


1" = 200'

LINN COUNTY

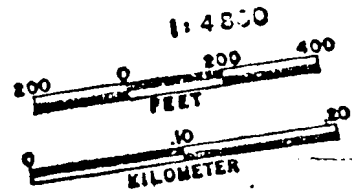

69894

SEE MAP 16-02-10-2

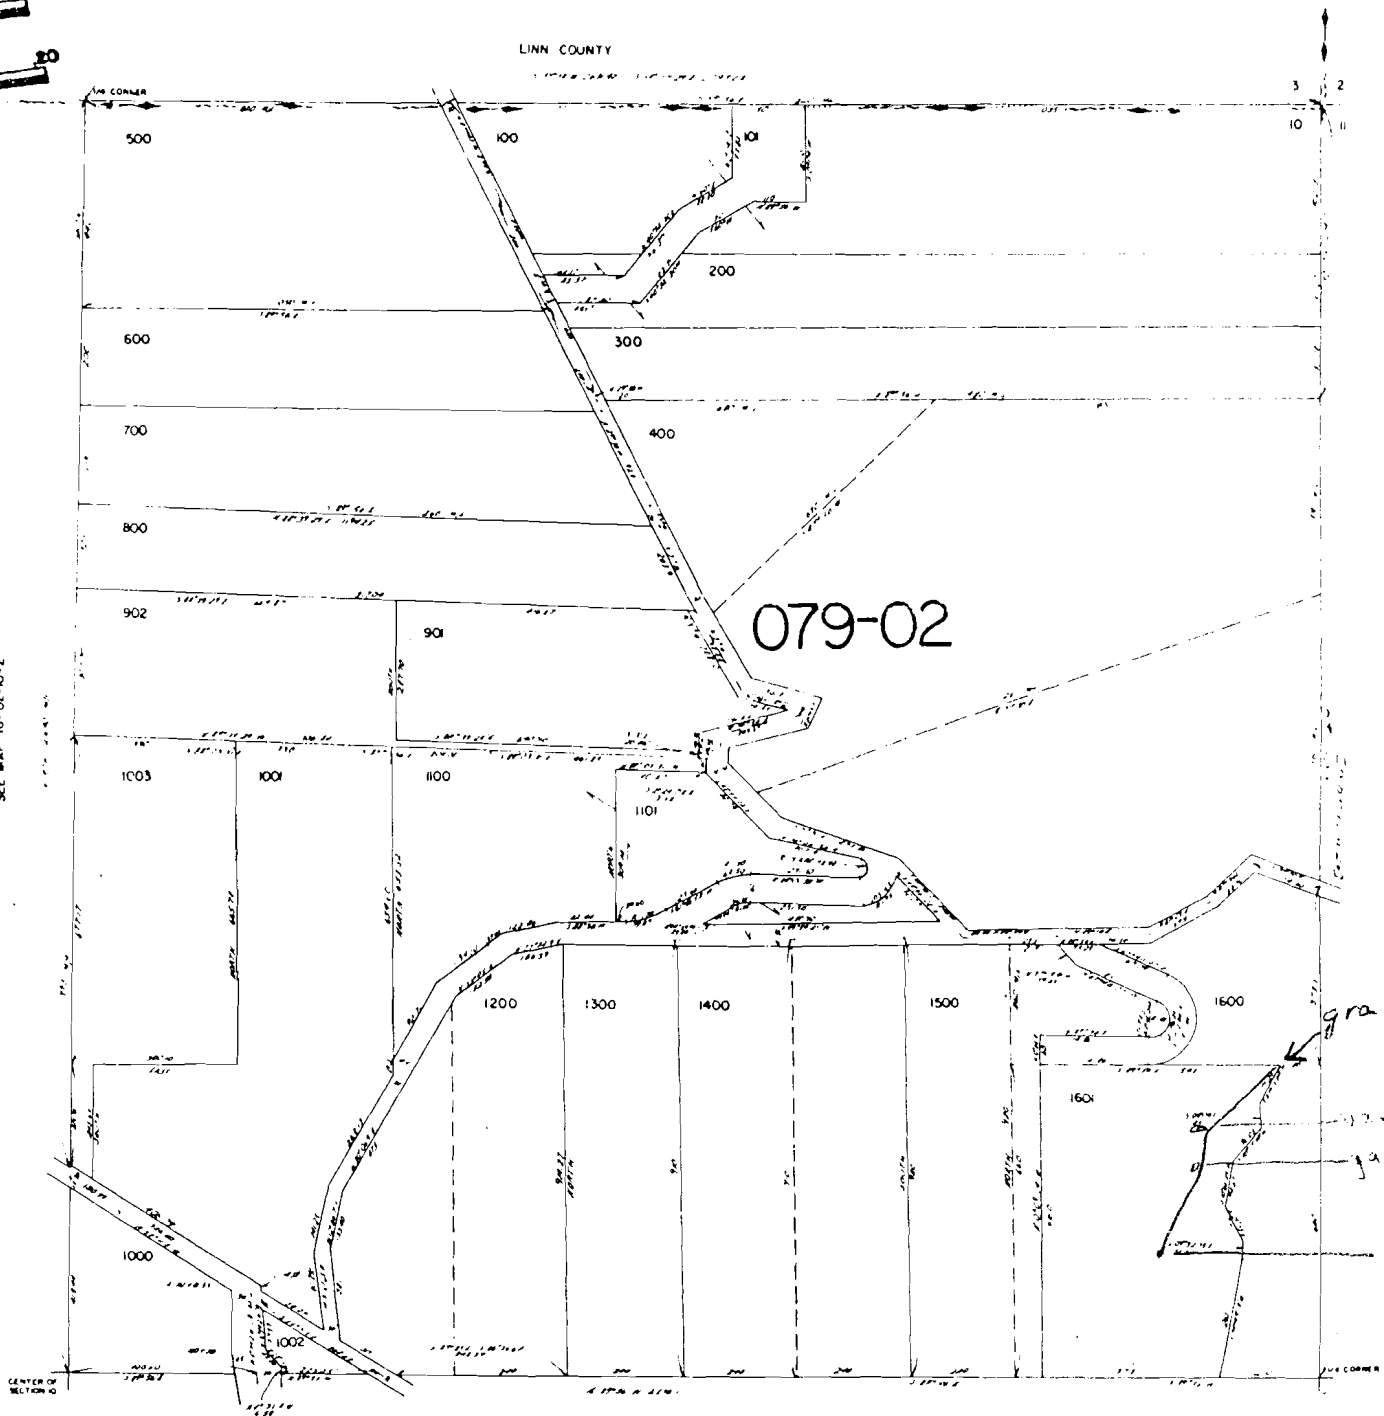

SEE MAP 16-02-11-2

gravity flow pipe
wood flour
garden
ponds