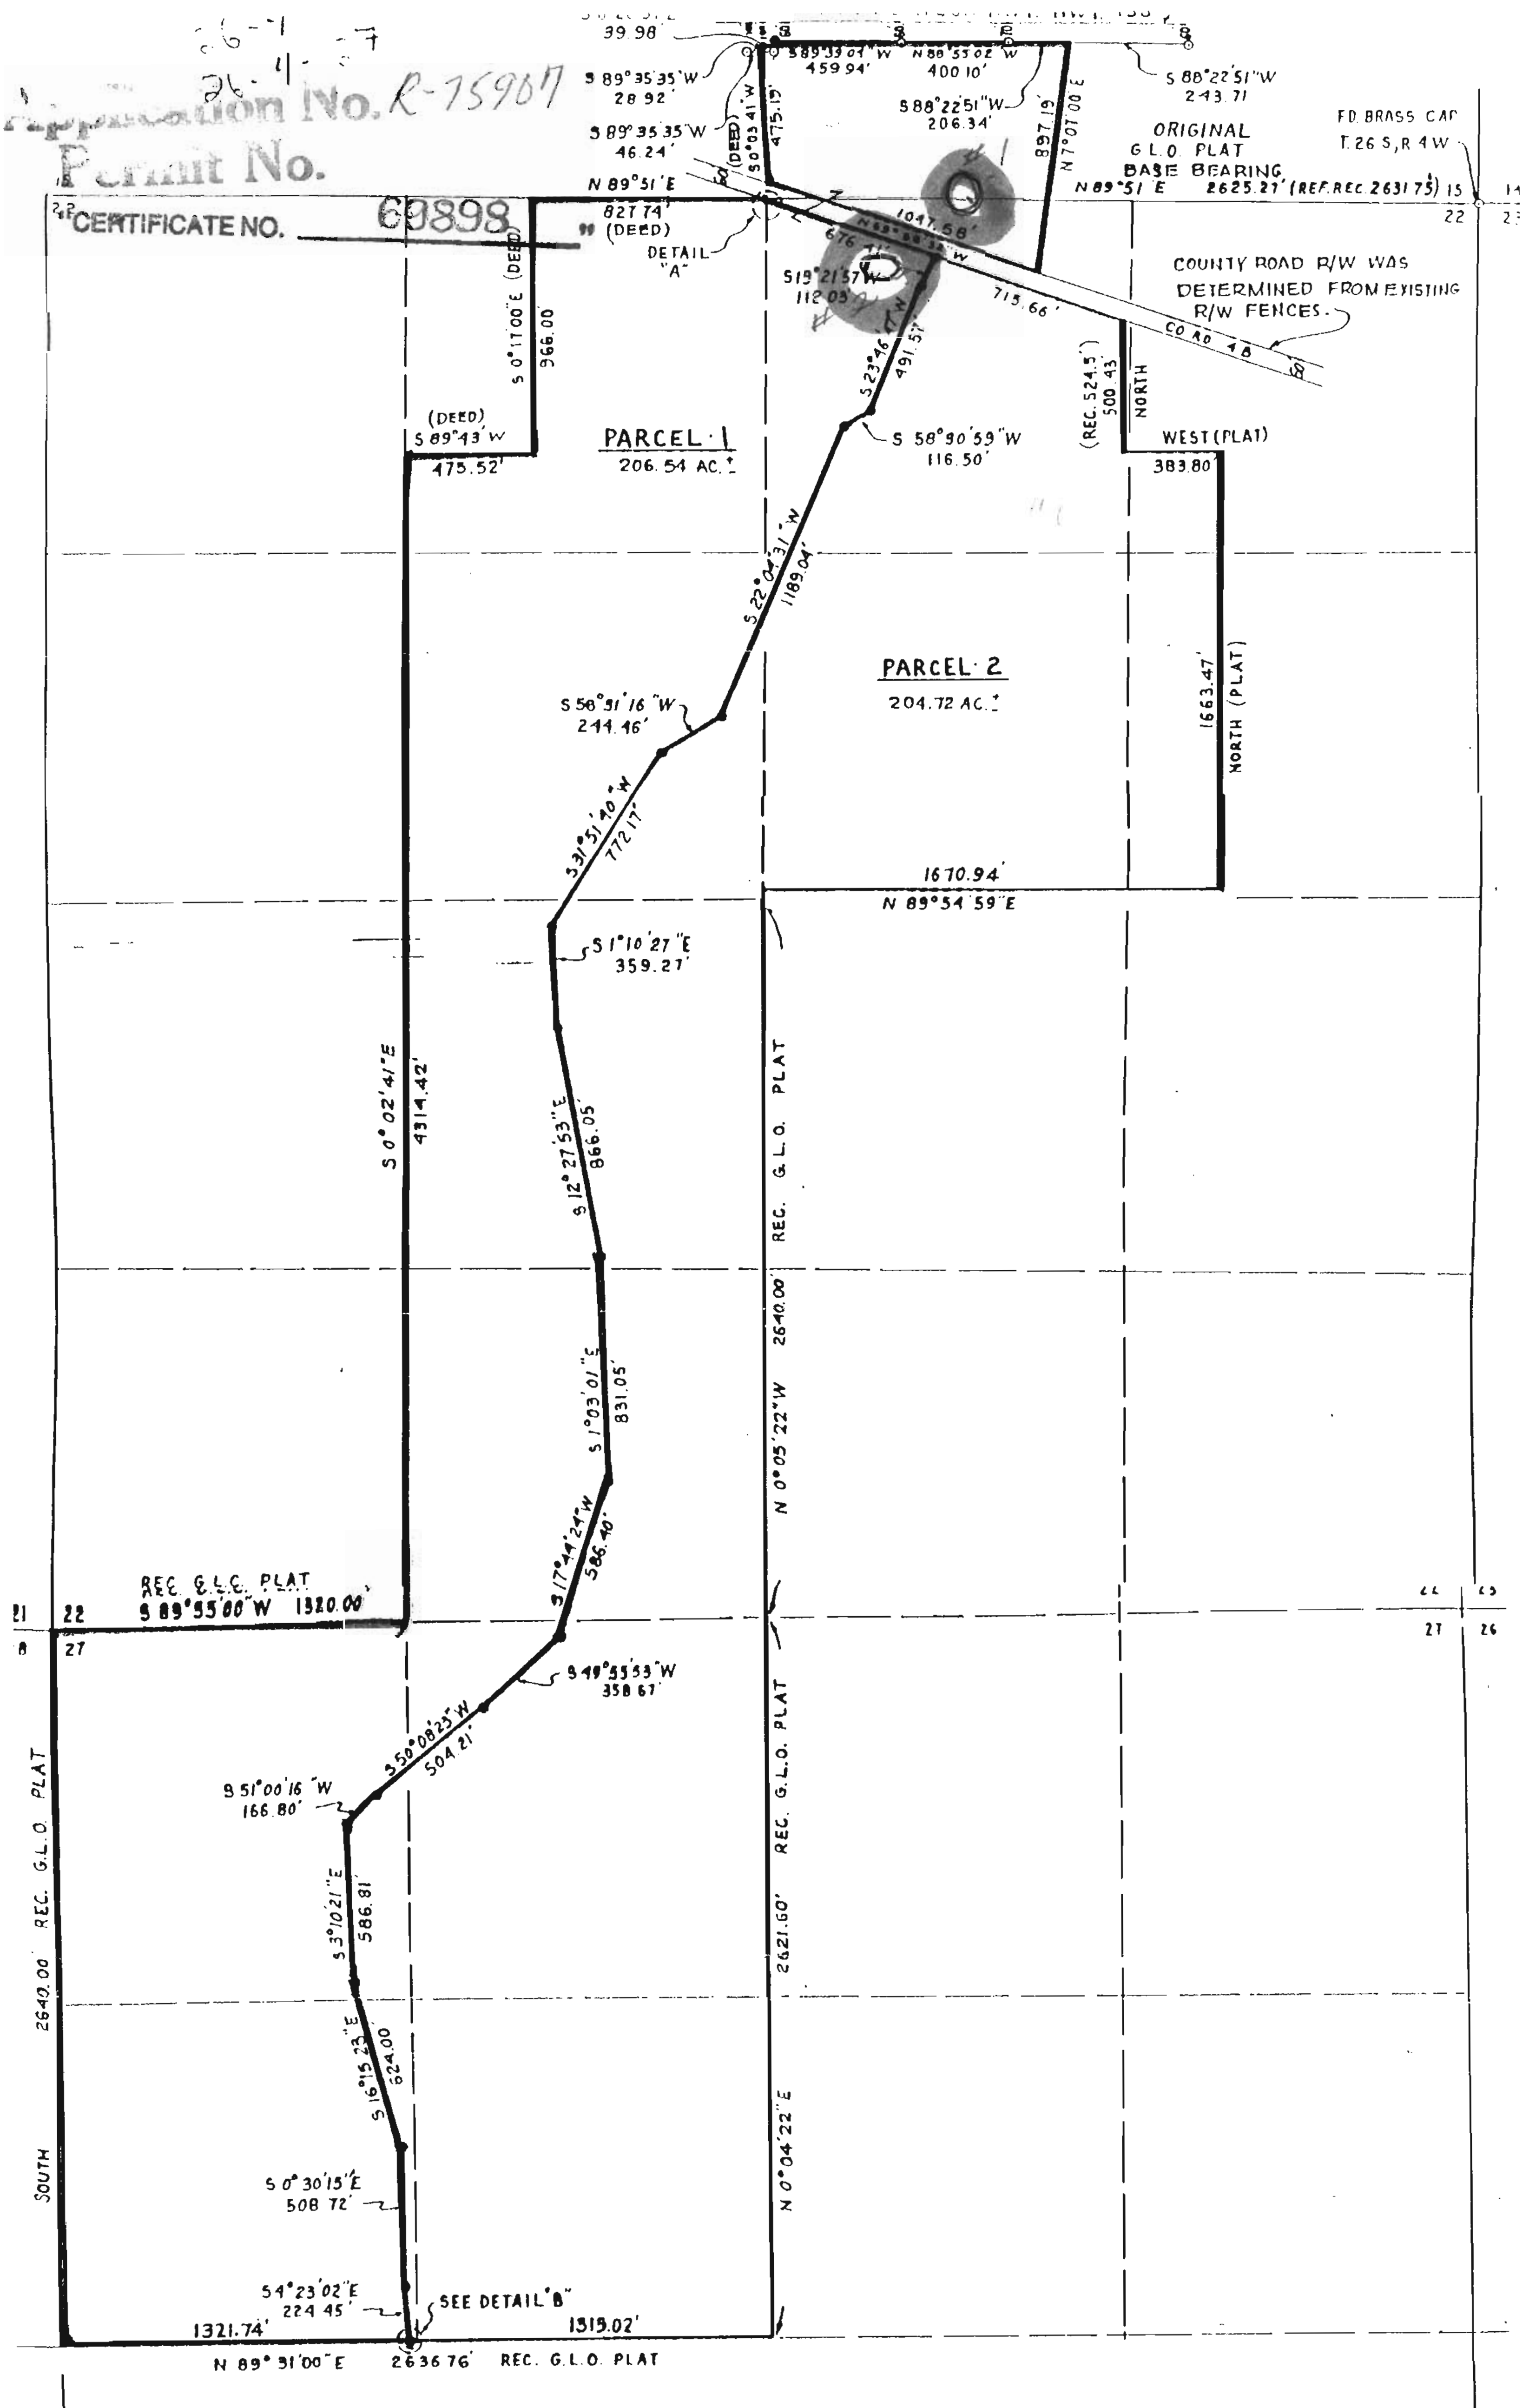Application No. R-15907
Permit No.
CERTIFICATE NO. 69898