

SECTION 18 T41S R21E.W.M.
LAKE COUNTY


41 21 18

69899


1"=400'

100 100 100

SCALE 1:9600

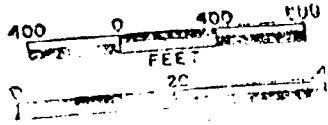

SEE MAP 41 21

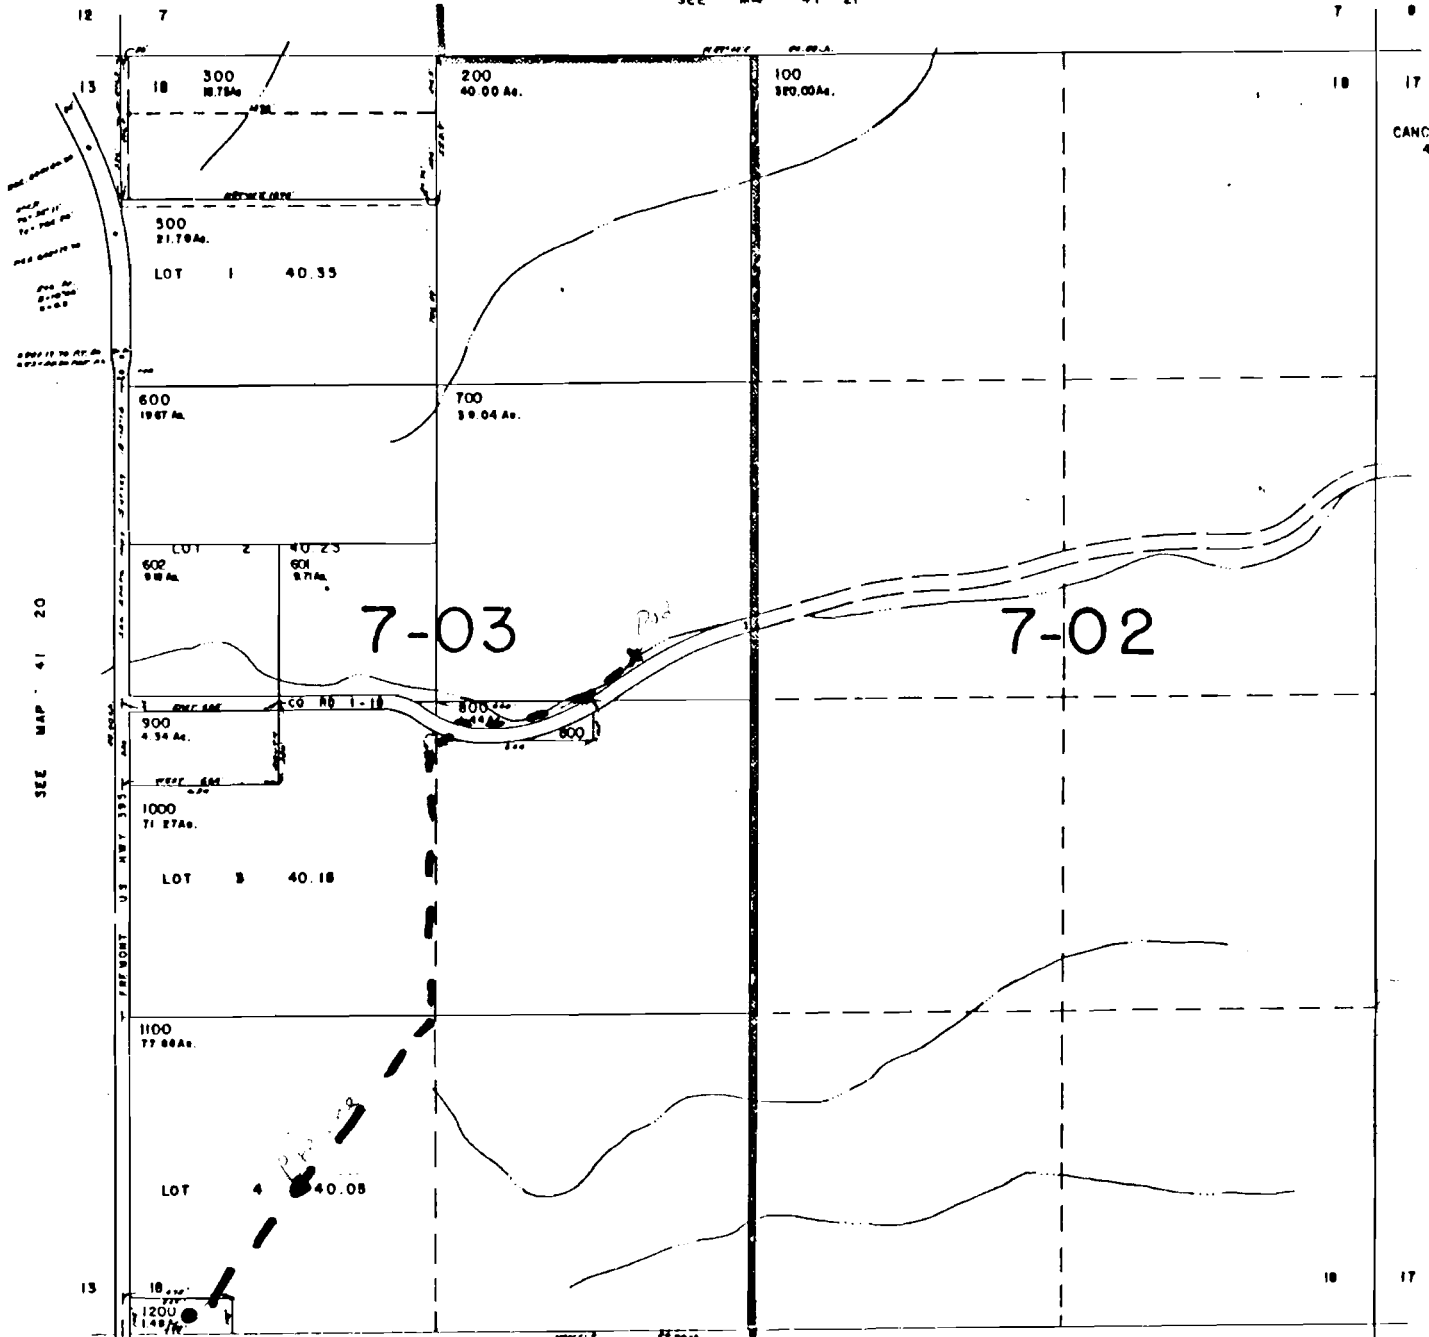

CANCELLED NO'S
400

SEE MAP 41 21