


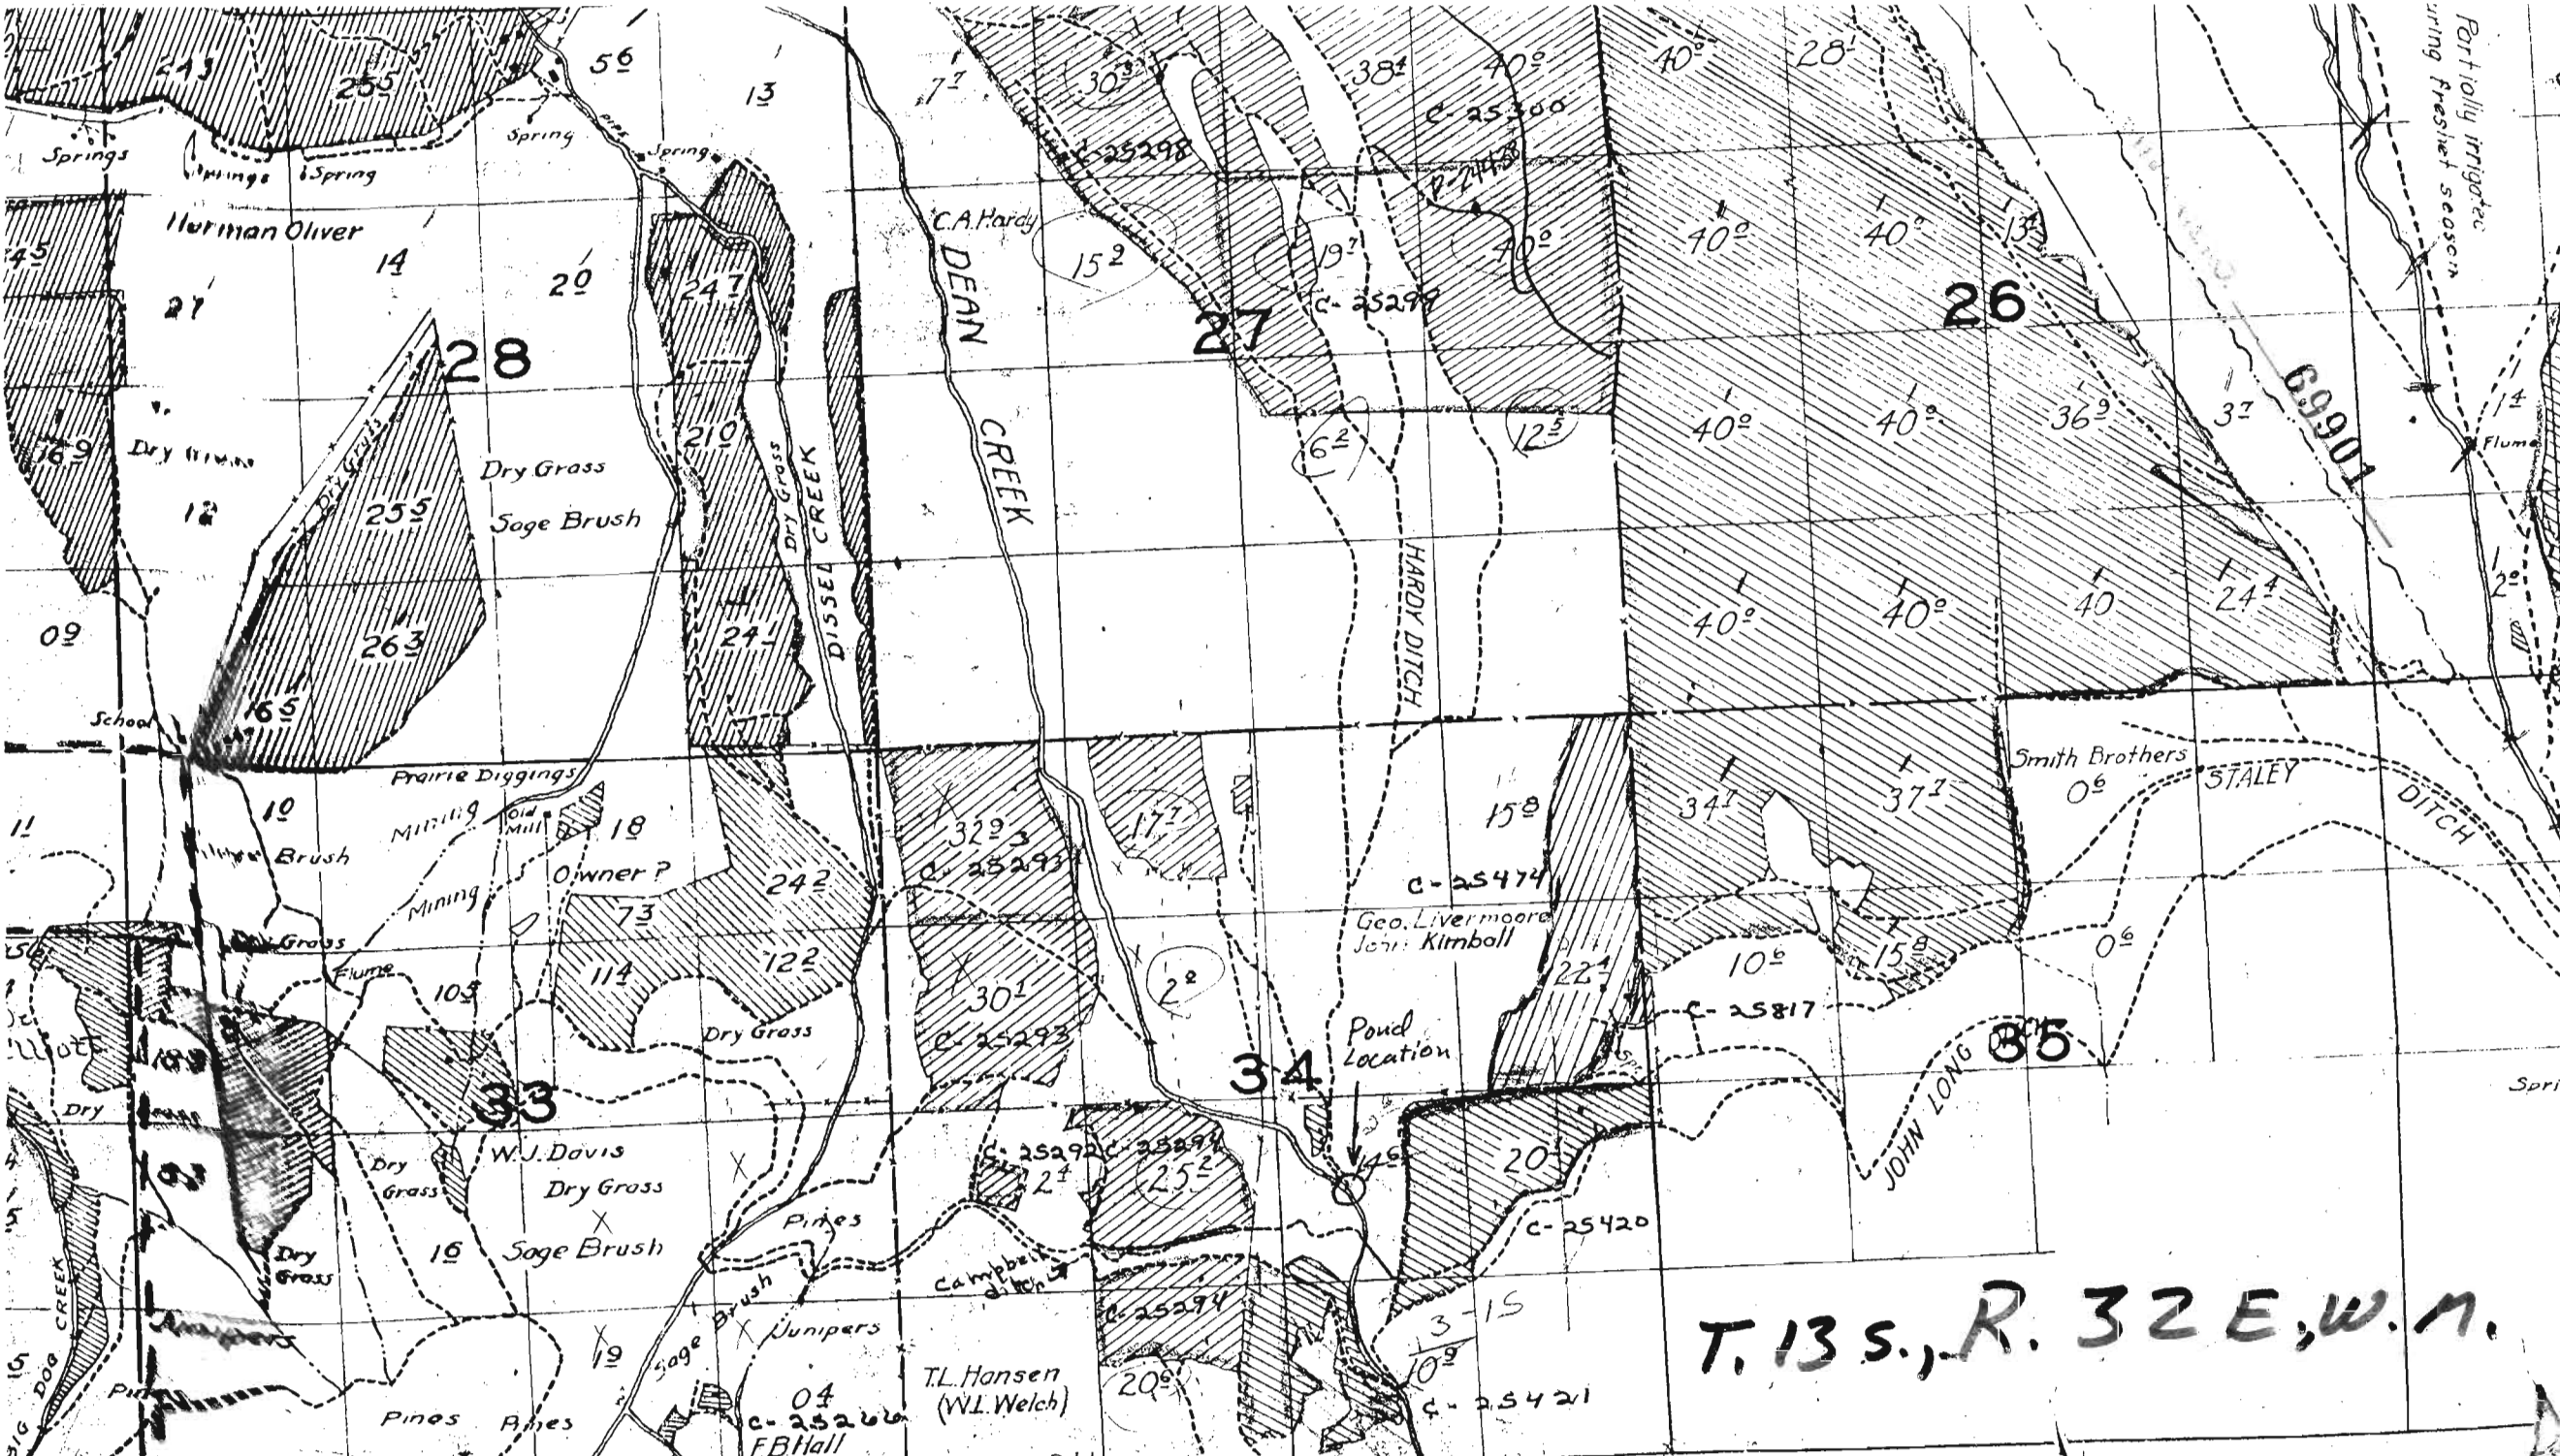

T. 13 S., R. 32 E., W. 11.