


1"-400"

Application No. R-75913
Permit No.

"CERTIFICATE NO. 69904"

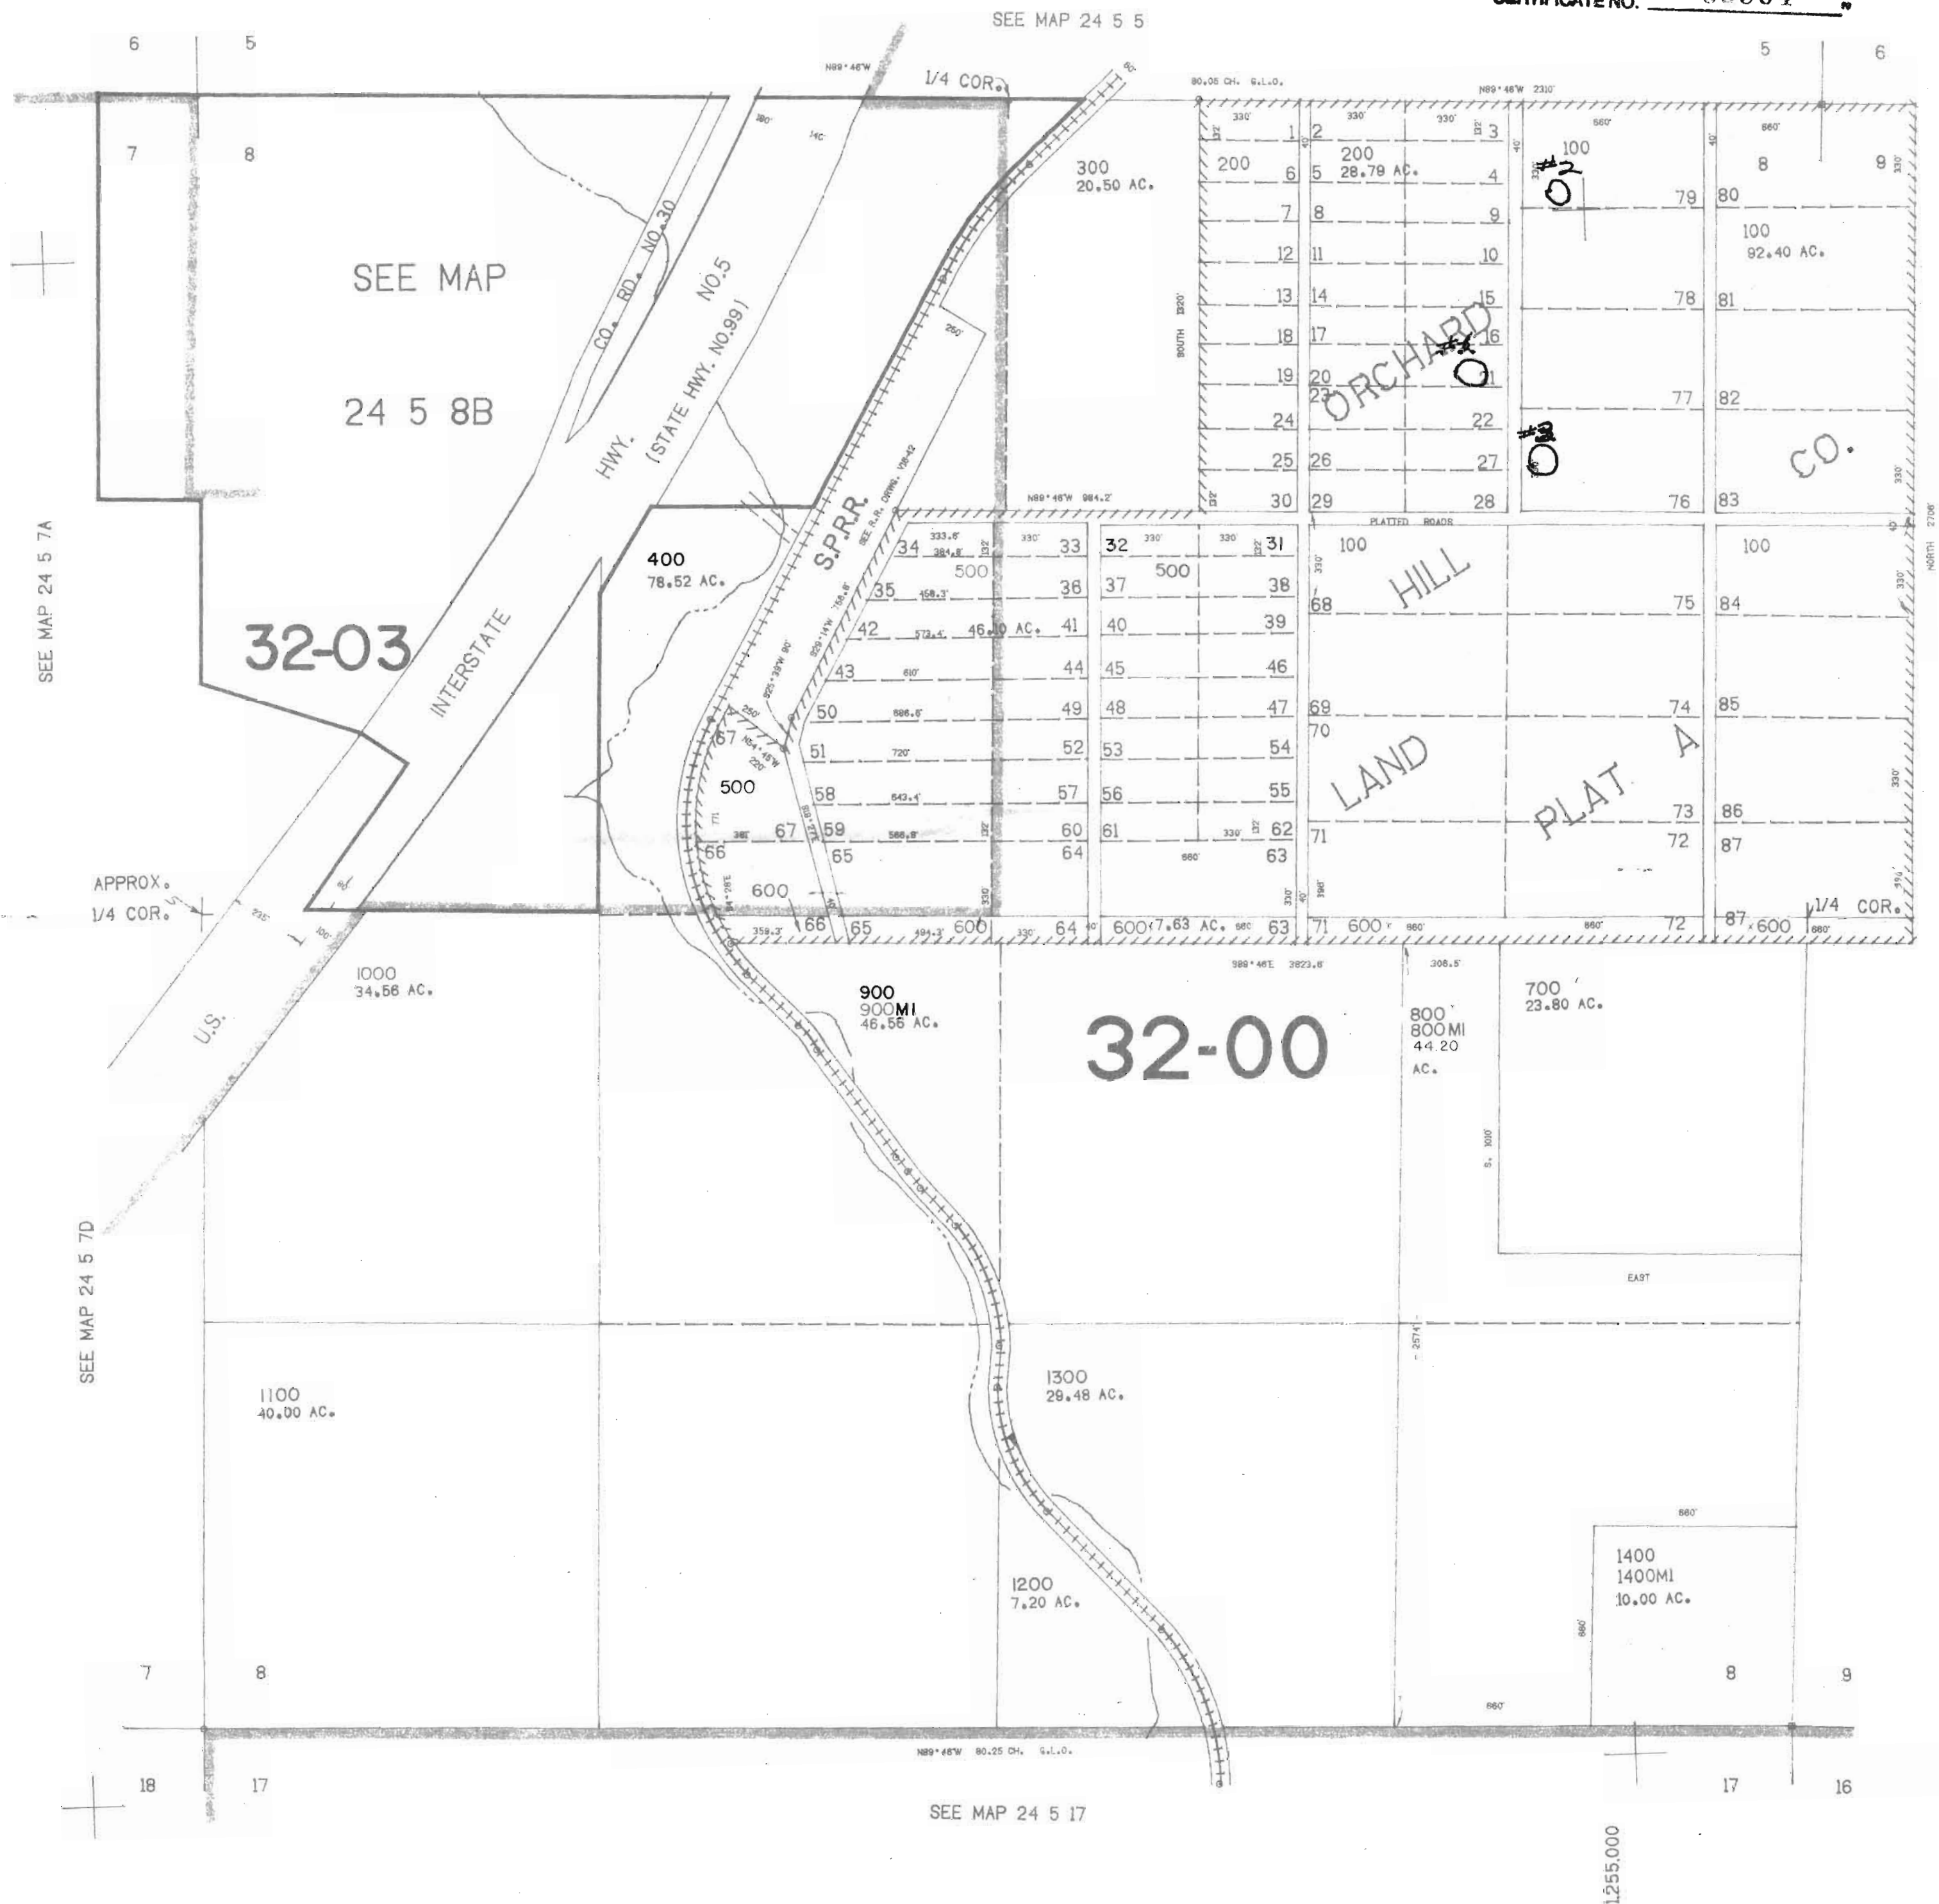

SEE MAP 24 5 9

677,000

24 5 8
& INDEX