


INTERIOR
DEPT

Township 1 South
Range 45 East

JOSEPH NW QUADRANGLE
OREGON-WALLOWA CO.
7.5 MINUTE SERIES (TOPOGRAPHIC)

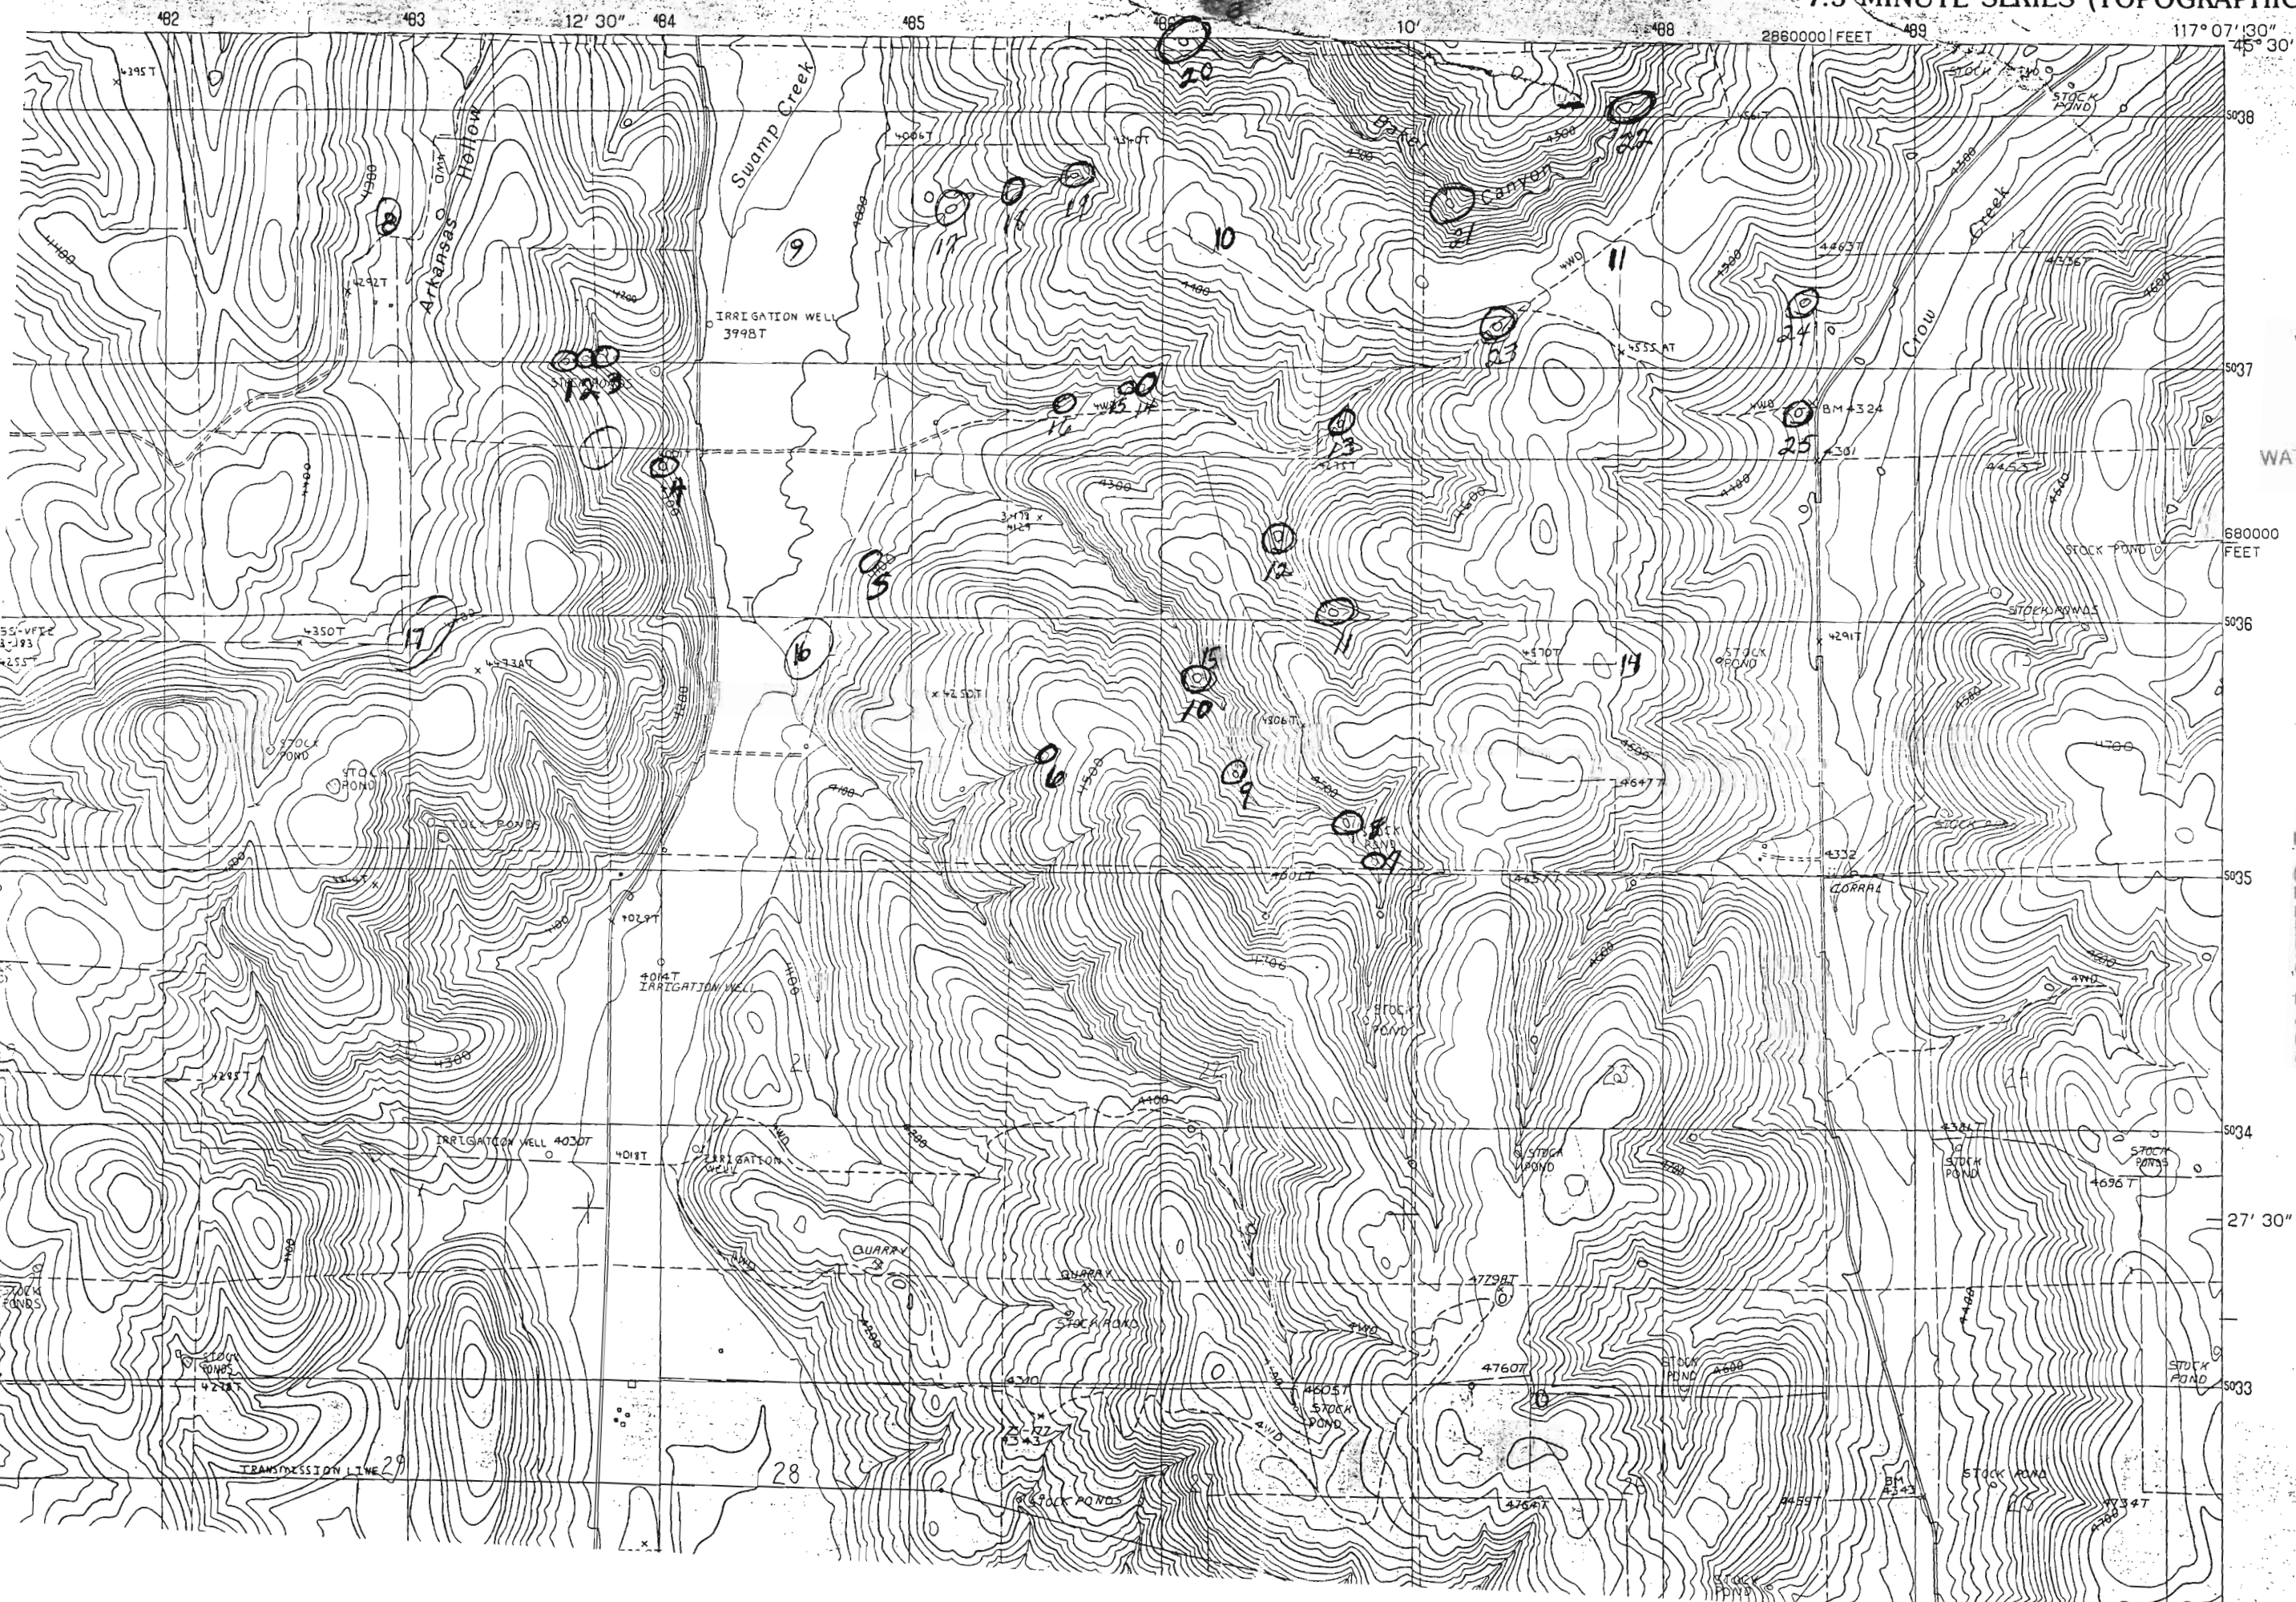

RECEIVED

NOV 16 1994

WATER RESOURCES DIVISION
SALEM, OREGON

DEC 2 1994

Application No. R-15-001
Permit No.

69912