


Application No. R-75924
Permit No. Johnson

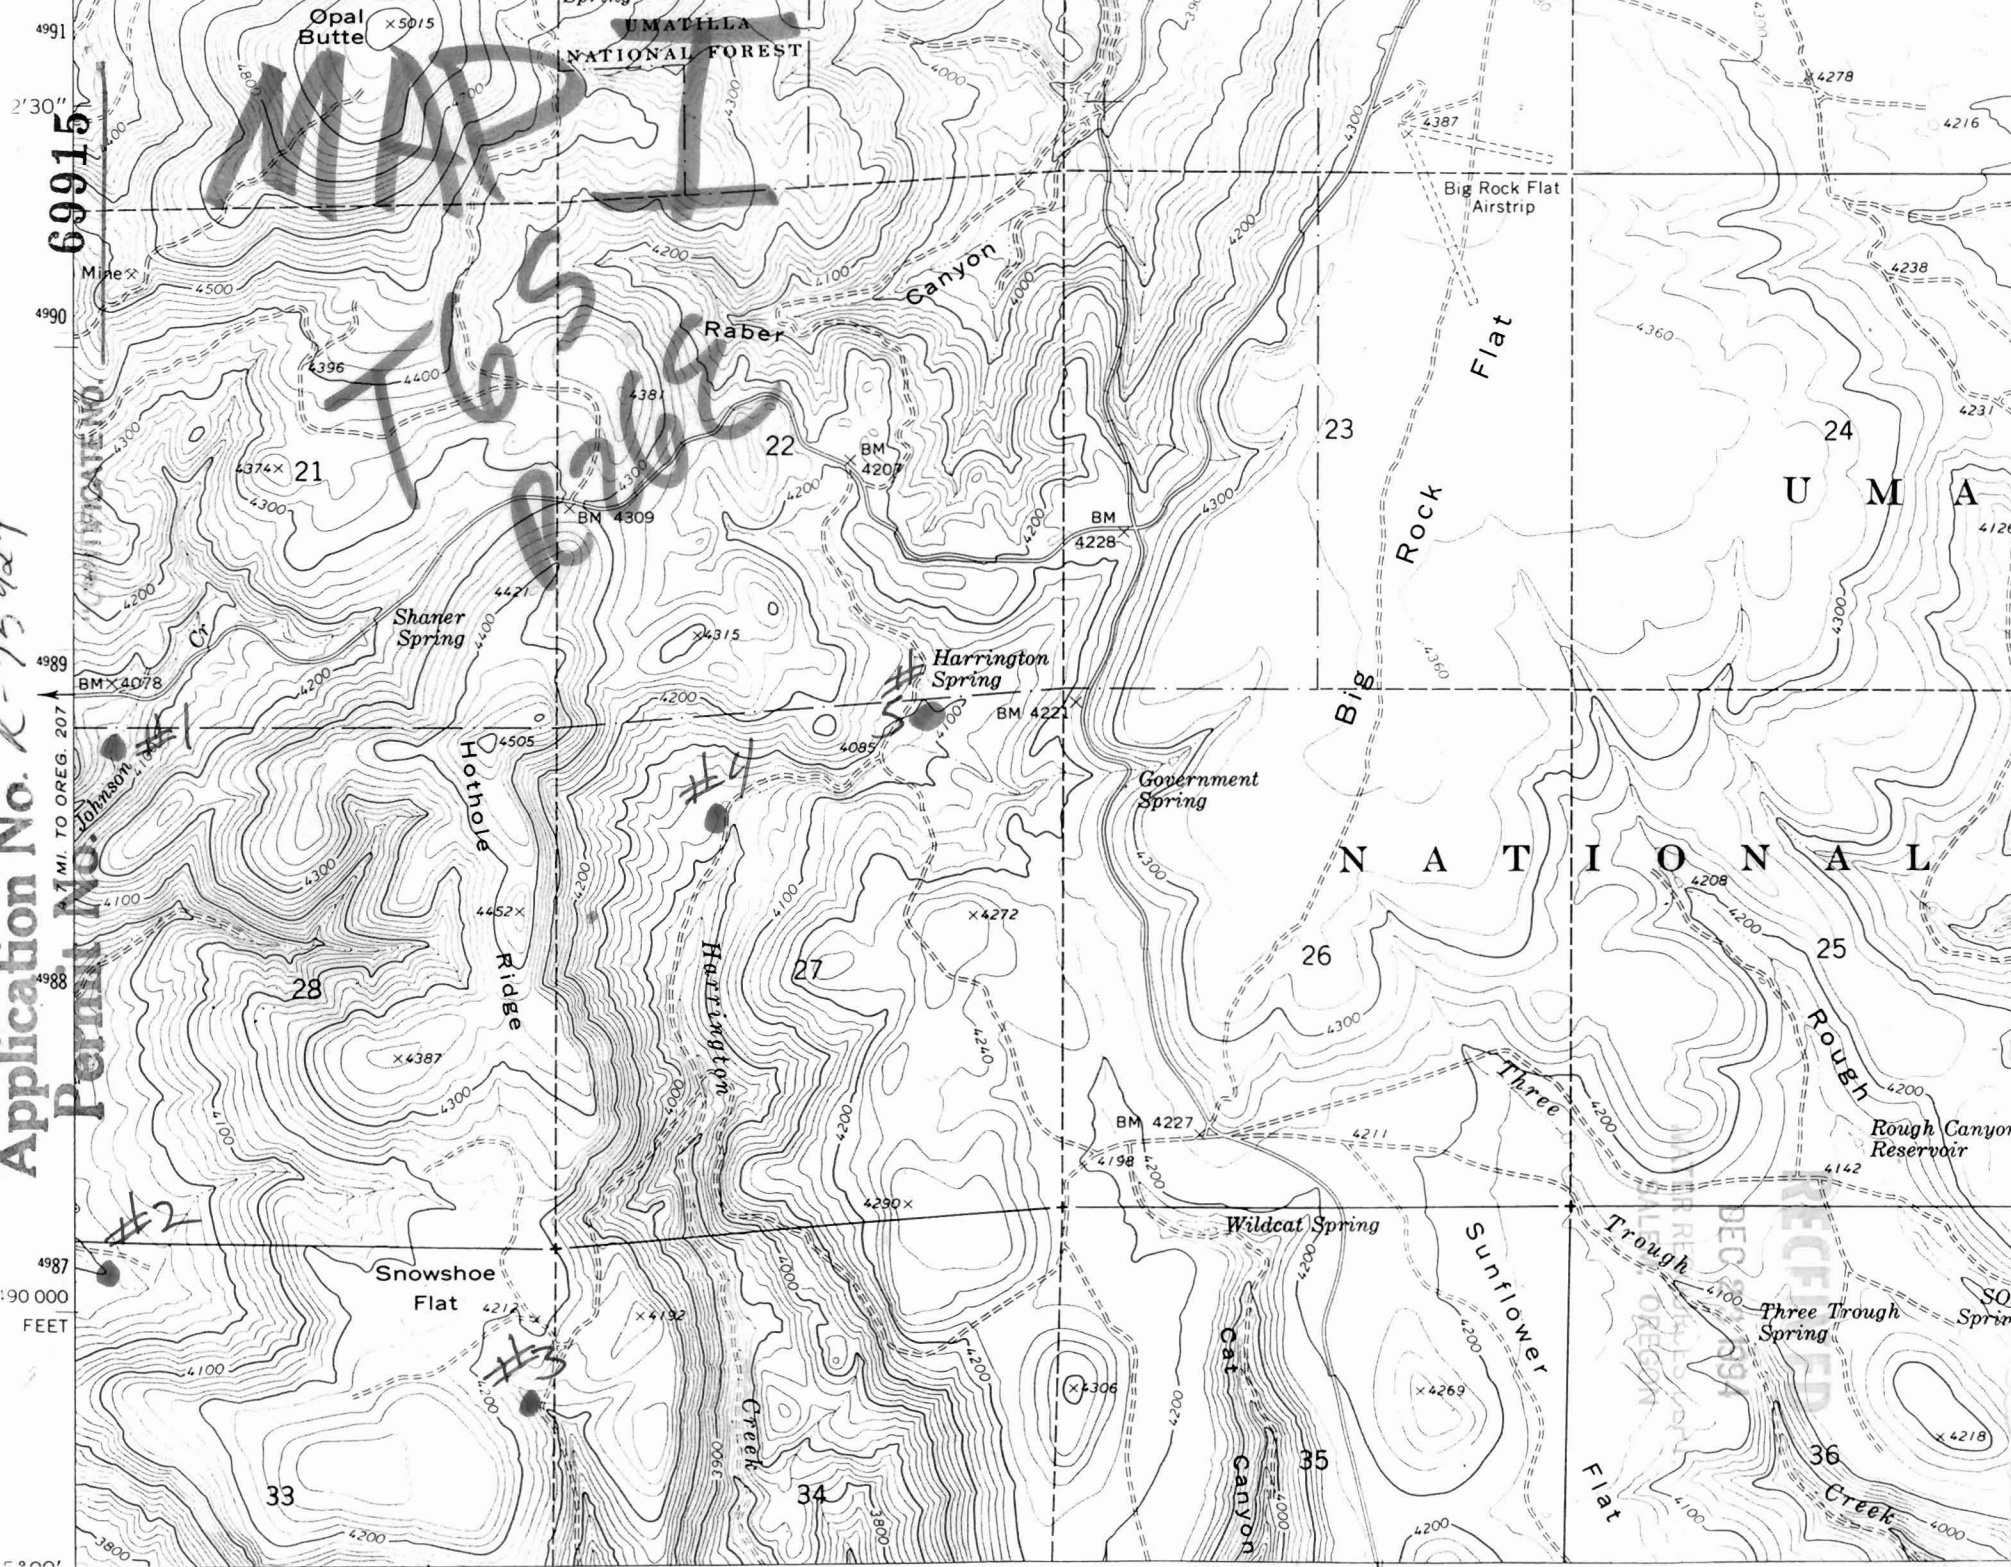

4991
2'30"
69915
4990
4989
4988
4987
190 000
FEET

MAR 1
76 S
26 E

HARRINGTON

#2
#3
#4

33 34 35 36

Opal Butte x5015

Mine x

21

Shaner Spring

28

Snowshoe Flat

33

UMATILLA NATIONAL FOREST

Raber Canyon

Raber

22

Harrington Spring

27

34

Ganyon

22

Harrington Spring

27

34

Big Rock Flat Airstrip

23

Government Spring

26

35

Big Rock Flat

24

Three Trough

36

U M A

N A T I O N A L

Three Trough Spring

36

4278

4238

4231

4126

25

Rough Canyon Reservoir

Three Trough Spring

36

RECEIVED
DEC 29 1994
OREGON