


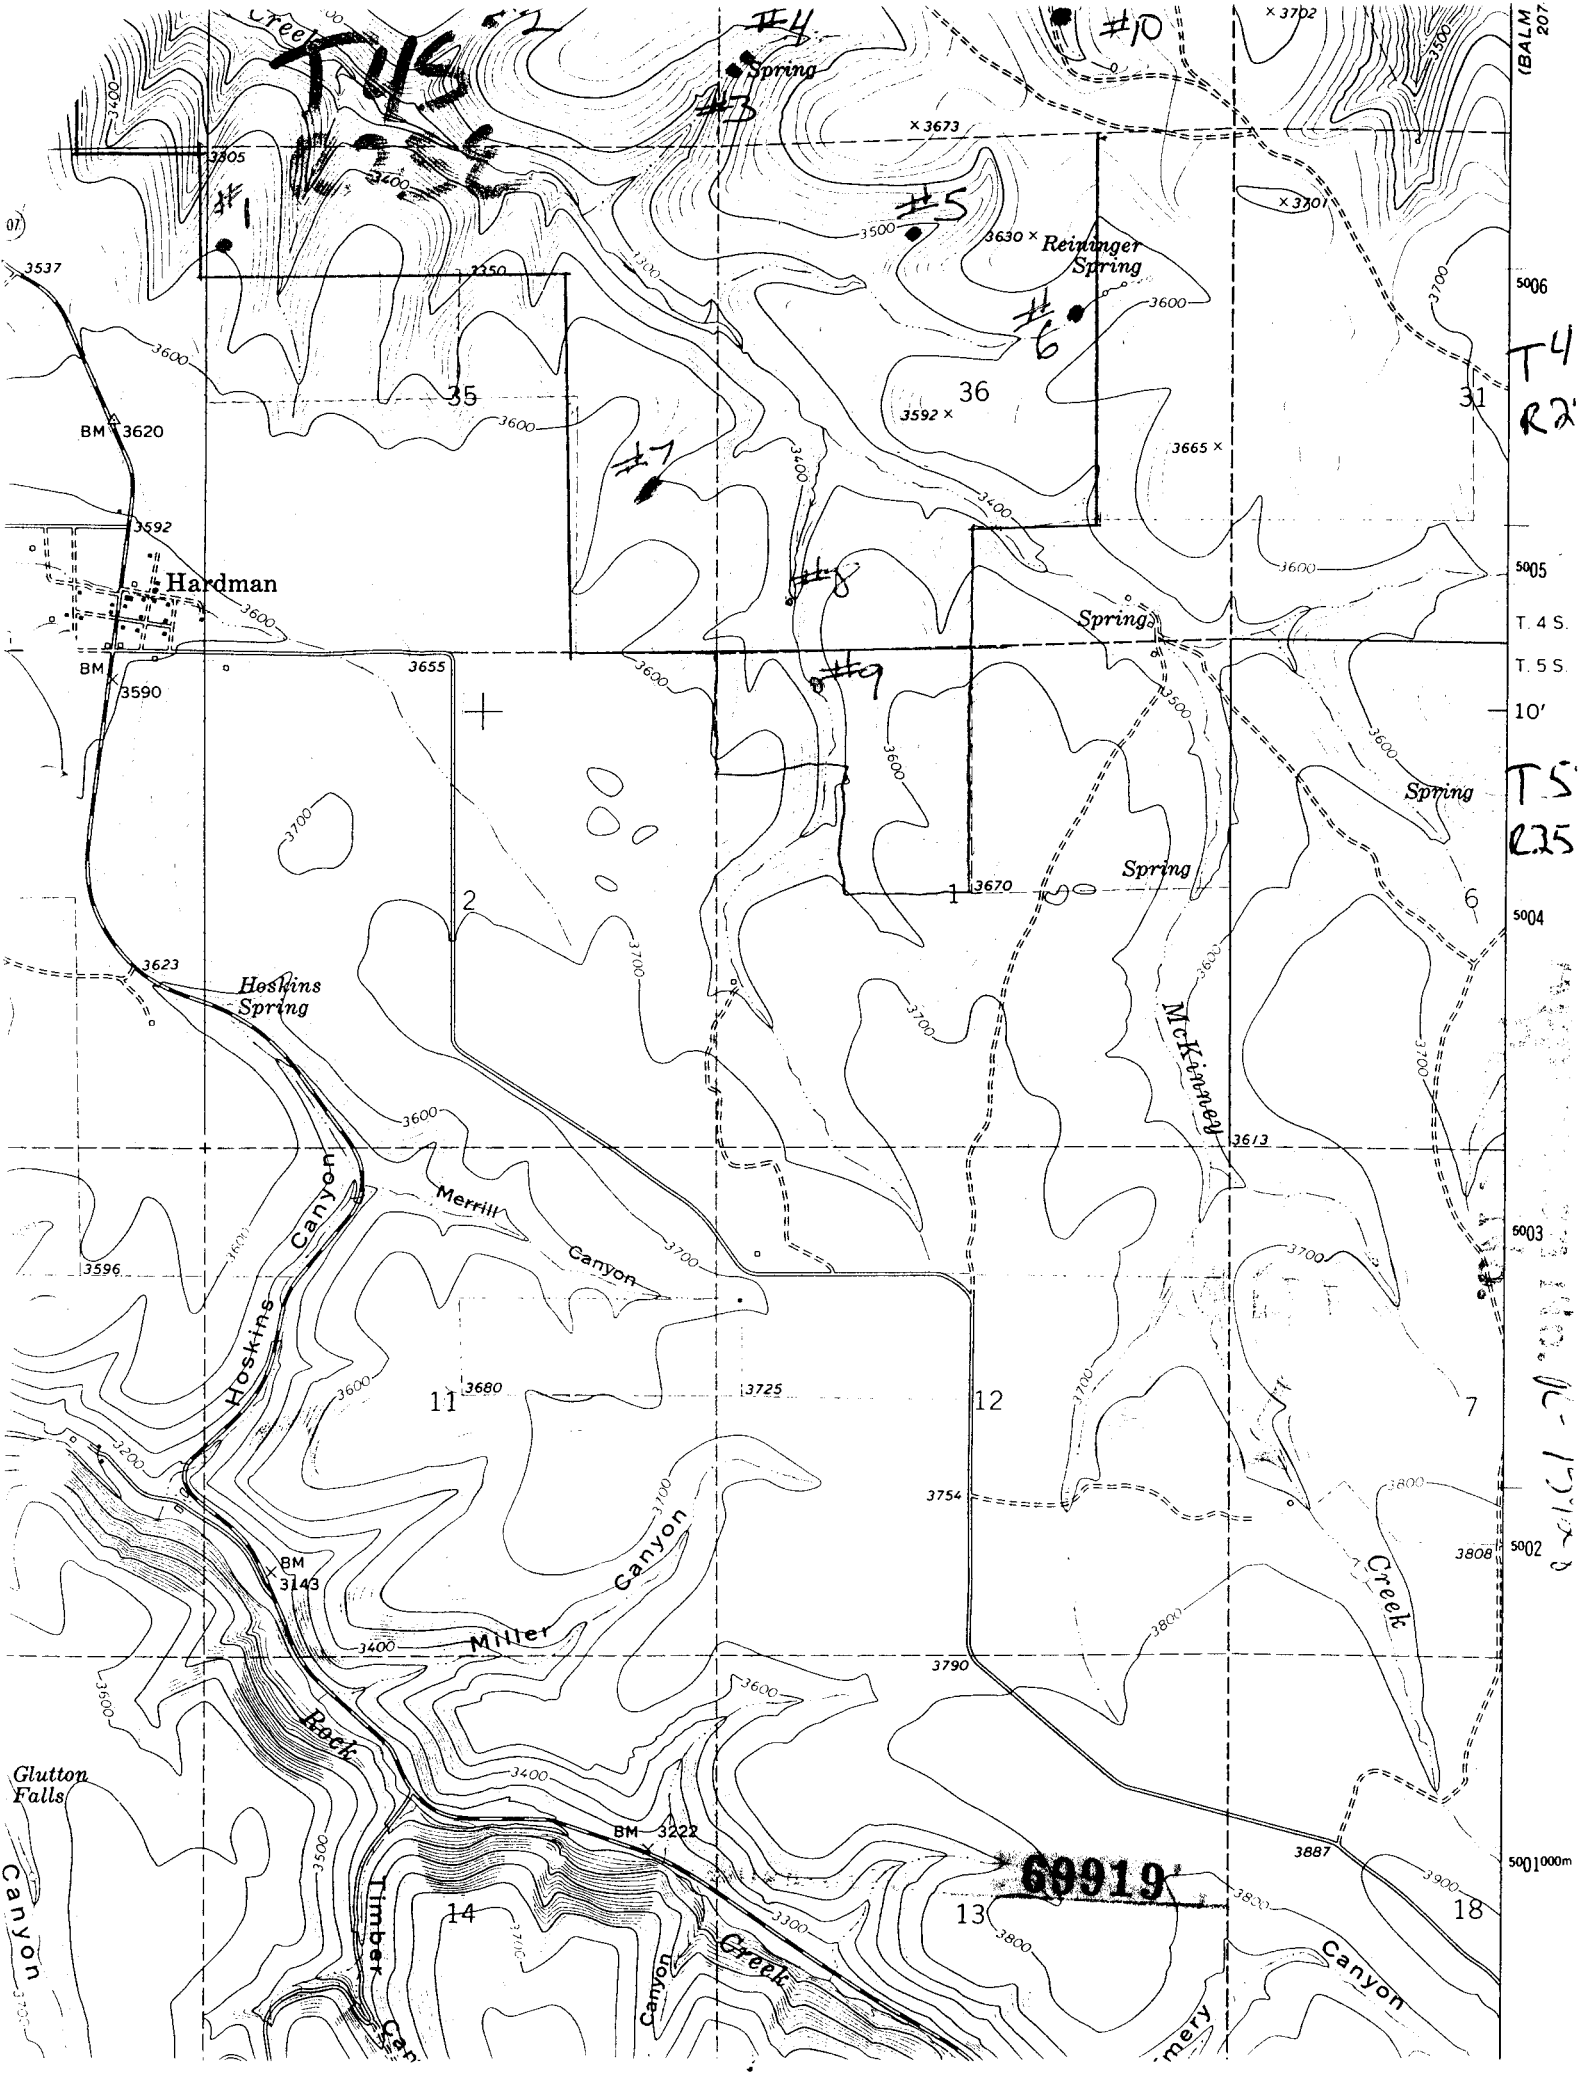

T4S
R2S
T5
R2S
10'
5006
5005
5004
5003
5002
5001000m