

Hilda S. & H. EARL
JONES

SECTION 18 T.28S. R.6W. WM.
DOUGLAS COUNTY

REVISED ON
12-30-92

28 6 18

ATTACHMENT # 6

SEE MAP 28 6 7

Application No R-15934
Permit No. 7
"CERTIFICATE NO. 69927"

12 7
13 18

CANCELLED NO'S
900

550,000

SEE MAP 29 6 17

Property
Boundary
includes
Part of
Section 18
&
Section 19
APP# R-15934

"CERTIFICATE NO. 69927"

CANCELLED NO'S
2002
2101
2601
2103
2400


545,000

SEE MAP 28 6 20BC

P.P. 1991-36
1. 54.40'
16. 41.12'
17. 117.76'

P.P. 1992-105
1. 1553'

SEE MAP 28 6 20C

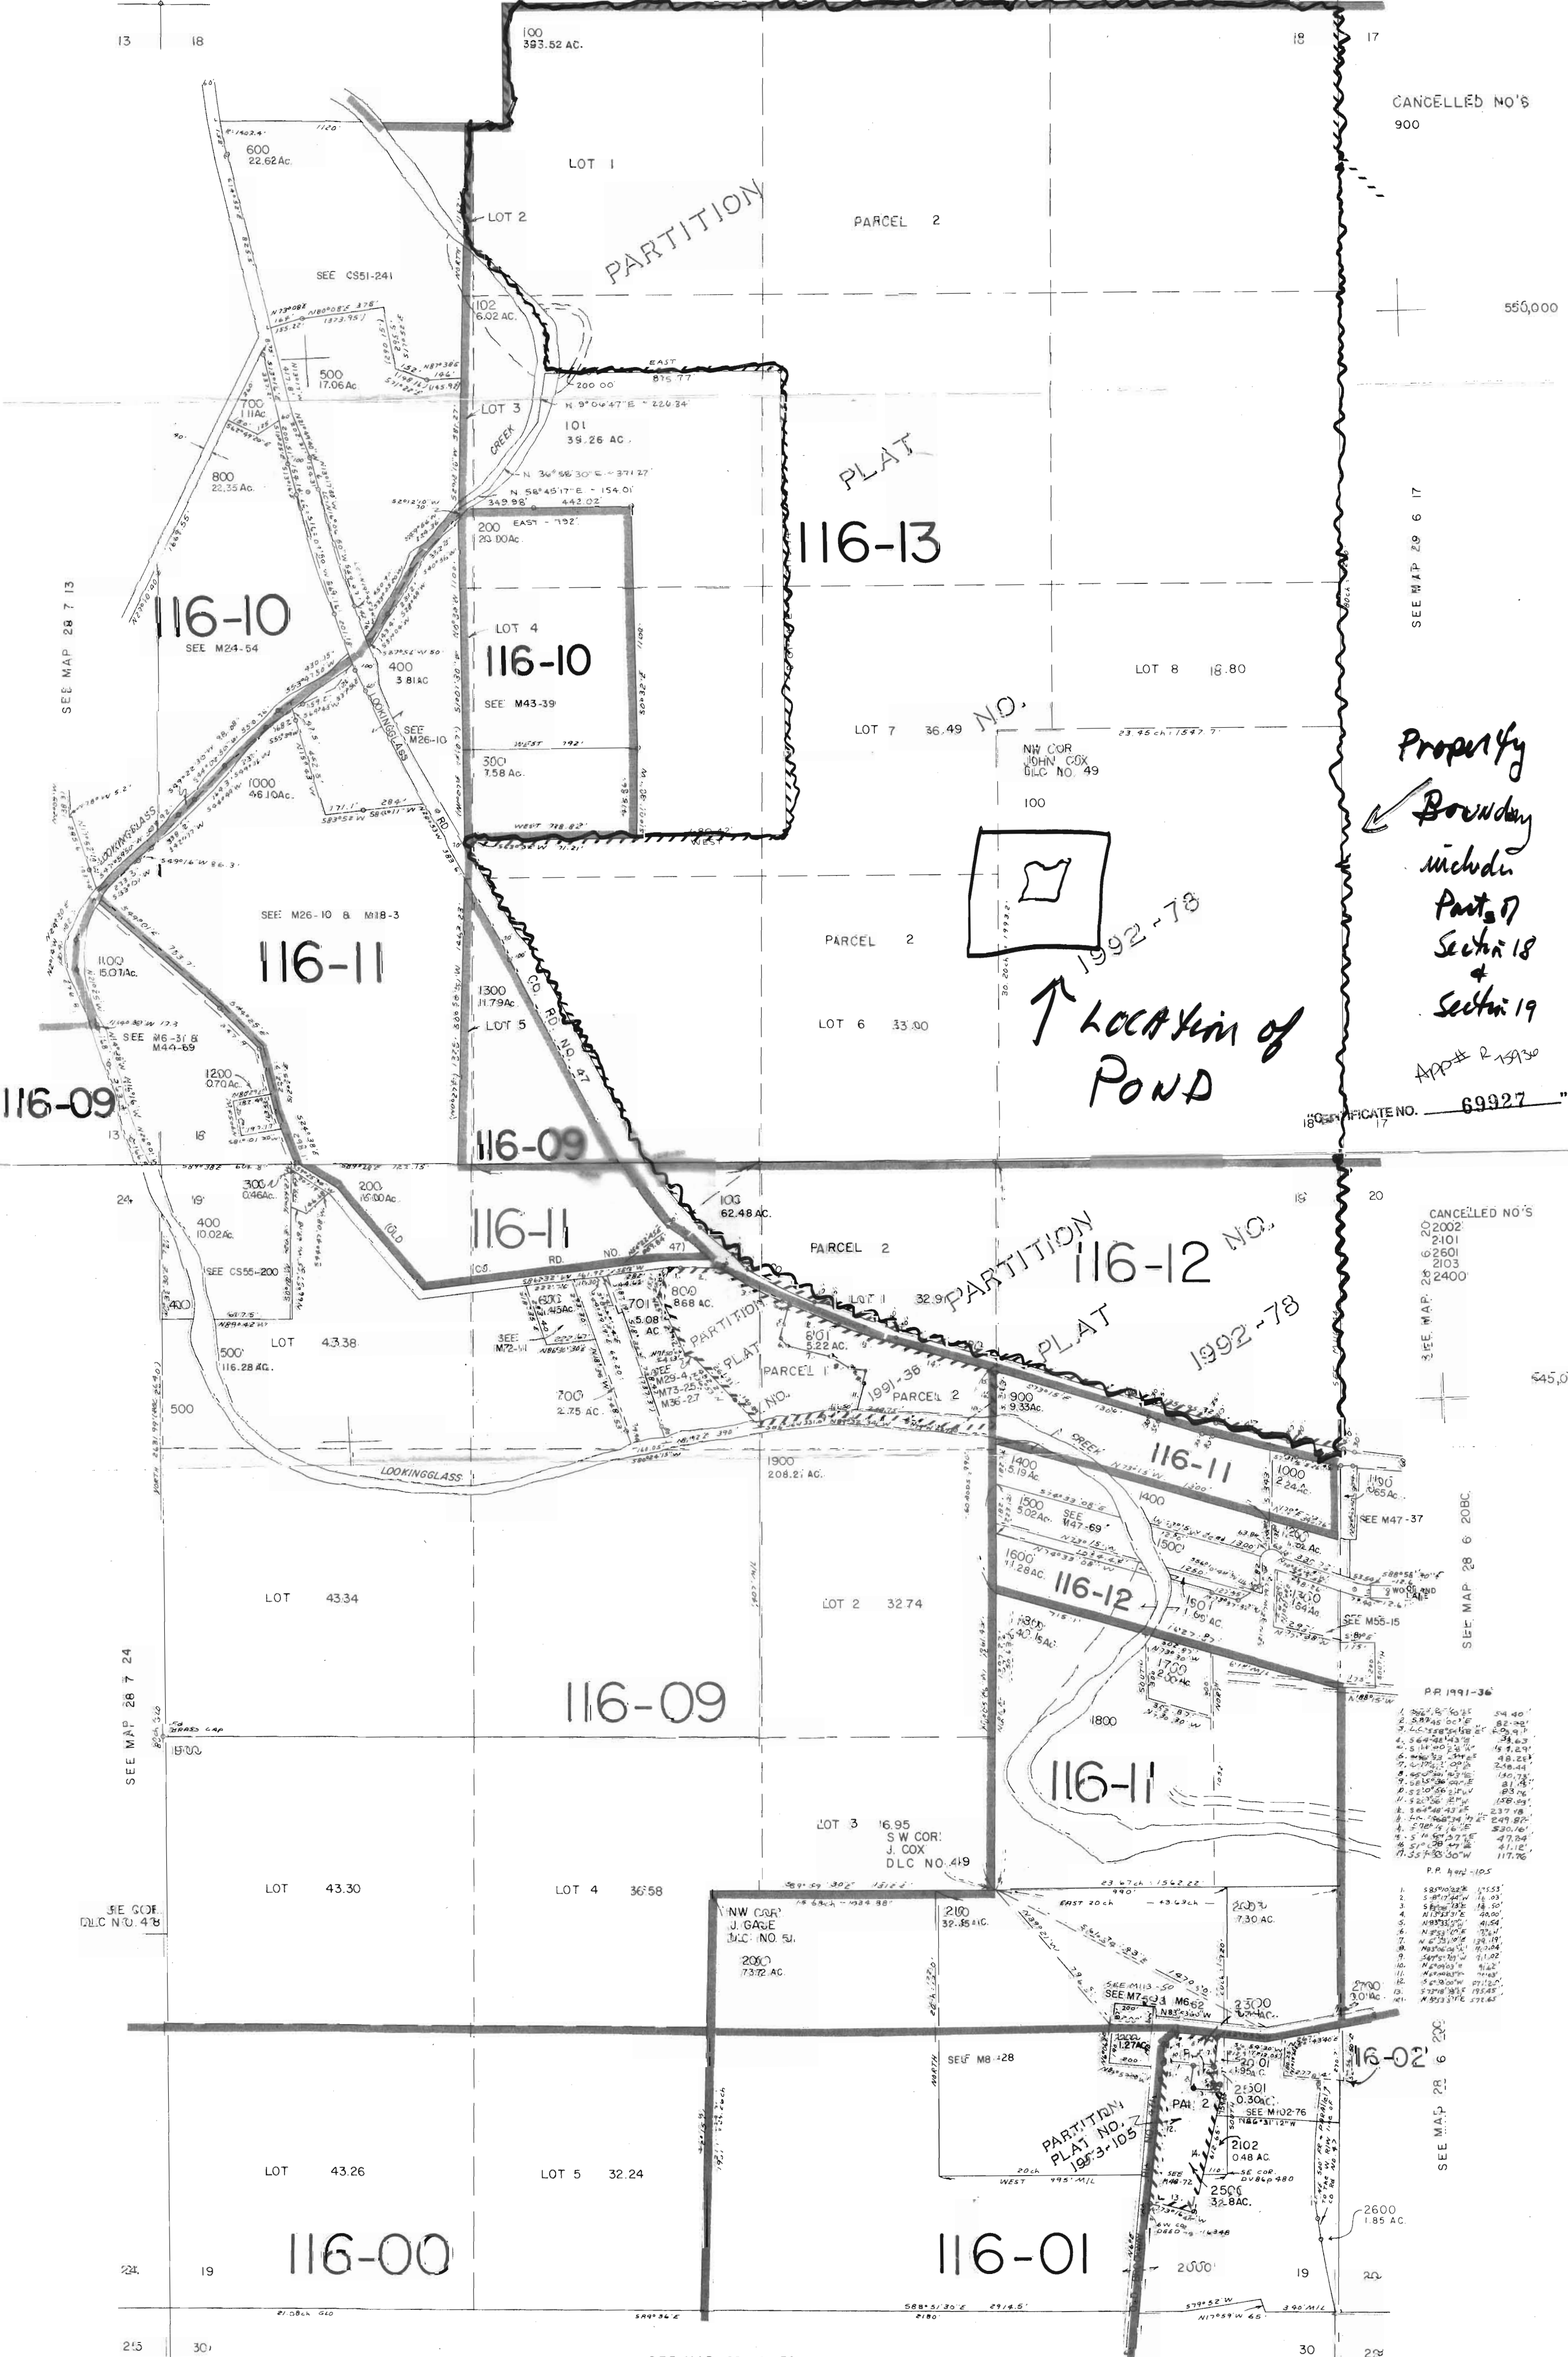

SEE MAP 28 6 30

28 6 19