

N.W. 1/4 S.13 T.28 S. 4 W,

SECTION 13 T.28
DOUGLAS


1" = 400'

THIS MAP WAS PREPARED FOR
ASSESSMENT PURPOSE ONLY.

GERALD & NINA WILSON
13980 N. MYRTLE RD.
MYRTLE CREEK OR. 97457
PH. 8634673

Assessment No. R-75939
Parcel No.

SEE MAP 28

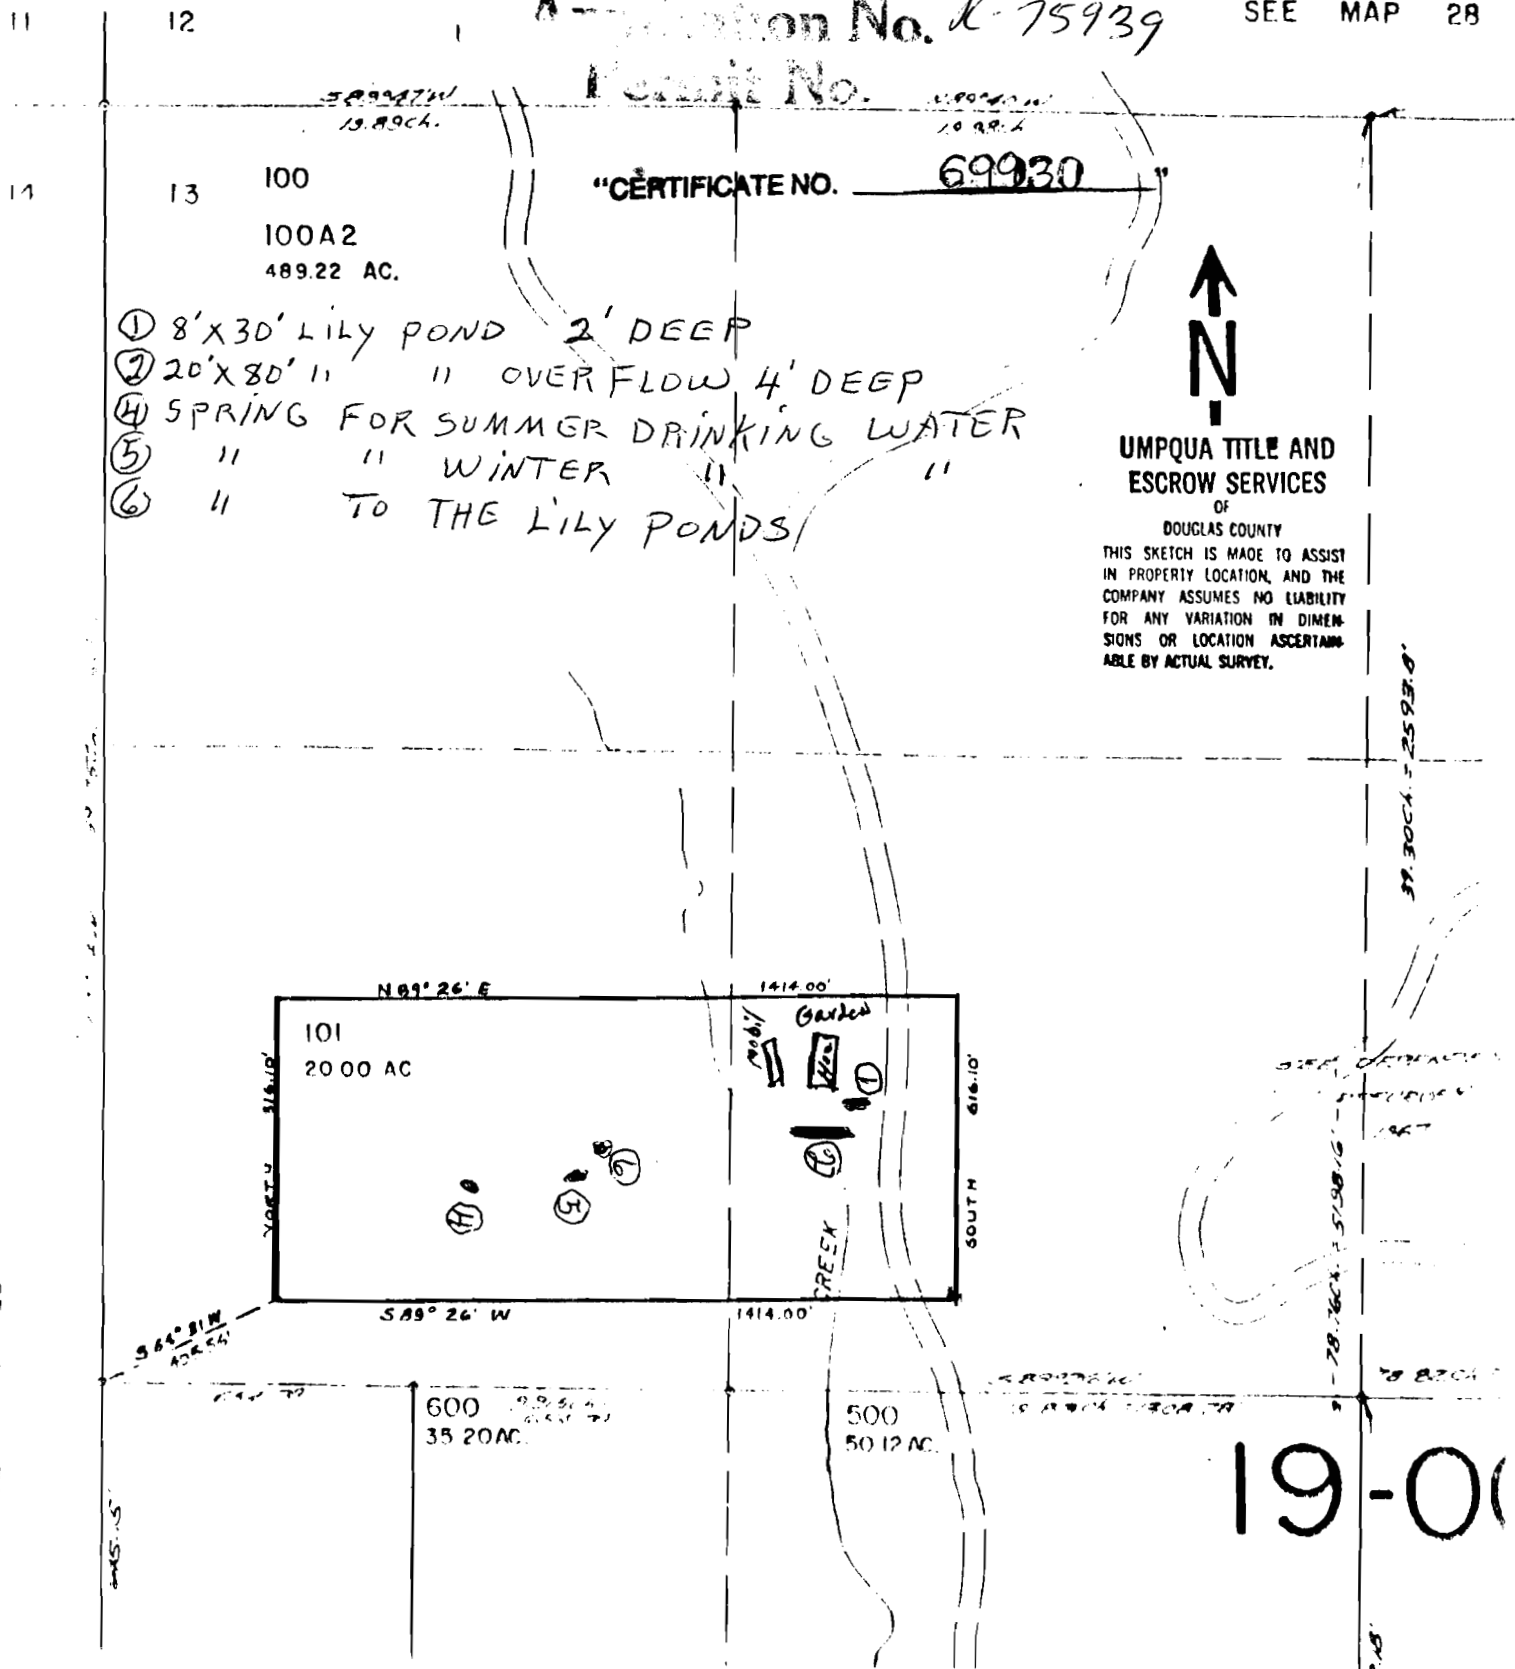

**UMPQUA TITLE AND
ESCROW SERVICES**
OF
DOUGLAS COUNTY
THIS SKETCH IS MADE TO ASSIST
IN PROPERTY LOCATION, AND THE
COMPANY ASSUMES NO LIABILITY
FOR ANY VARIATION IN DIMEN-
SIONS OR LOCATION ASCERTAIN-
ABLE BY ACTUAL SURVEY.

19-00

SEE MAP 28