

THIS MAP WAS PREPARED FOR ASSESSMENT PURPOSE ONLY.

COOS COUNTY

T-400



2N

CANCELLED 202

SEE MAP 28 13 36

36 31

SCALE 1/4"=400'

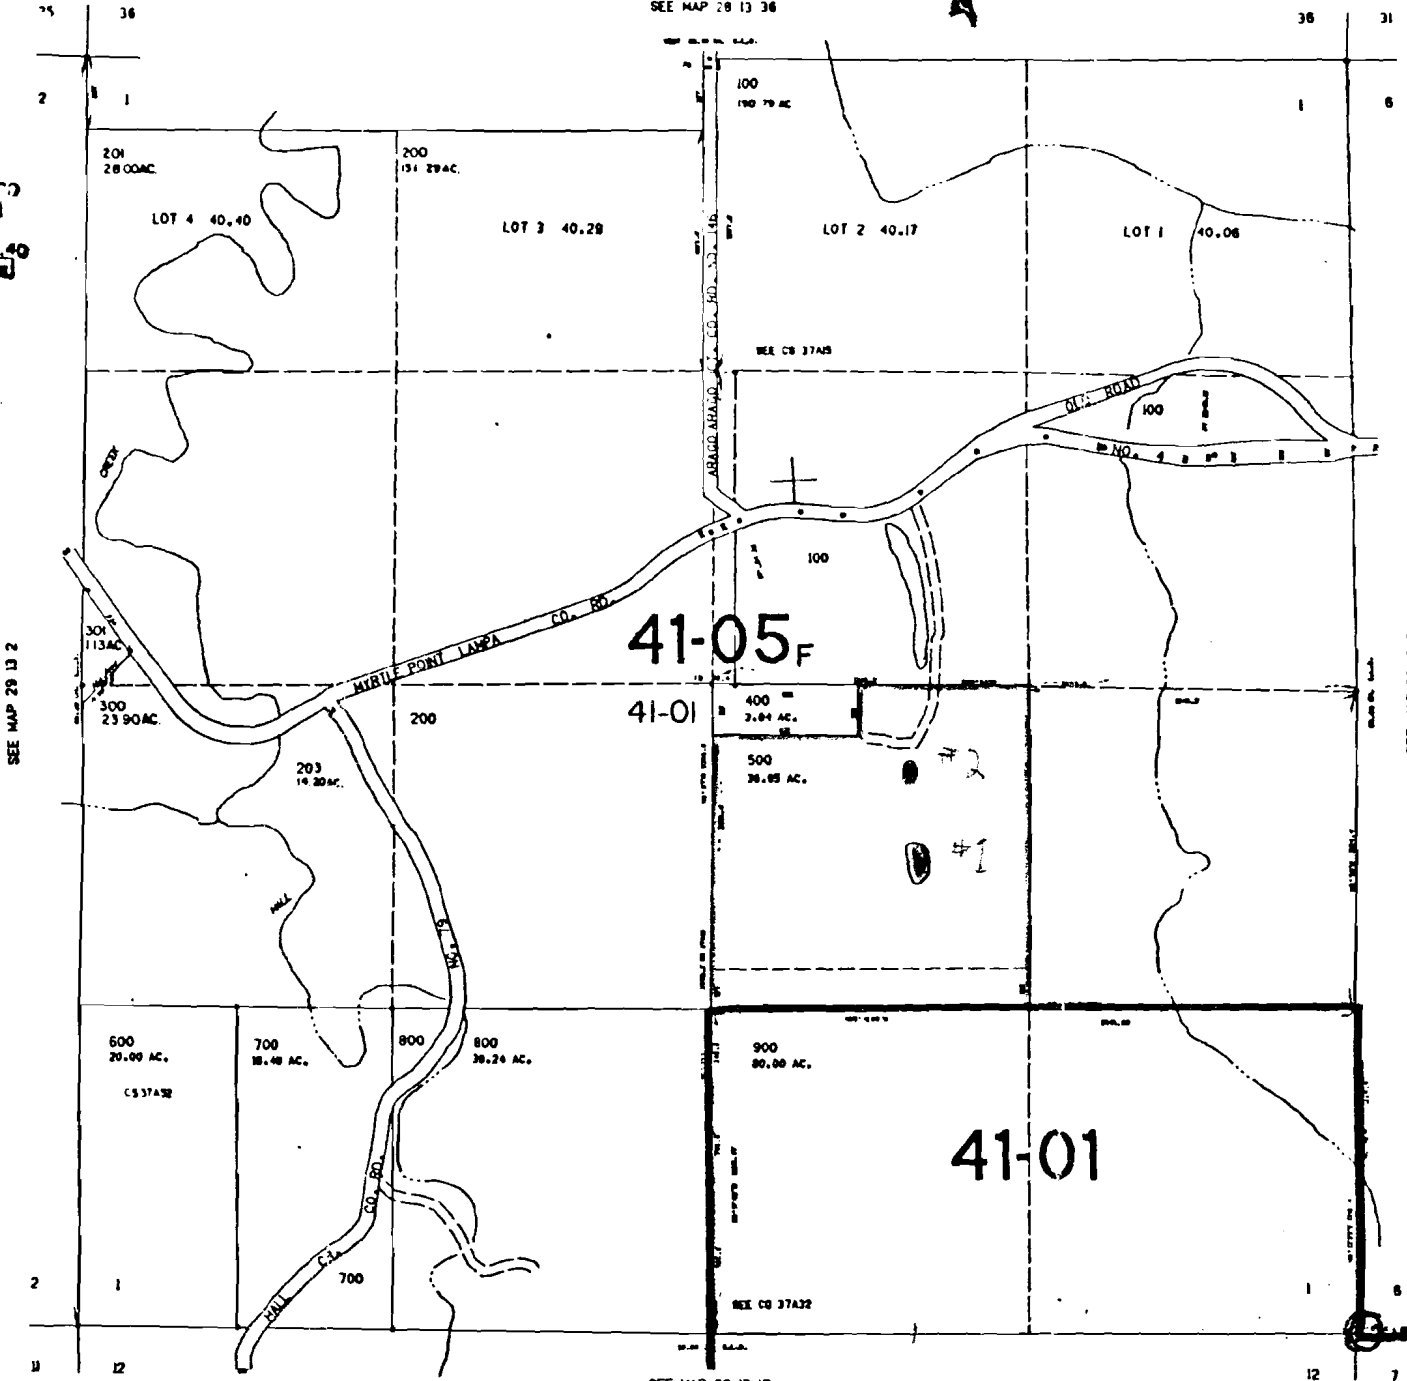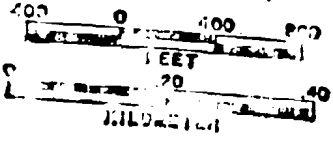

SEE MAP 29 13 2

SEE MAP 29 12 6

#1
1820'W
2020'N

#2
1820'W
2315'N

SURVEY CORNER

SEE MAP 29 13 12

12 7

CERTIFICATE NO. 69935

CONTROL LAYOUT TRACED CHECKED

10/19/99