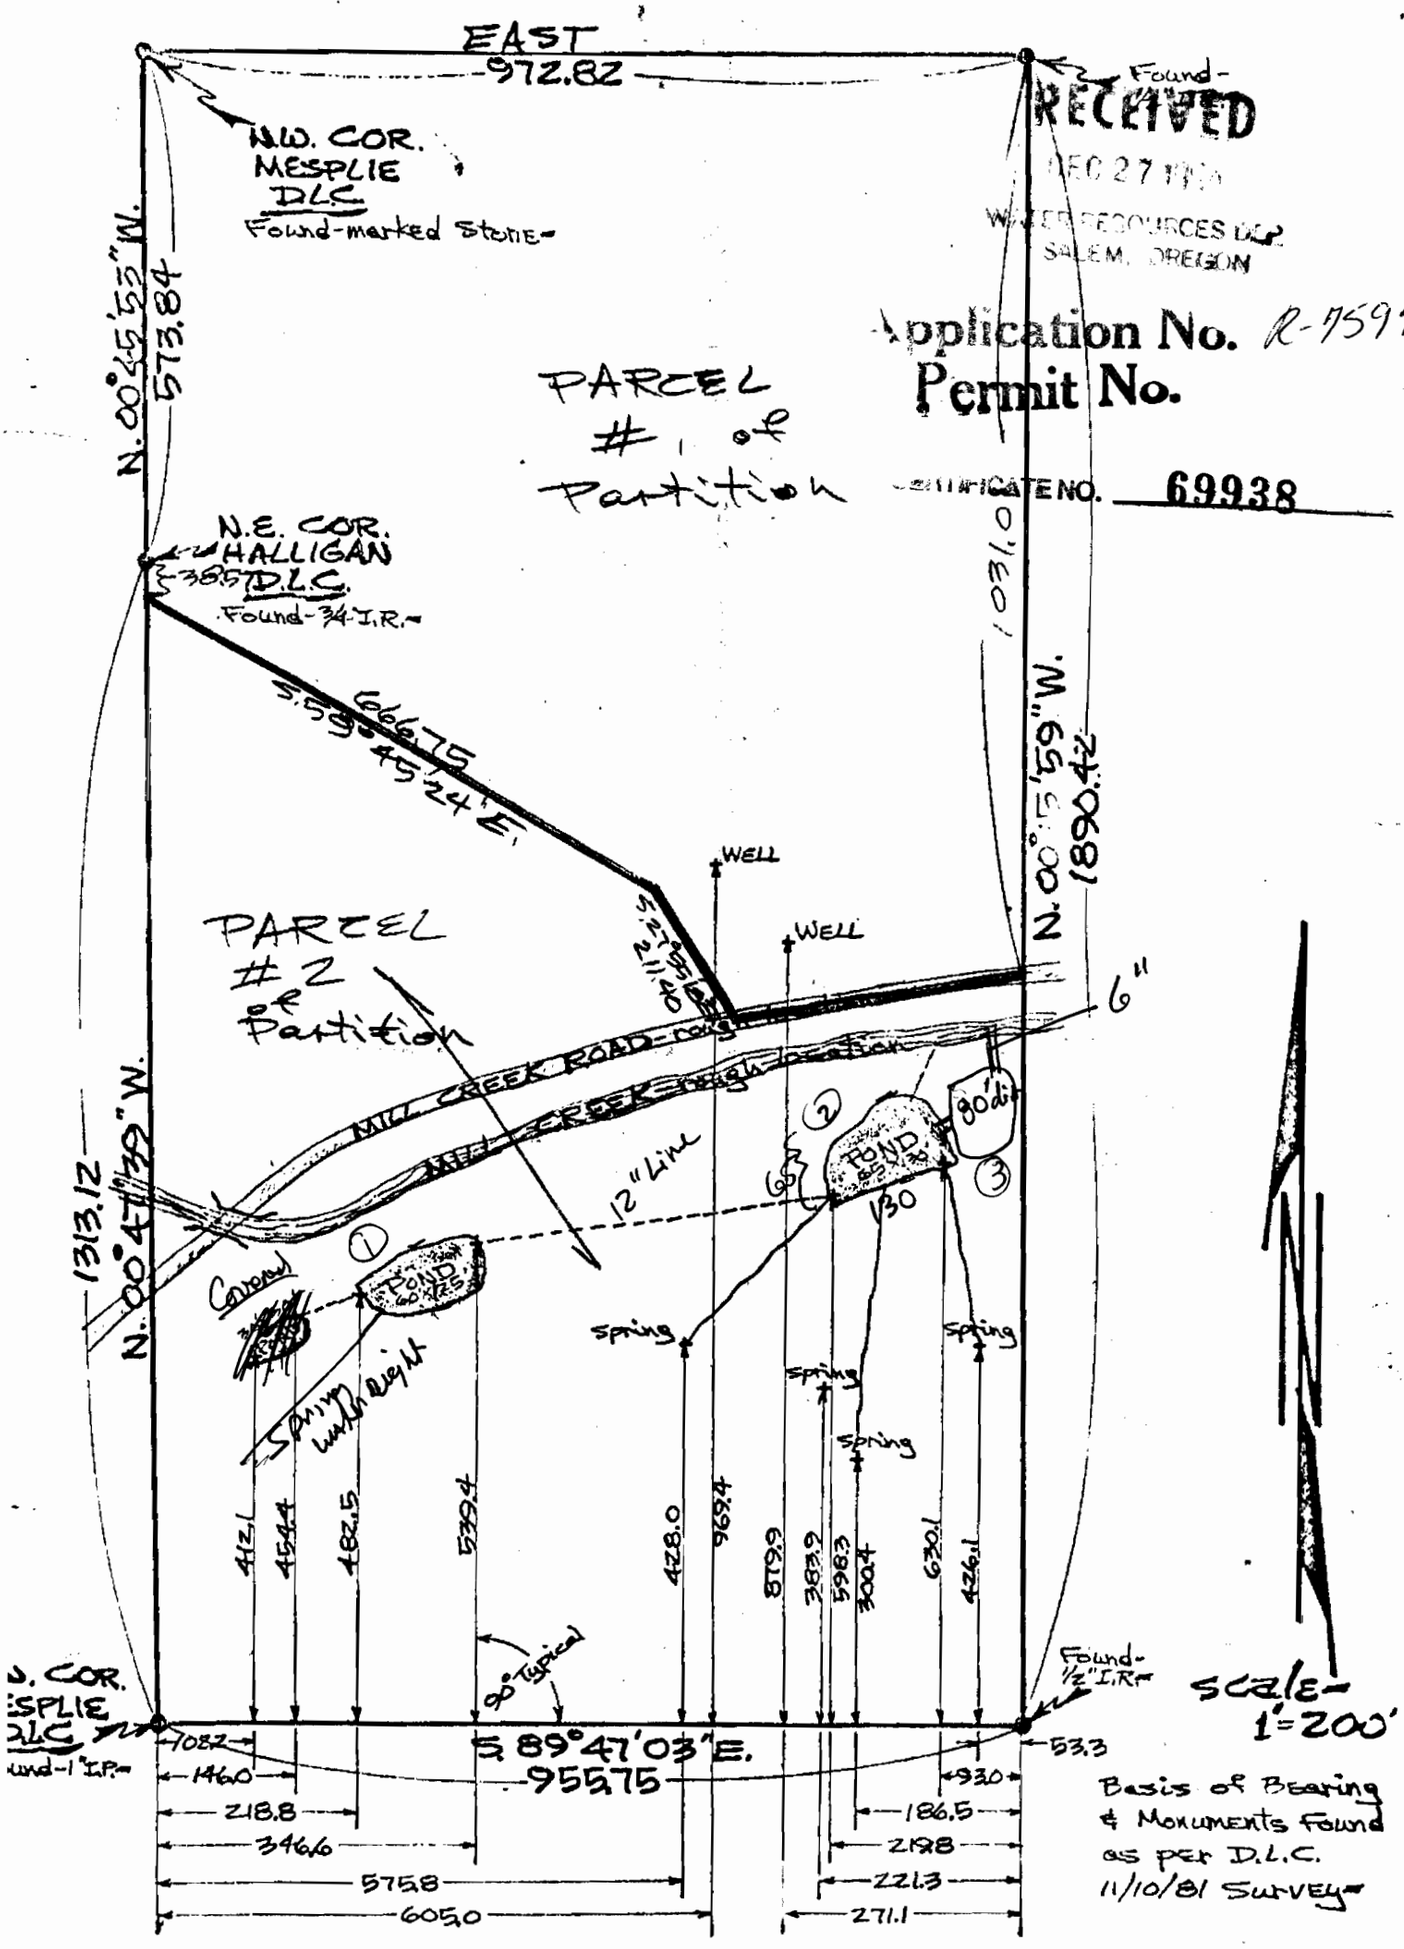

RECEIVED
DEC 27 1984
WATER RESOURCES DEPT
SALEM, OREGON

Application No. R-75947
Permit No.

CERTIFICATE NO. 69938

REGISTERED PROFESSIONAL LAND SURVEYOR
Danny L. Cron
OREGON
AUGUST 20, 1975
DANNY L CRON
1028
Dec. 9, 1984

"SURVEY"
FOR- David Mack
LOCATION- Water Resources located on the Mack Parcel located in the Mesplie D.L.C. #44 being located in Sec. 13, T.1N., R.1ZE,