


Twp. 13S., R. 34E., W. M.

Application No. R-75955

Permit No.

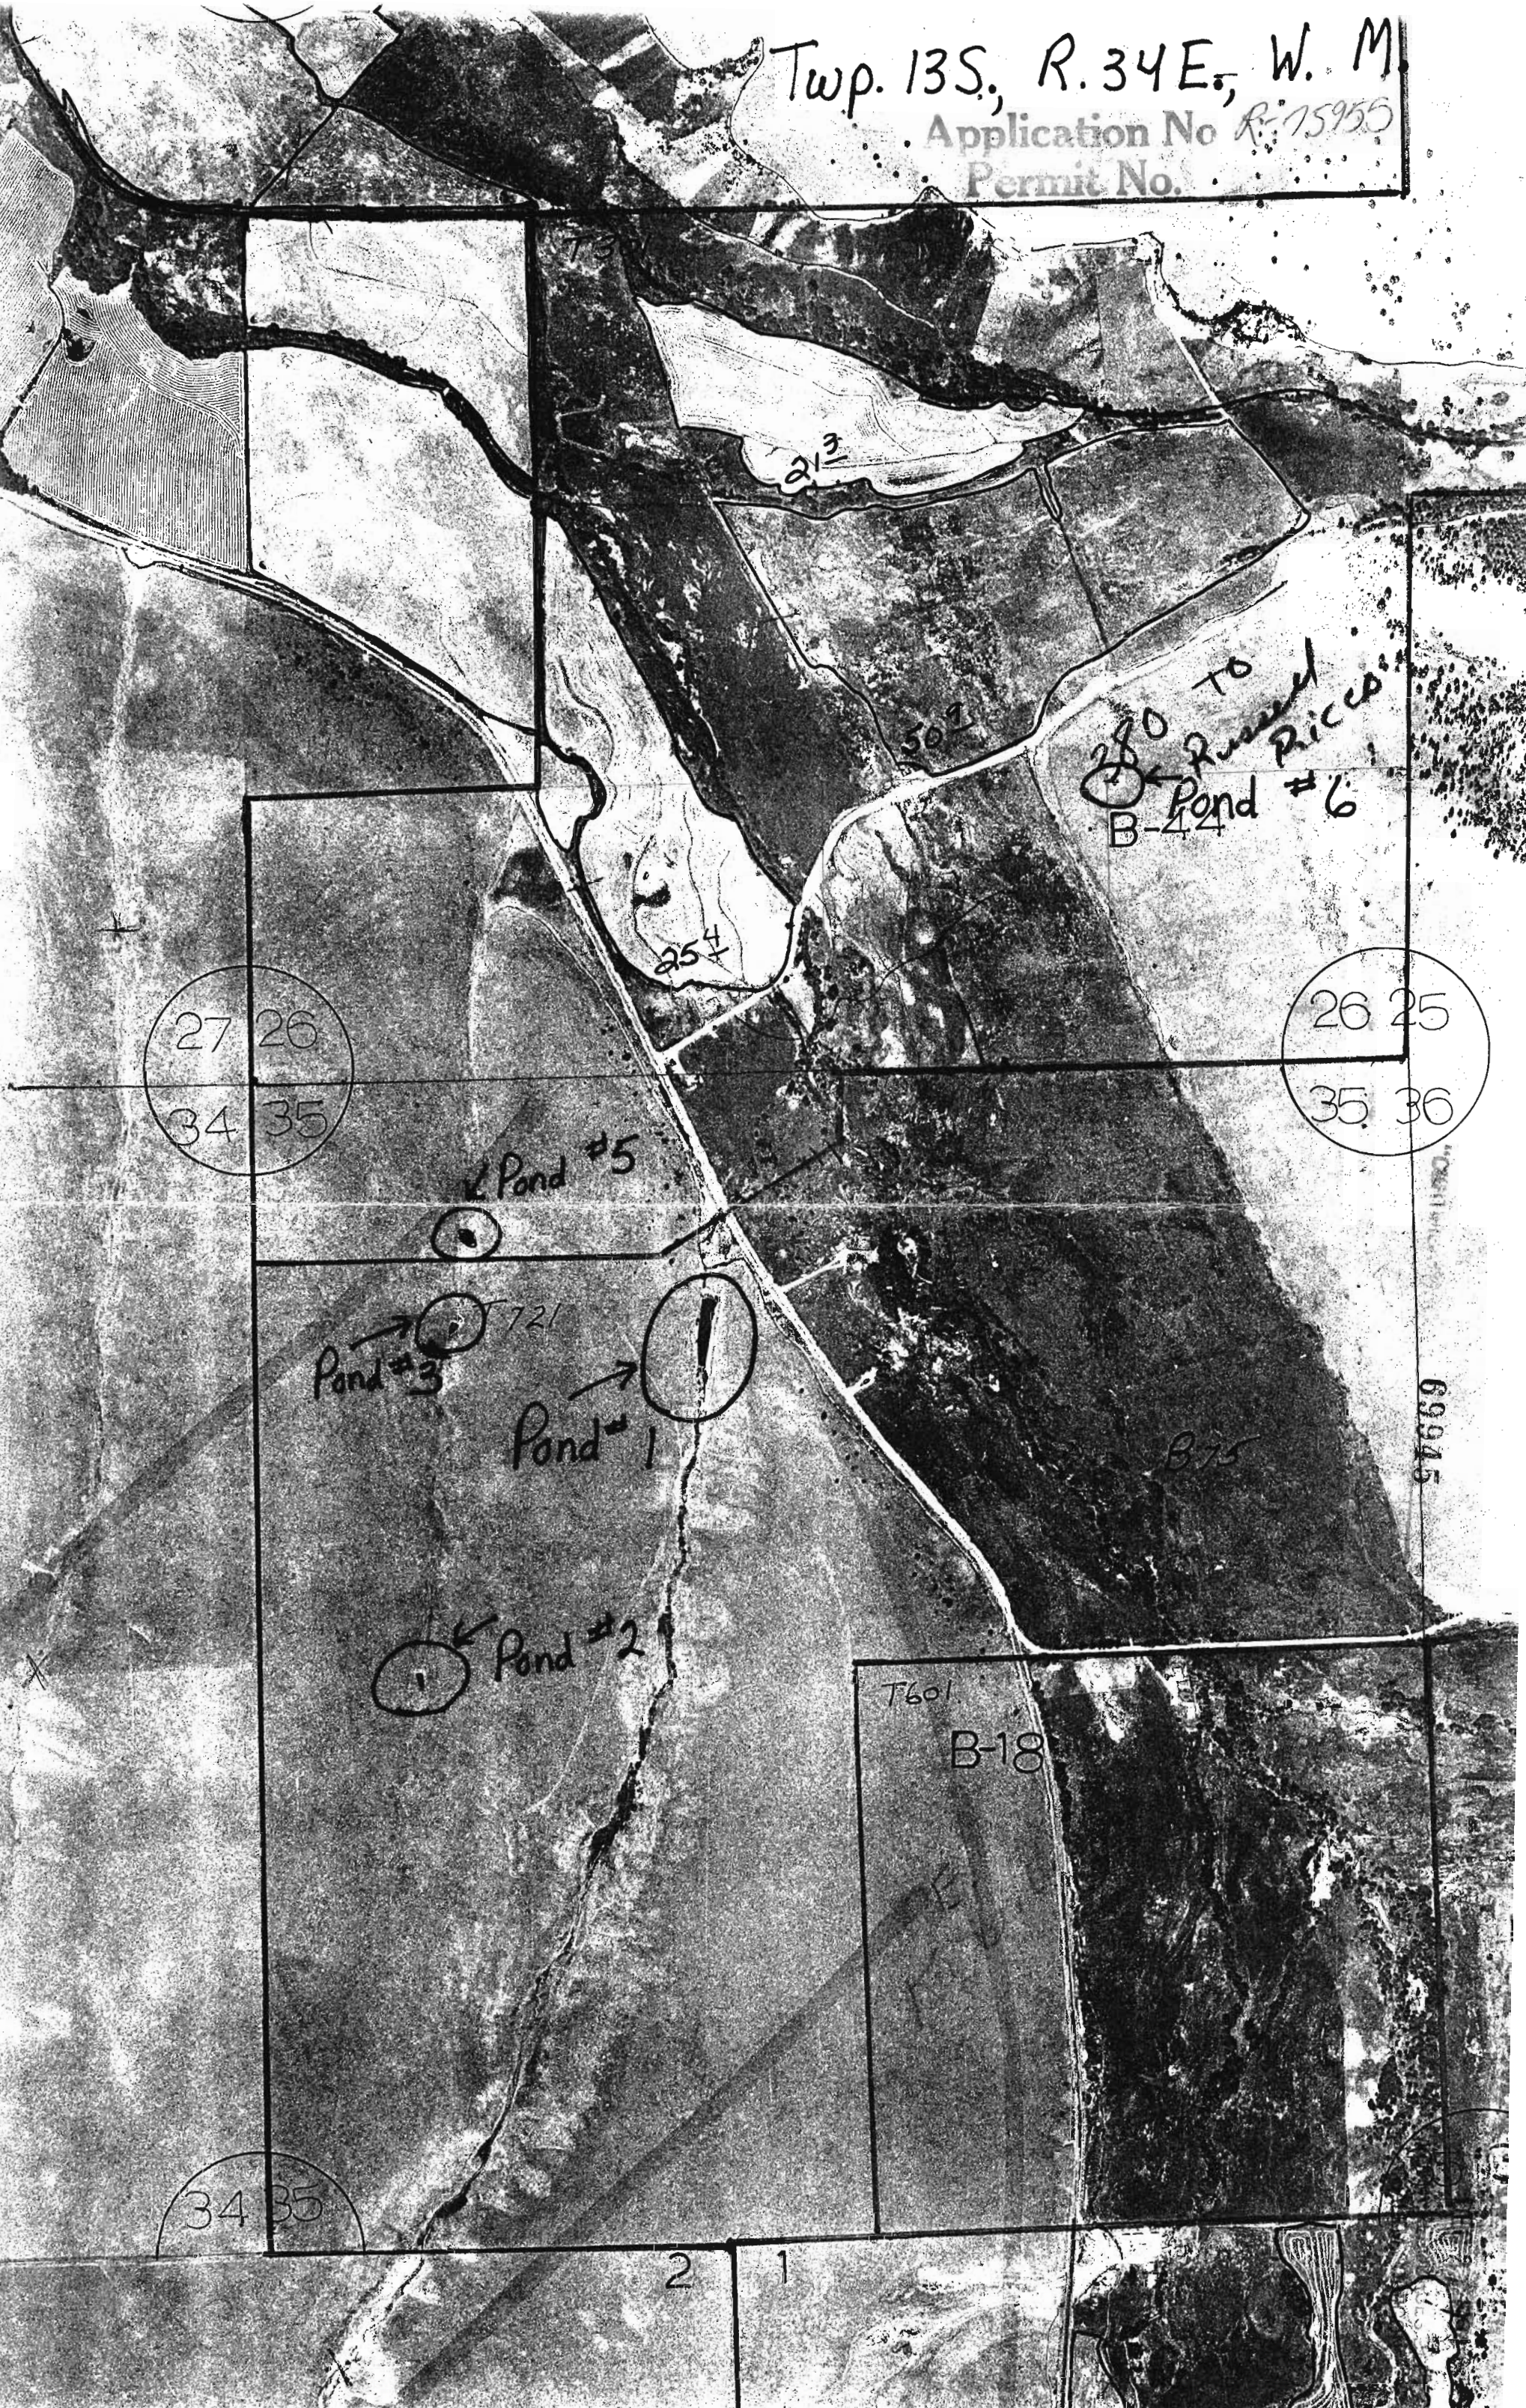

TO
Russell Pico
Pond #6
B-44

27 26
34 35

26 25
35 36

Pond #5

Pond #3

Pond #1

Pond #2

T601
B-18

69945

34 35

2 1

Twp. 13S., R. 34E., W.M.

REC'D
DEC 27 1994
REG

23 24
26 25

24 19
30

B-44

106

← Pond #6

← Pond #4

T721

26 25
35 36

T600
25
36 31