

SECTION 9 T.28S. R.5W. W.M.
DOUGLAS COUNTY

REVISED ON
8-15-94

28 5 9


THIS MAP WAS PREPARED FOR
ASSESSMENT PURPOSE ONLY.

1"=400'

Application No. R-75956
Permit No.

SEE MAP 28 5 4

CERTIFICATE NO. 69946

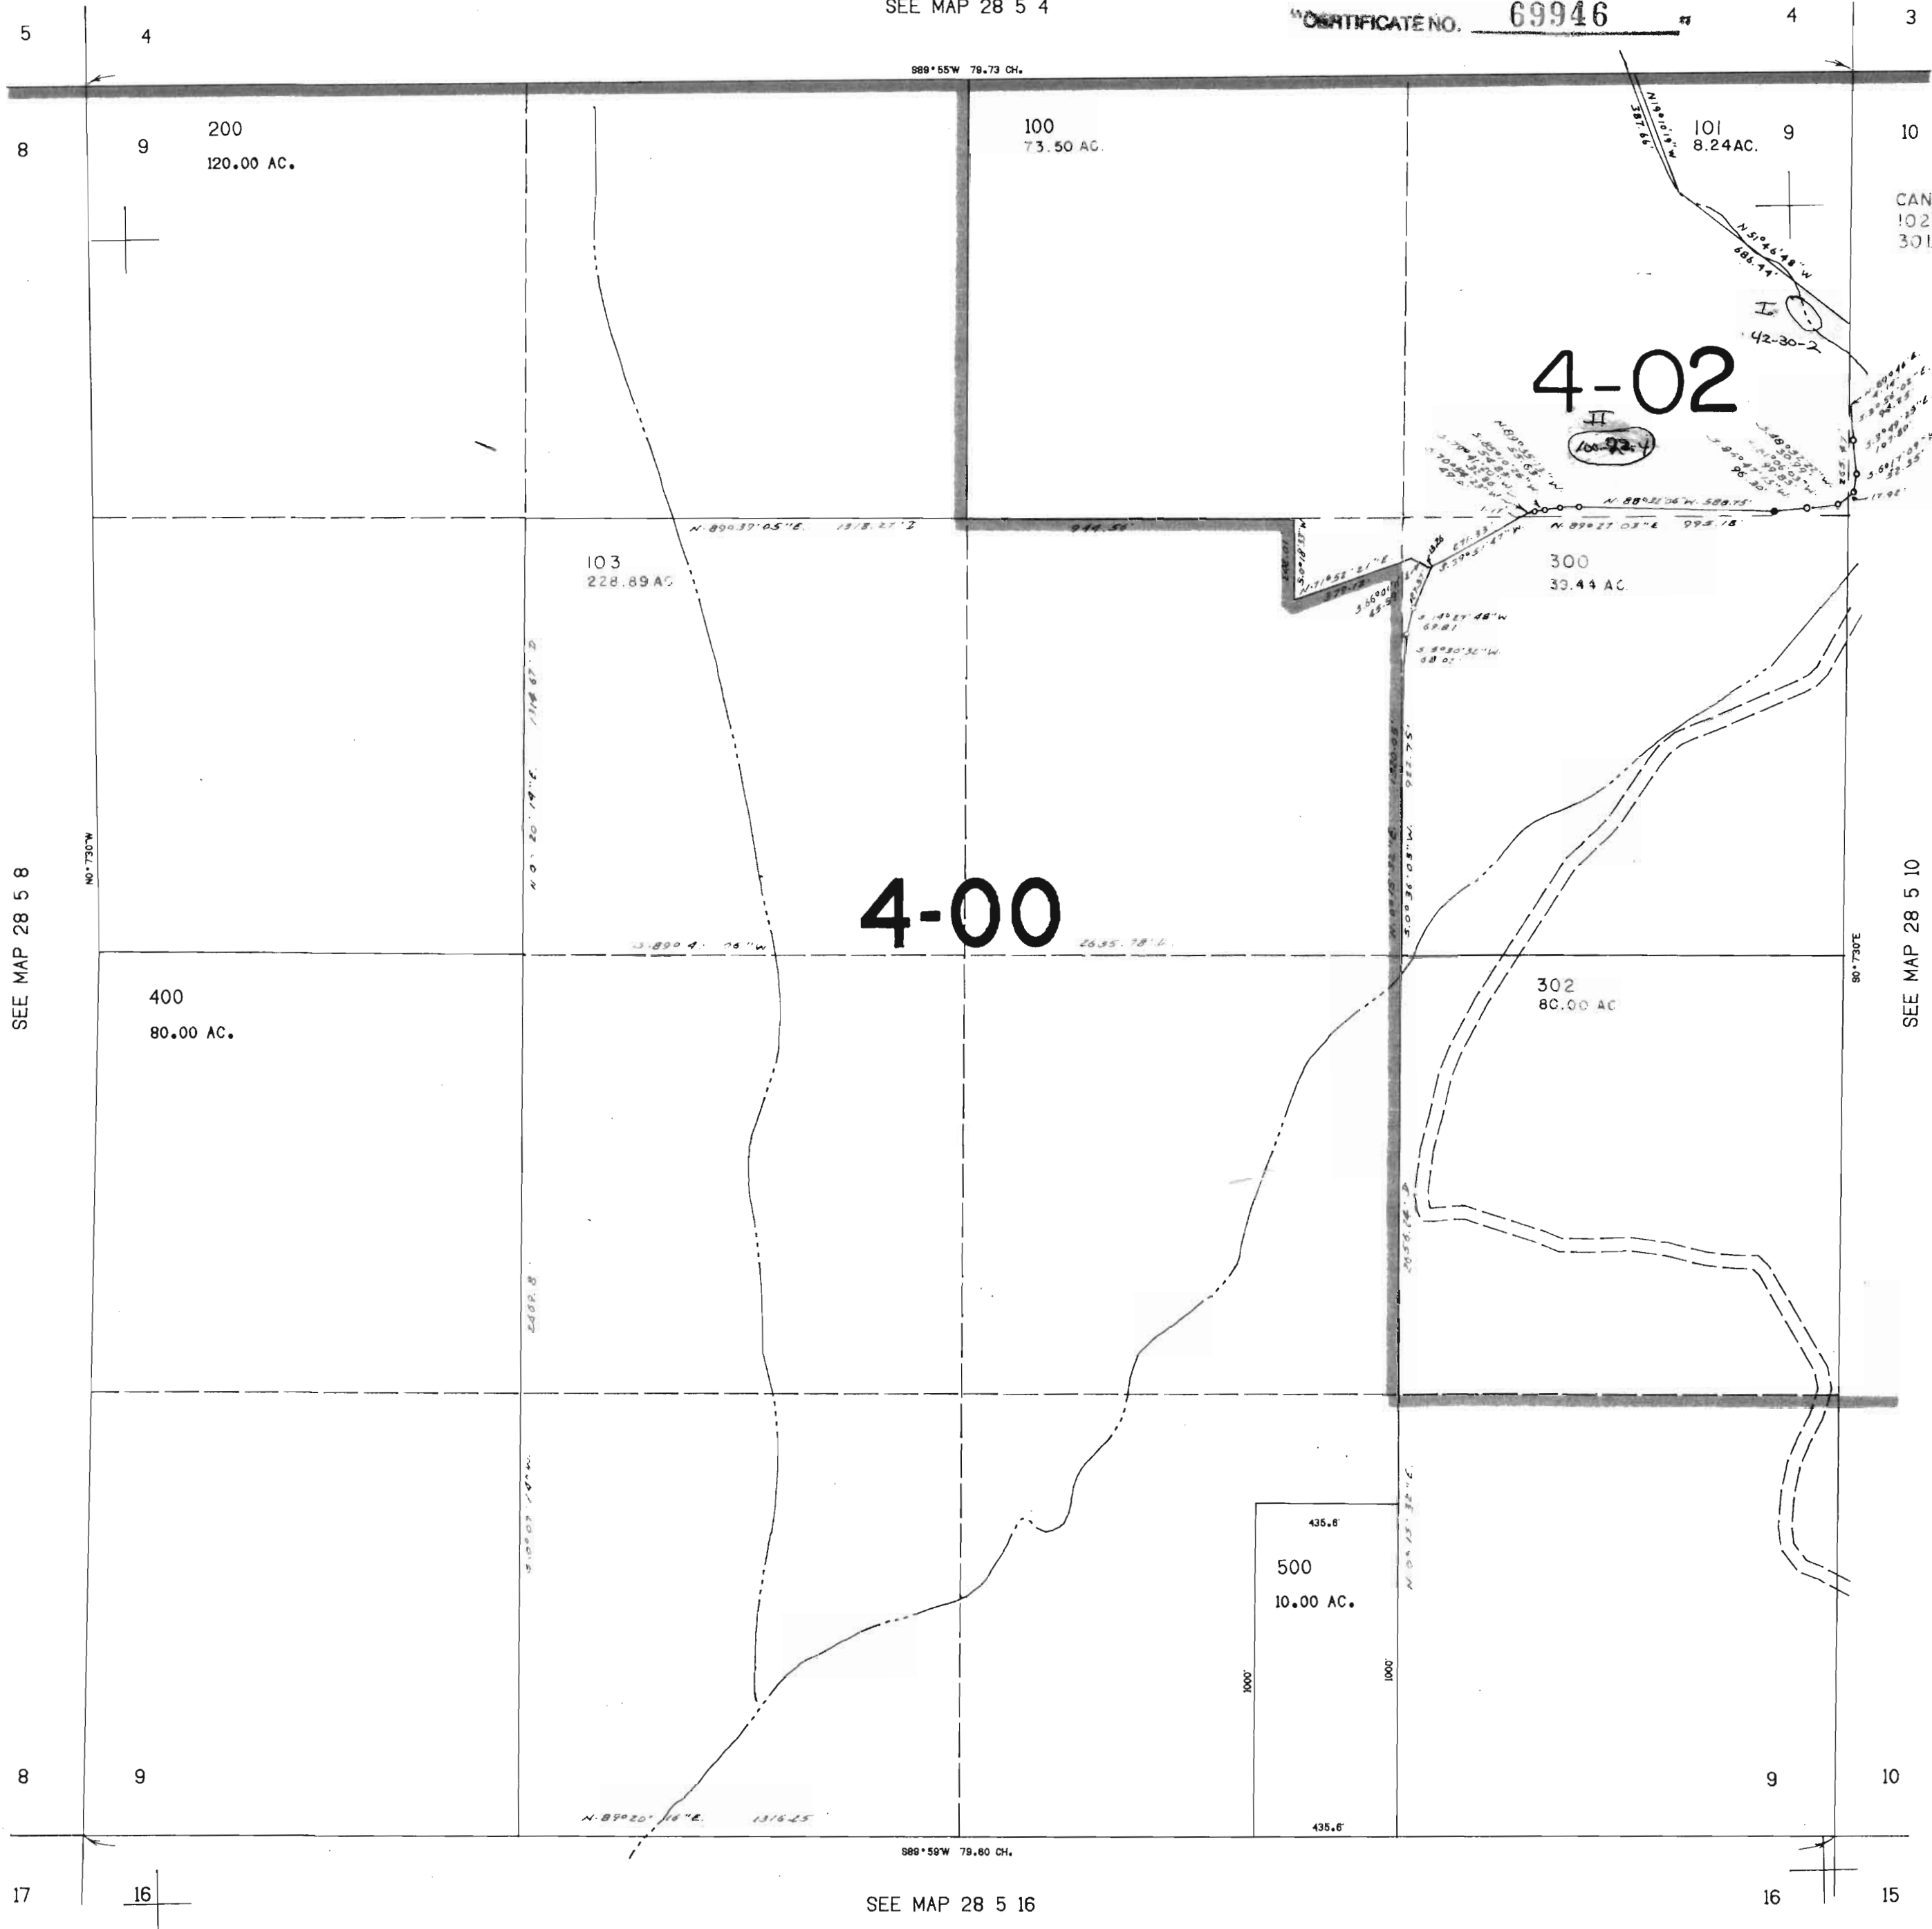

550,000

28 5 9