

SECTION 26 T.27S. R.7W. W.M.
DOUGLAS COUNTY


27 7 26
& INDEX

THIS MAP WAS PREPARED FOR
ASSESSMENT PURPOSE ONLY.

1"=400'

Application No. R-75957
Permit No.

CERTIFICATE NO. 69947

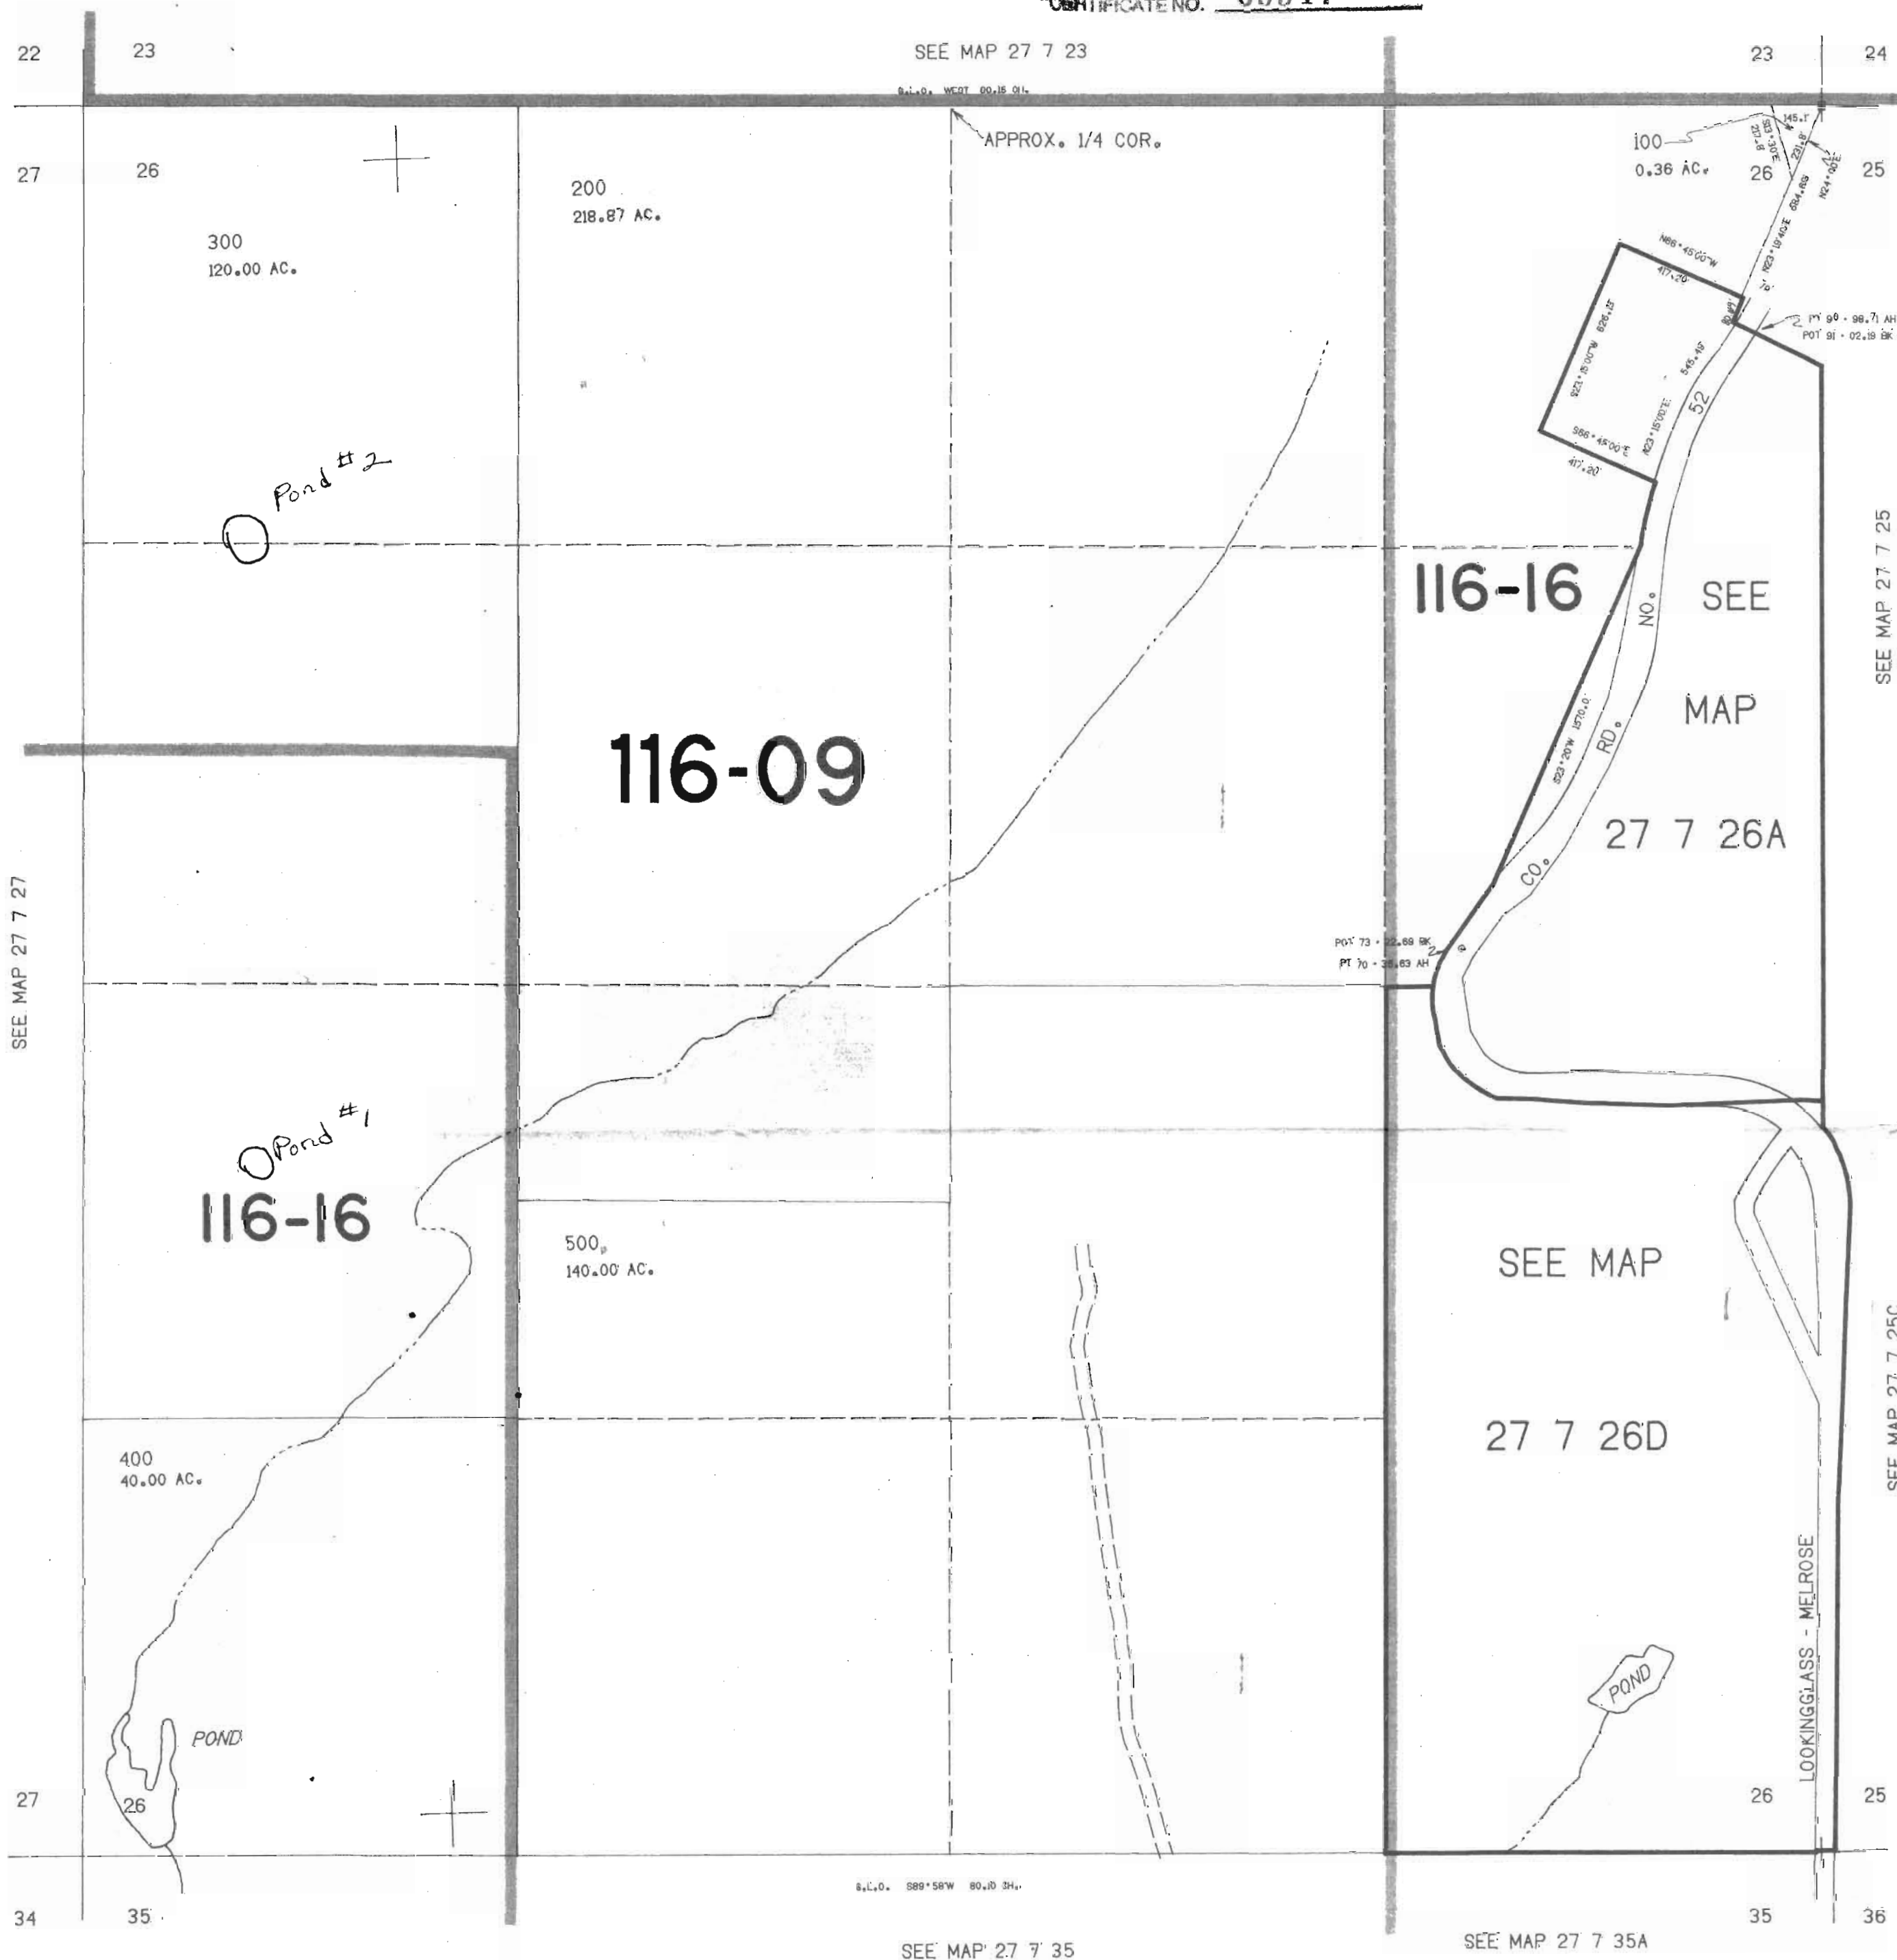

1,200,000

568,000

27 7 26
& INDEX