

SECTION 15 T.29S. R.5W. W.M.
DOUGLAS COUNTY

1" = 400'

REVISED ON
12-8-93

29 5 15

Application No. R-15759
Permit No.

This map was prepared for
assessment purposes only

SEE MAP 29 5 10

CERTIFICATE NO. 69949

10

11

SEE MAP 29 5 14B


SEE MAP 29 5 14

510,000


RECEIVED
DEC 27 1994
WATER RESOURCES DEPT.
SALEM, OREGON

29 5 15

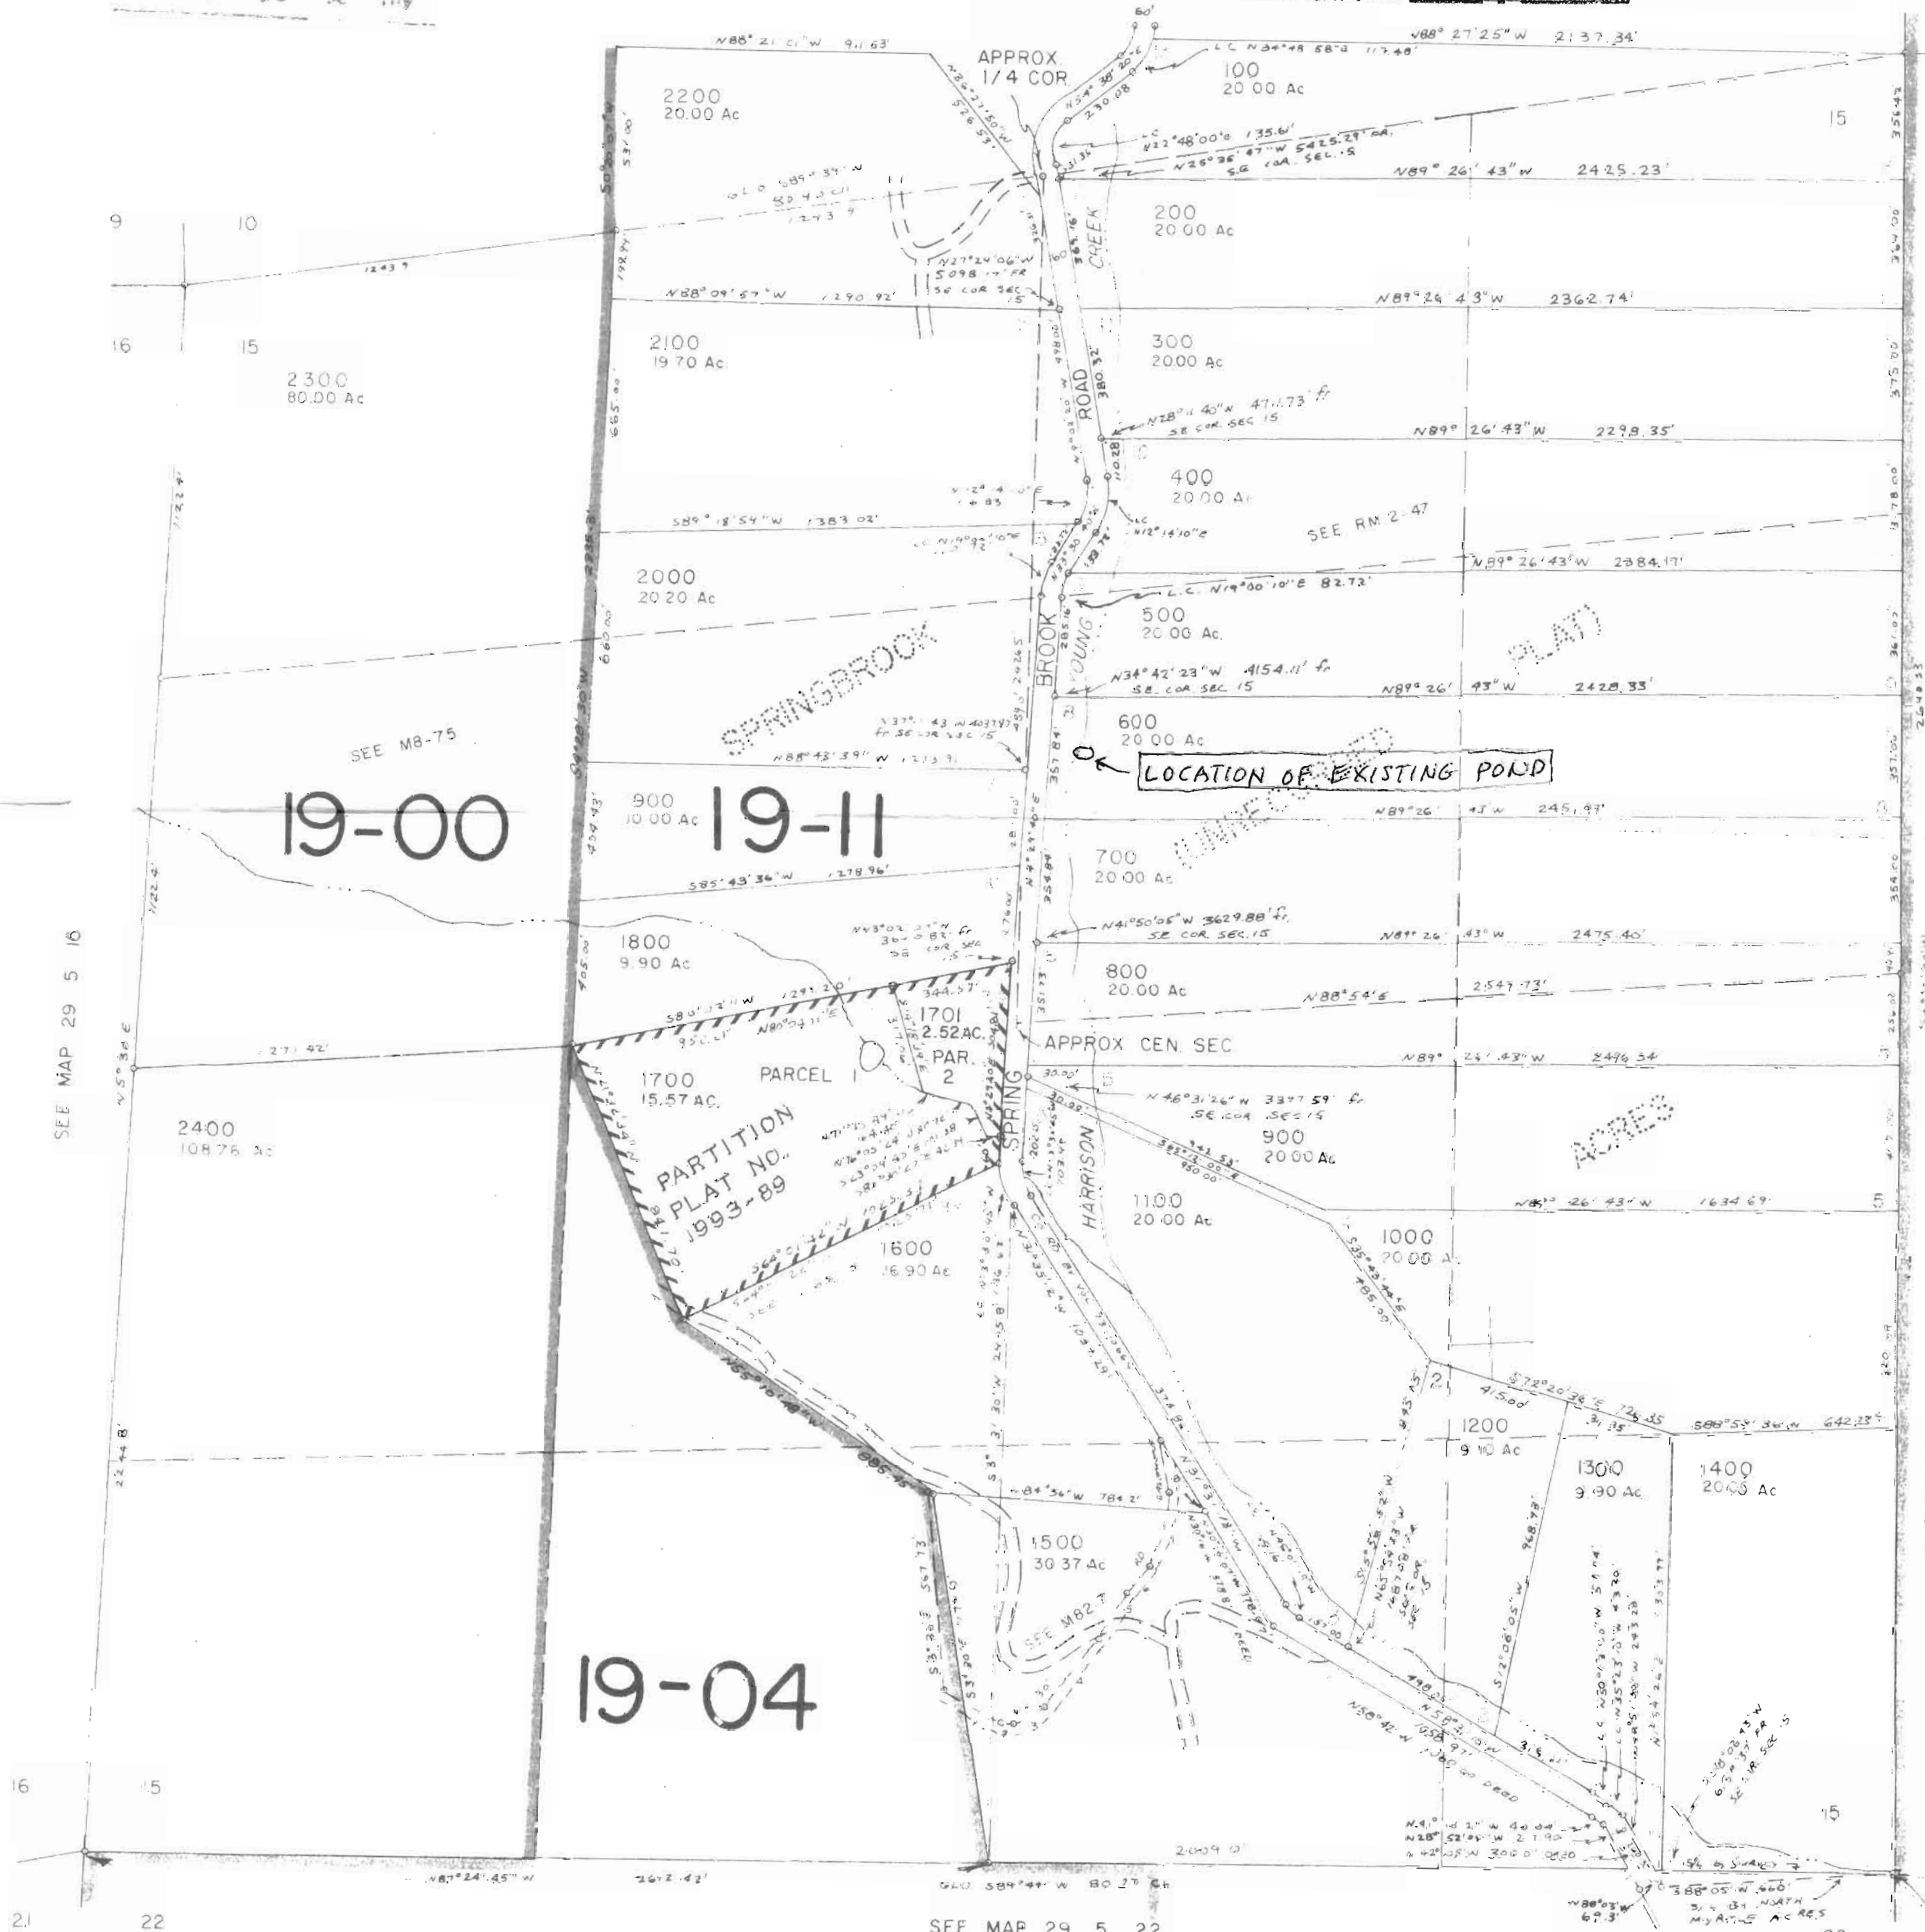

SEE MAP 29 5 22

SEE MAP 29 5 22AA

1,260,000