

SECTION 30 T.27S. R.4W. W.M.
DOUGLAS COUNTY

REVISED ON
9-10-93

27 4 30

THIS MAP WAS PREPARED FOR
ASSESSMENT PURPOSE ONLY.


CERTIFICATE NO. ~~69952~~

Application No. R-75942
Permit No.

CANCELLED NO.S
801

1"=400'

SEE MAP 27 4 19

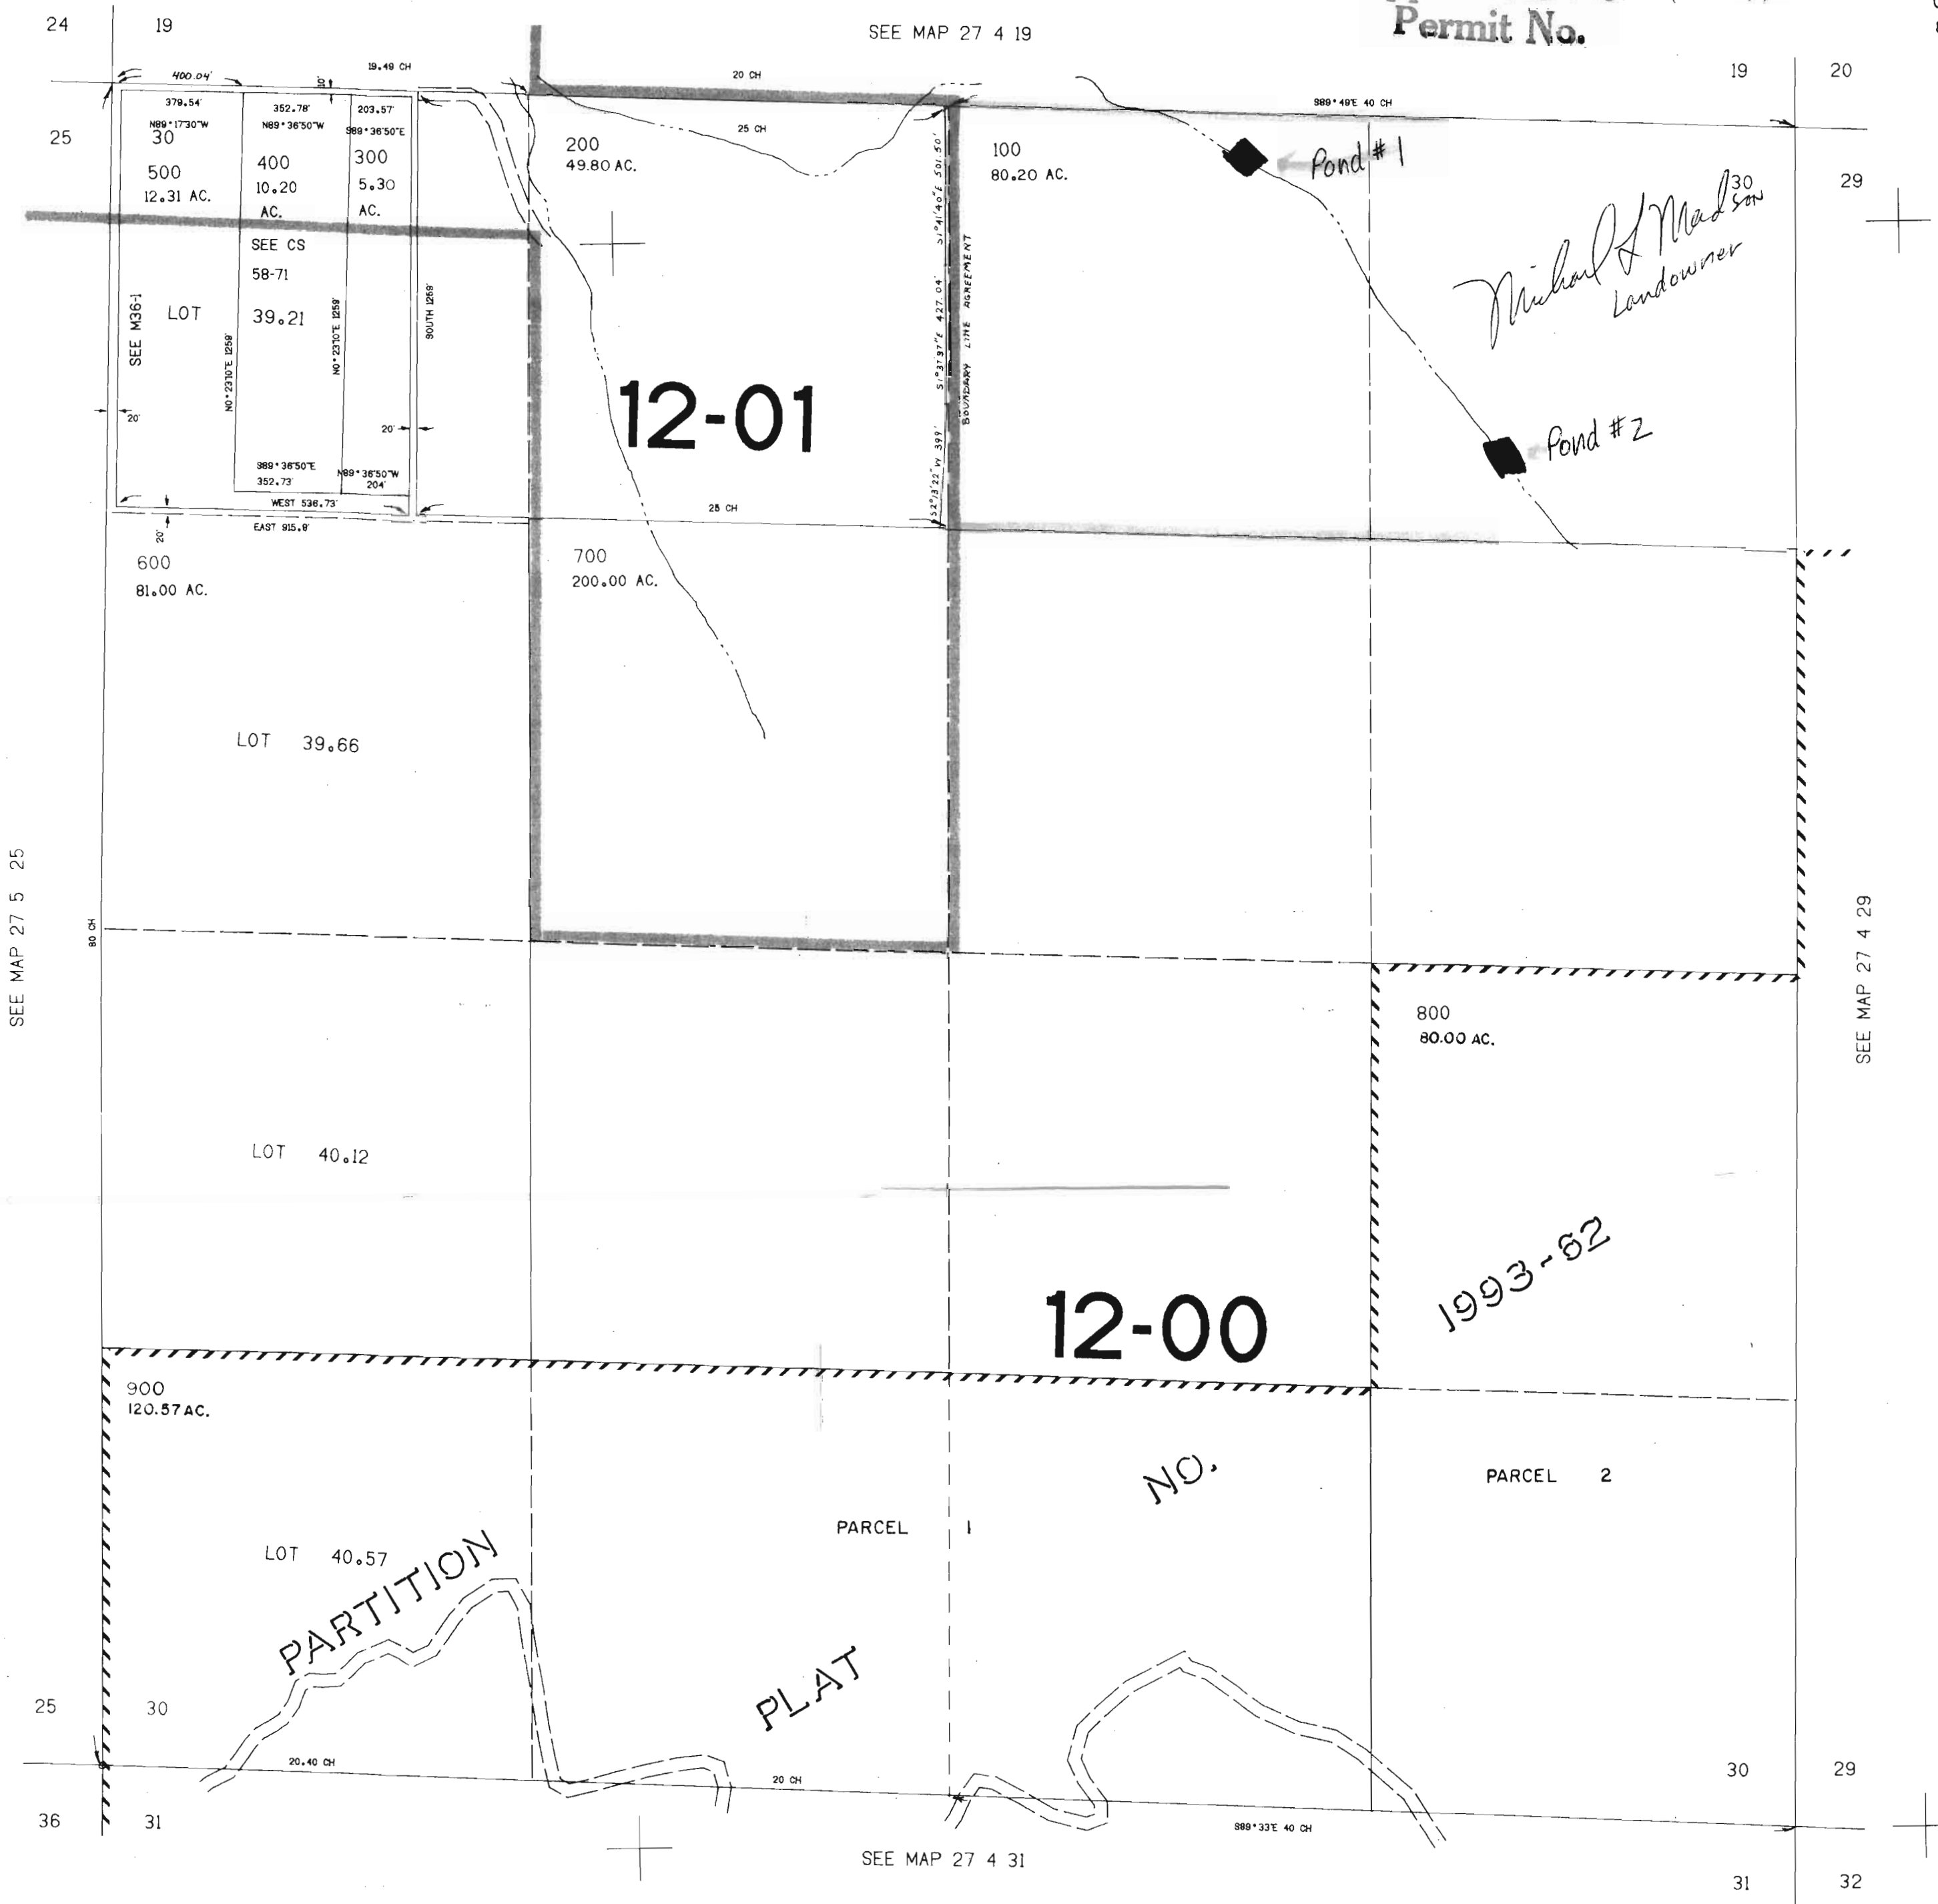

12-01

12-00

PARTITION

PLAT

1993-62

PARCEL 2

PARCEL 1

NO.

SEE MAP 27 5 25

SEE MAP 27 4 29

SEE MAP 27 4 31

565.000

1.275.000

27 4 30