

69961

CERTIFICATE NO.

WEST HORSEHEAD RESERVOIR
T. 28 S., R. 25 E., SECTION 8 SENE
QUAD SHEET: LITTLE JUNIPER MTN.

RECEIVED

DEC 27 1994

WATERLOO
SALEM, OREGON

T28S

Little Ju
Juniper
MTN.
Oregon

Application No. 75971
Permit No.


Scale 1:24,000

ROAD LEGEND

Improved Road.....
Unimproved Road.....
Trail.....
U.S. Route
State Route

QUADRANGLE LOCATION

1 2 3 1 Wagonire Mtn. West

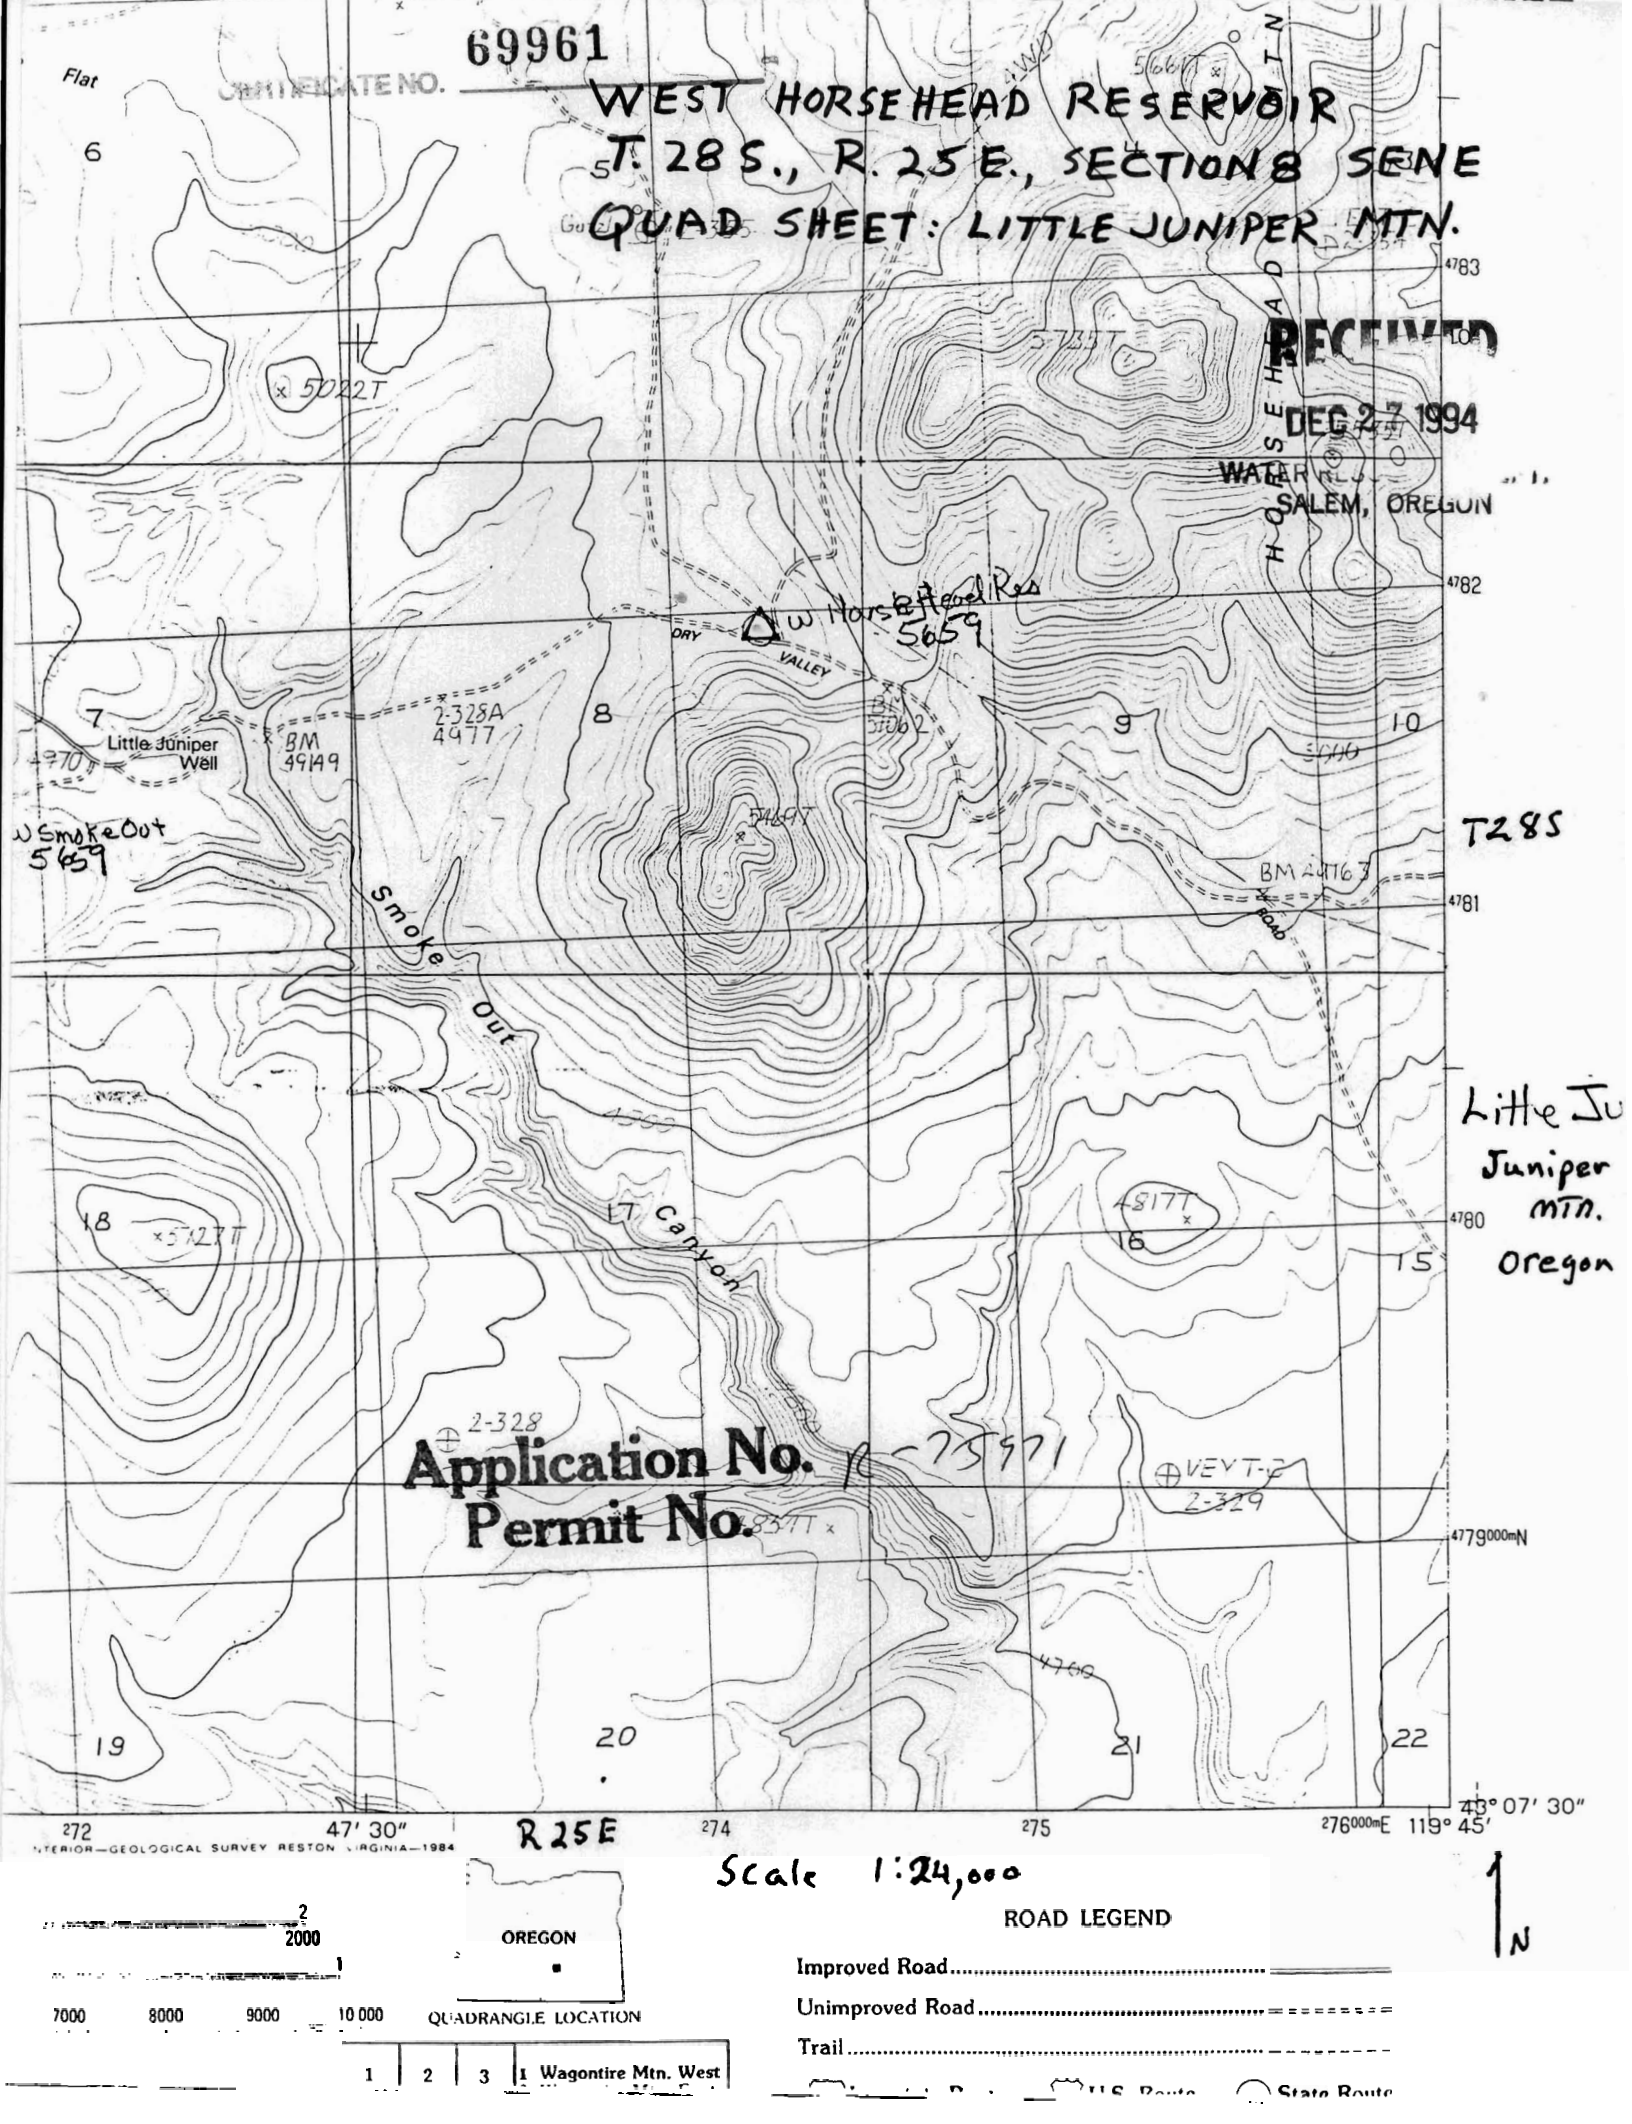

CERTIFICATE NO.

69961

2-355

WEST SMOKEOUT RESERVOIR

T. 28 S., R. 25 E., SECTION 7 NESW

QUAD SHEET: LITTLE JUNIPER MTN.

Clear
Waterhole

RECEIVED

DEC 27 1994

WATER RESERVOIR
SALEM, OREGON

Little Juniper
Well

BM
49149

2-328A
4977

8

51062

10

BM 49153

W Smoke Out
5663

Smoke
Out

LT Canyon

48177

T 28 S

Application No.
Permit No.

R 25 E

R 25 E

272 47' 30" 274 275 276 000 E 119° 43'

4 000

1000 2000

000 6000 7000 8000 9000 10 000

QUADRANGLE LOCATION

OREGON

274

Scale 1:24,000

ROAD LEGEND

Improved Road.....

Unimproved Road.....

Trail.....

Interstate Route U.S. Route State Rou.

LITTLE JUNIPER MTN., OREG.

PROVISIONAL EDITION 1984

AL 20 FEET
INTERVAL 10 FEET
THE NEAREST 0.1 FOOT
THE NEAREST FOOT
ultiply by 3.2808
ultiply by 0.3048

1	2	3	1 Wagontire Mtn. West
			2 Wagontire Mtn. East
			3 Alec Butte
4			4 Locust Butte
			5 Goose Egg Butte
			6 Venator Canyon
6	7	8	7 Cox Canyon
			8 Dry Valley Rim

ADJOINING 7.5' QUADRANGLE NAMES

MAP ACCURACY STANDARDS