

QUAD: ROCK CAMP DRAW BRUSHY RESERVOIR T. 30 S., R. 27 E. SECTION 15, SWNW

RECEIVED

DEC 27 1994

WATER RESOURCES DEPT.
SALEM, OREGON

69962

Little

480 000
FEET

Rock
Camp
Draw
Oregon

scale
1:24,000

57'30"

DENIS CABIN 2 MI.


T30s

Application No.
Permit No.

R-25972

Rock Camp
Lake

R 27 E

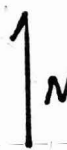

Quad: Cooper Draw

GEORGE RESERVOIR

T. 35 S., R. 23 E.

SECTION 16, NE SE

RECEIVED
DEC 27 1994

U.S. DEPT.
SALEM, OREGON

T35S

Cooper
Draw, Or.

Application No.
Permit No.

R. 23 E.

ROAD CLASSIFICATION

Primary highway, hard surface
Secondary highway, hard surface
Light-duty road, hard or improved surface
Unimproved road
Interstate Route
U. S. Route
State Route

1 MILE

Scale 1:24,000

6000 7000 FEET

1 KILOMETER

U.S. GOVERNMENT PRINTING OFFICE: 1972-486-608/7
745 746000m E.

42° 30'
120° 00'

(PLUSH)
2068 IV NW

QUAD: RABBIT HILLS SW STREET RESERVOIR T. 35 S., R. 23 E. SECTION 23, SW SE

DEC 27 1994

WATER RESOURCES DEPT.
SALEM, OREGON

69962

Application No.
Permit No.


R.23 E

Mapped, edited, and published by the Geological Survey
Control by USGS and USC&GS


Topography by photogrammetric methods from aerial
photographs taken 1964. Field checked 1967

Polyconic projection. 1927 North American datum
10,000-foot grid based on Oregon coordinate system,
south zone
1000-meter Universal Transverse Mercator grid ticks,
zone 11, shown in blue

Fine red dashed lines indicate selected fence lines

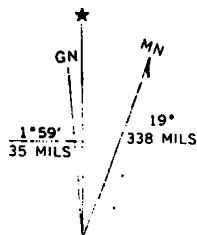

UTM GRID AND 1967 MAGNETIC NORTH
DECLINATION AT CENTER OF SHEET

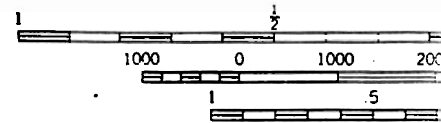

Rabbit Hills, SW, Oregon
Scale 1:24,000
CONTOUR
DOTTED LINES
DATUM

THIS MAP COMPLIES WITH

QUAD: RABBIT HILLS SW
SWAN RESERVOIR
T. 35 S., R. 23 E.
SECTION 25, NENW

DEC 27 1994

WATER
SALEM, OREGON

69962

Application No.
Permit No.

Swan Res
5645

T35S

Draw

254

255

2 140 000 FEET

256

57'30"

R23E

R 23 E

R 24 E (PL)

2068

SCALE

1:24,000

1000 0 1000 2000 3000

GN

MN

Prepared, edited, and published by the Geological Survey
Control by USGS and USC&GS

Topography by photogrammetric methods from aerial
photographs taken 1964. Field checked 1967

Location map
Rabbit Hills SW, Oregon