

N.E. AUGUSTINE RESERVOIR

T. 31 S., R. 28 E.

SECTION 10, NWSE

HARNEY COUNTY,

QUAD: BALLS LAKE

RECEIVED


DEC 27 1994

WATER RESOURCES DIV.
SALEM, OREGON

T. 31 S.

T31S

69965

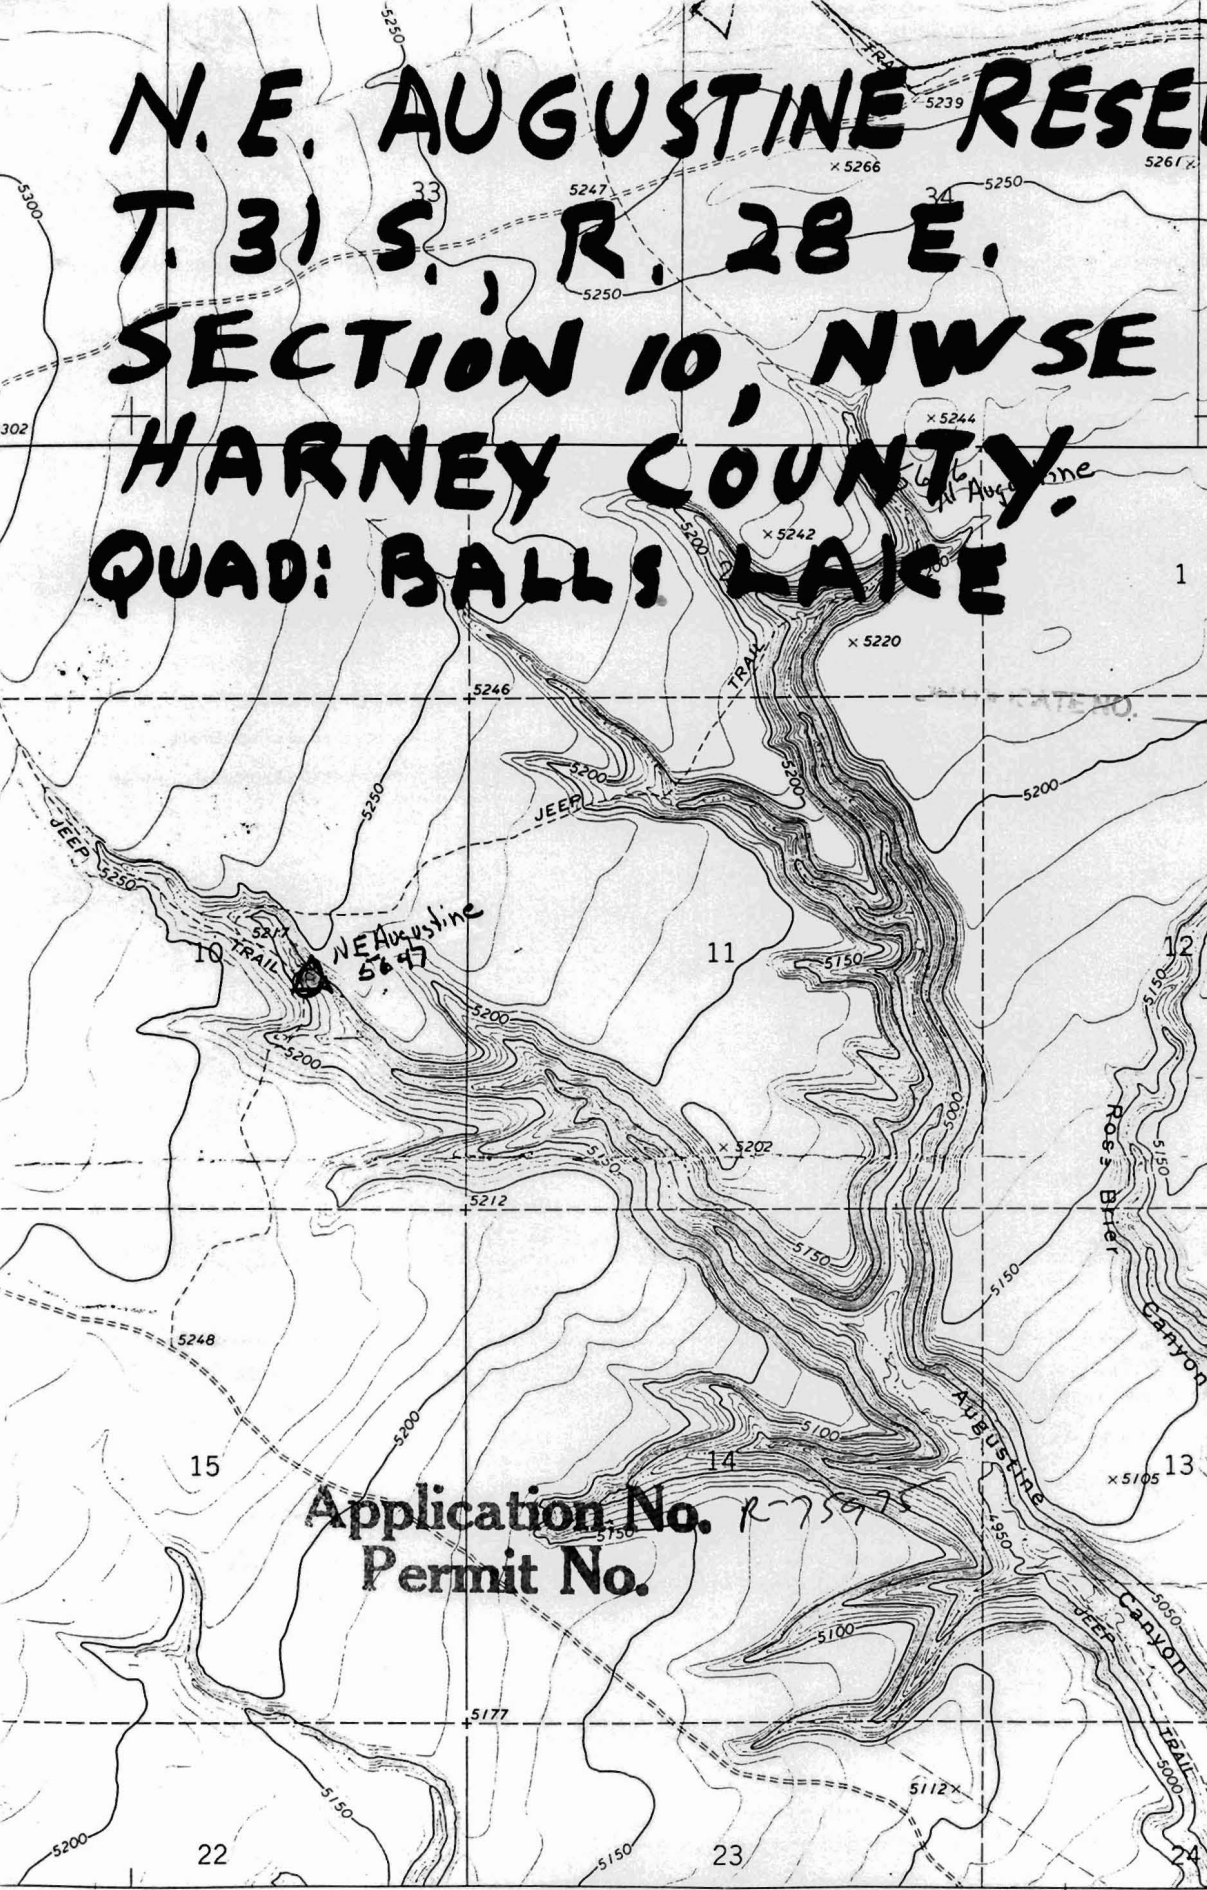

Application No. R-75975
Permit No.

Scale 1:24,000

Balls Lake, Oreg.

1 MILE
FEET

R28E

INTERIOR—GEOLOGICAL SURVEY, WASHINGTON, D.C.—1974
3050000 E.

ROAD CLASSIFICATION

- | | |
|------------------------------------|--|
| Primary highway,
hard surface | Light-duty road, hard or
improved surface |
| Secondary highway,
hard surface | Unimproved road |

DUHAIME FLAT W
2169 N SE

NORTH AUGUSTINE RESERVOIR

T. 31 S., R. 28 E.

SECTION 2 NENE

HARNEY COUNTY

QUAD: BALLS LAKE

Lake in the Brush

RECEIVED

DEC 27 1994

WATER RESOURCES
SALEM, OREGON

69965

5646 N Augustine

Application No. R-15975
Permit No.

R28E

Balls Lake, Oregon

Scale 1:24000

INTERIOR—GEOLOGICAL SURVEY, WASHINGTON, D.C.—1974

42° 52' 30" N
119° 22' 30" W