


FIRM MAP
WETLAND

40c

SECTION 2 T.15S. R.10E.W.M.
DESCHUTES COUNTY


1"=400'

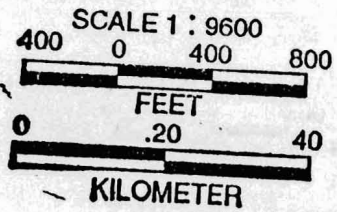

15 10 2

See Map 14 10 35C

See Map 14 10 35

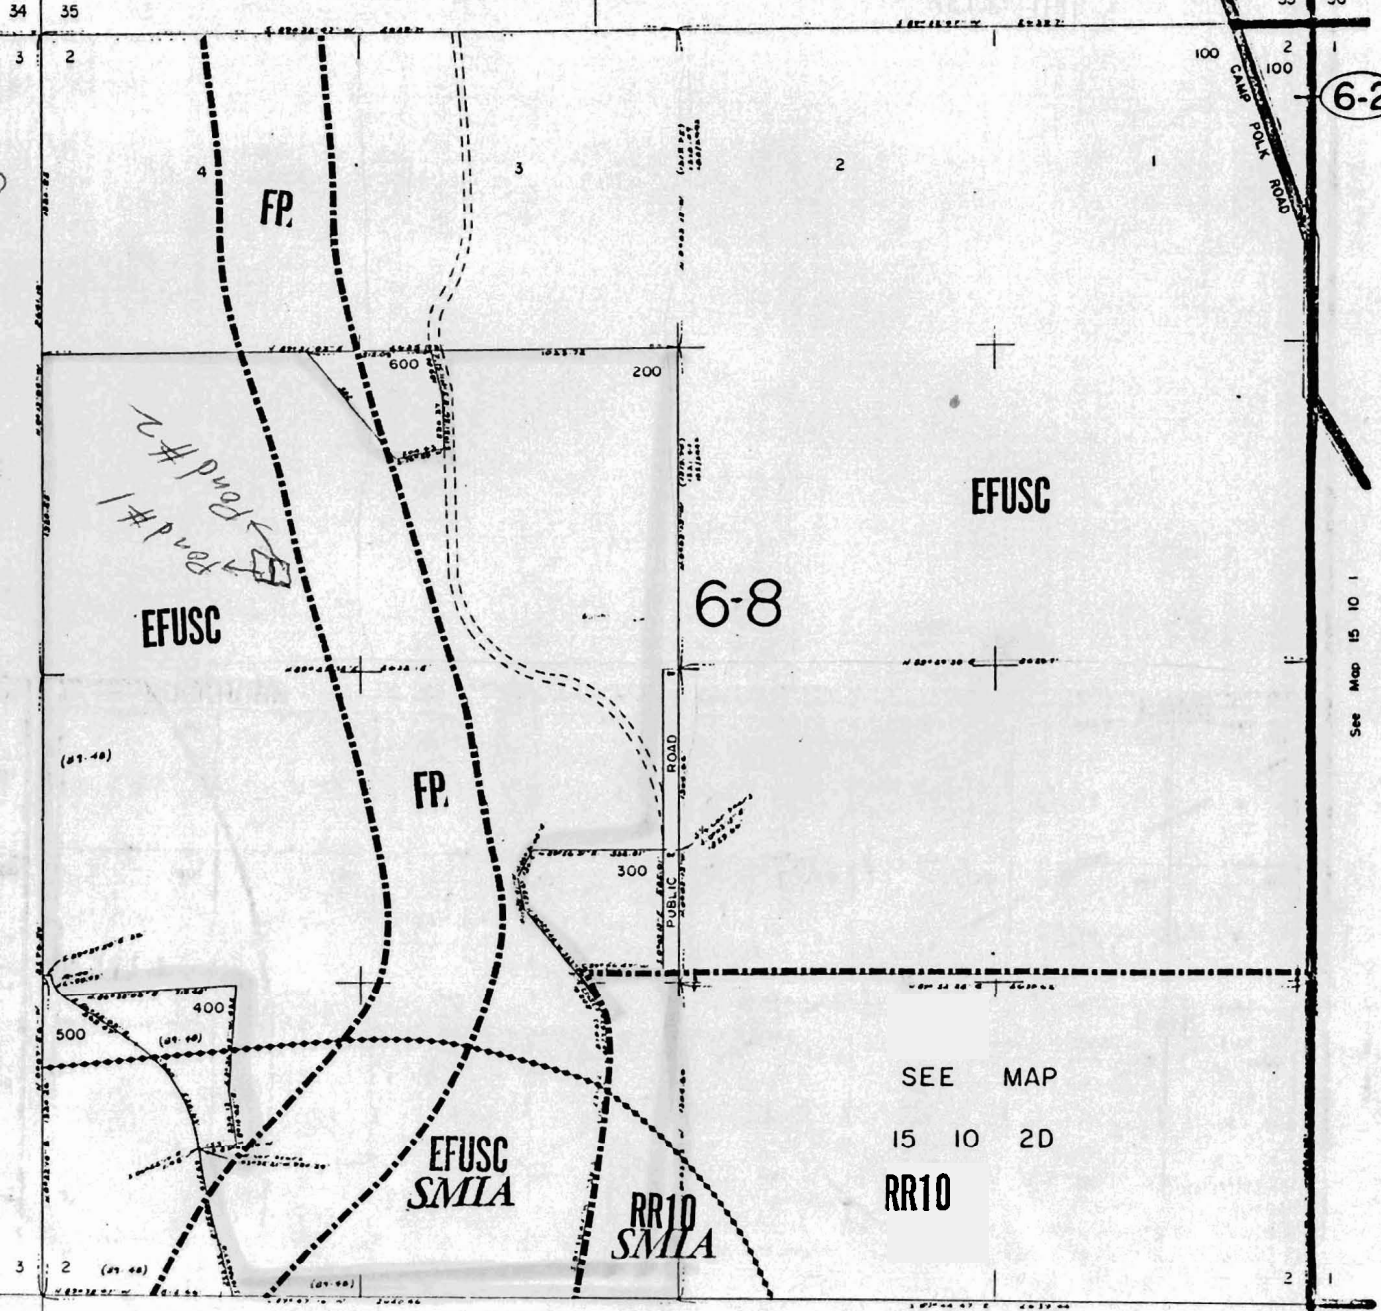

Tax Lot #
15-10-02-200

69966