


Application No. R-75977  
Permit No.

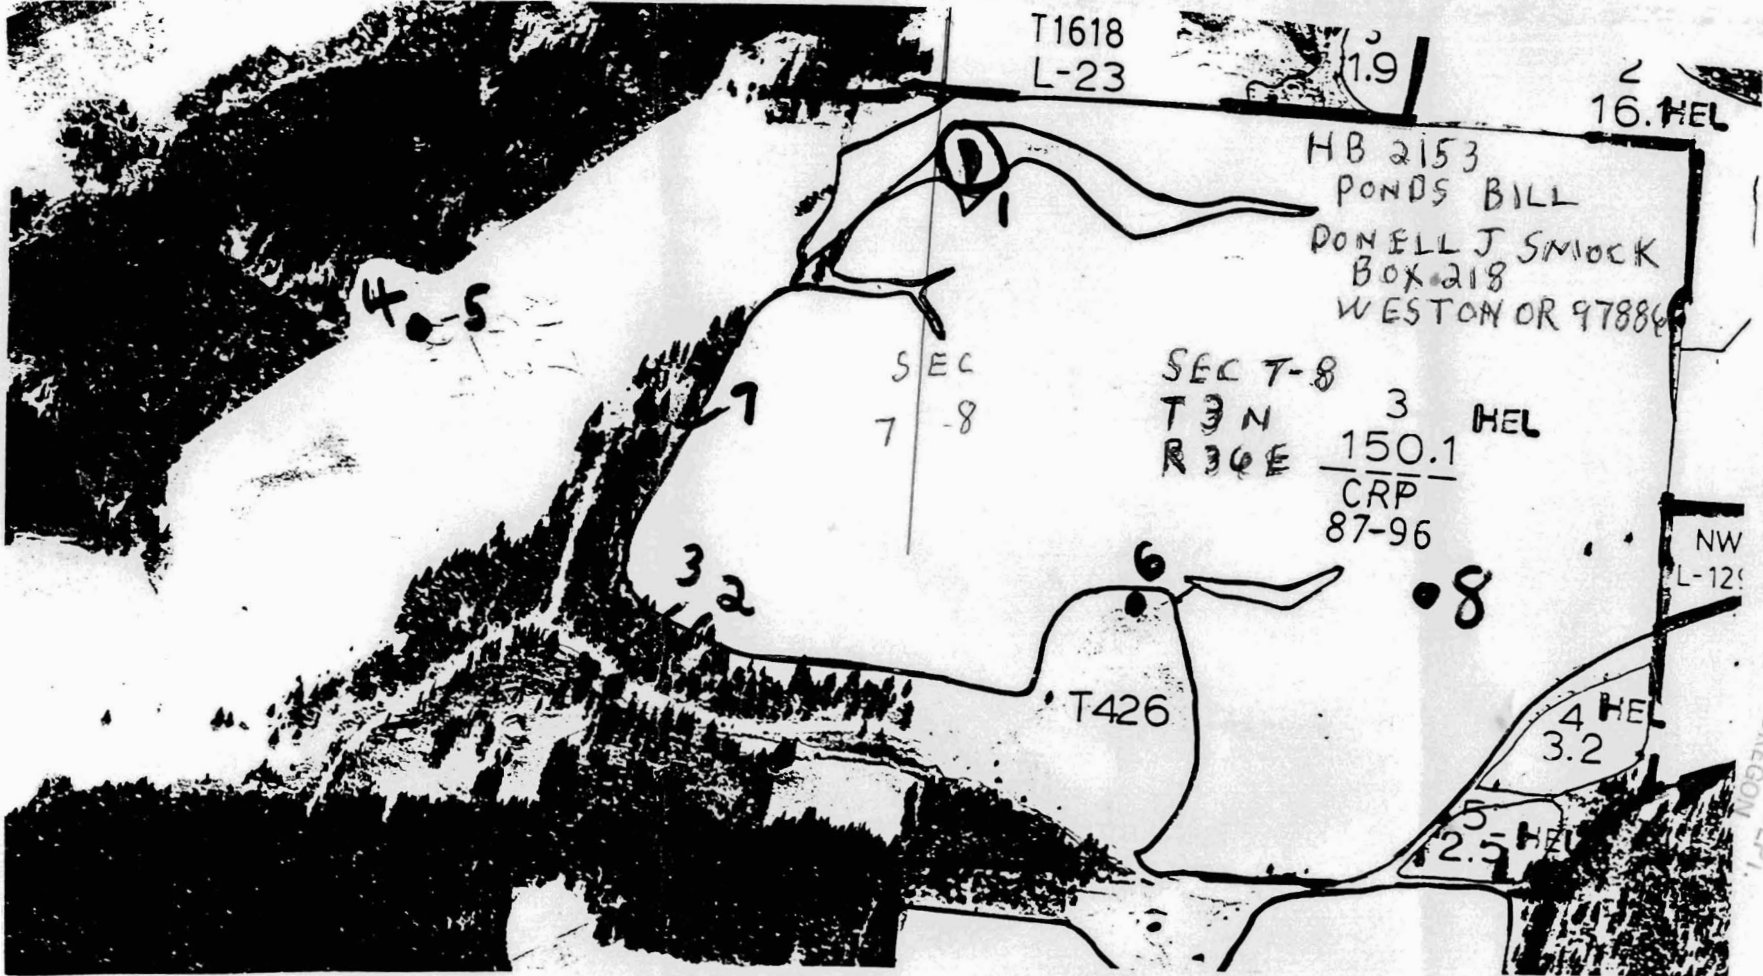

CERTIFICATE NO.

69967

RECEIVED  
DEC 23 1994  
SALEM, OREGON