


Application No. **R-150993**
 Permit No.

Pond #2

PRODUCED BY THE UNITED STATES GEOLOGICAL SURVEY
 CONTROL BY USGS, NOS/NOAA
 COMPILED FROM AERIAL PHOTOGRAPHS TAKEN 1982
 FIELD CHECKED 1984. MAP EDITED 1987
 PROJECTION LAMBERT CONFORMAL CONIC

CERTIFICATE NO. **69982**

SCALE 1:24 000

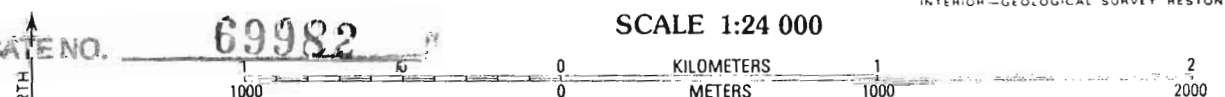

INTERIOR - GEOLOGICAL SURVEY RESTON, VA