


Application No. R-75994
Permit N

"CERTIFICATE NO. 69986"

13-11 AND OR 13-14

SEE MAP
2N 3 19

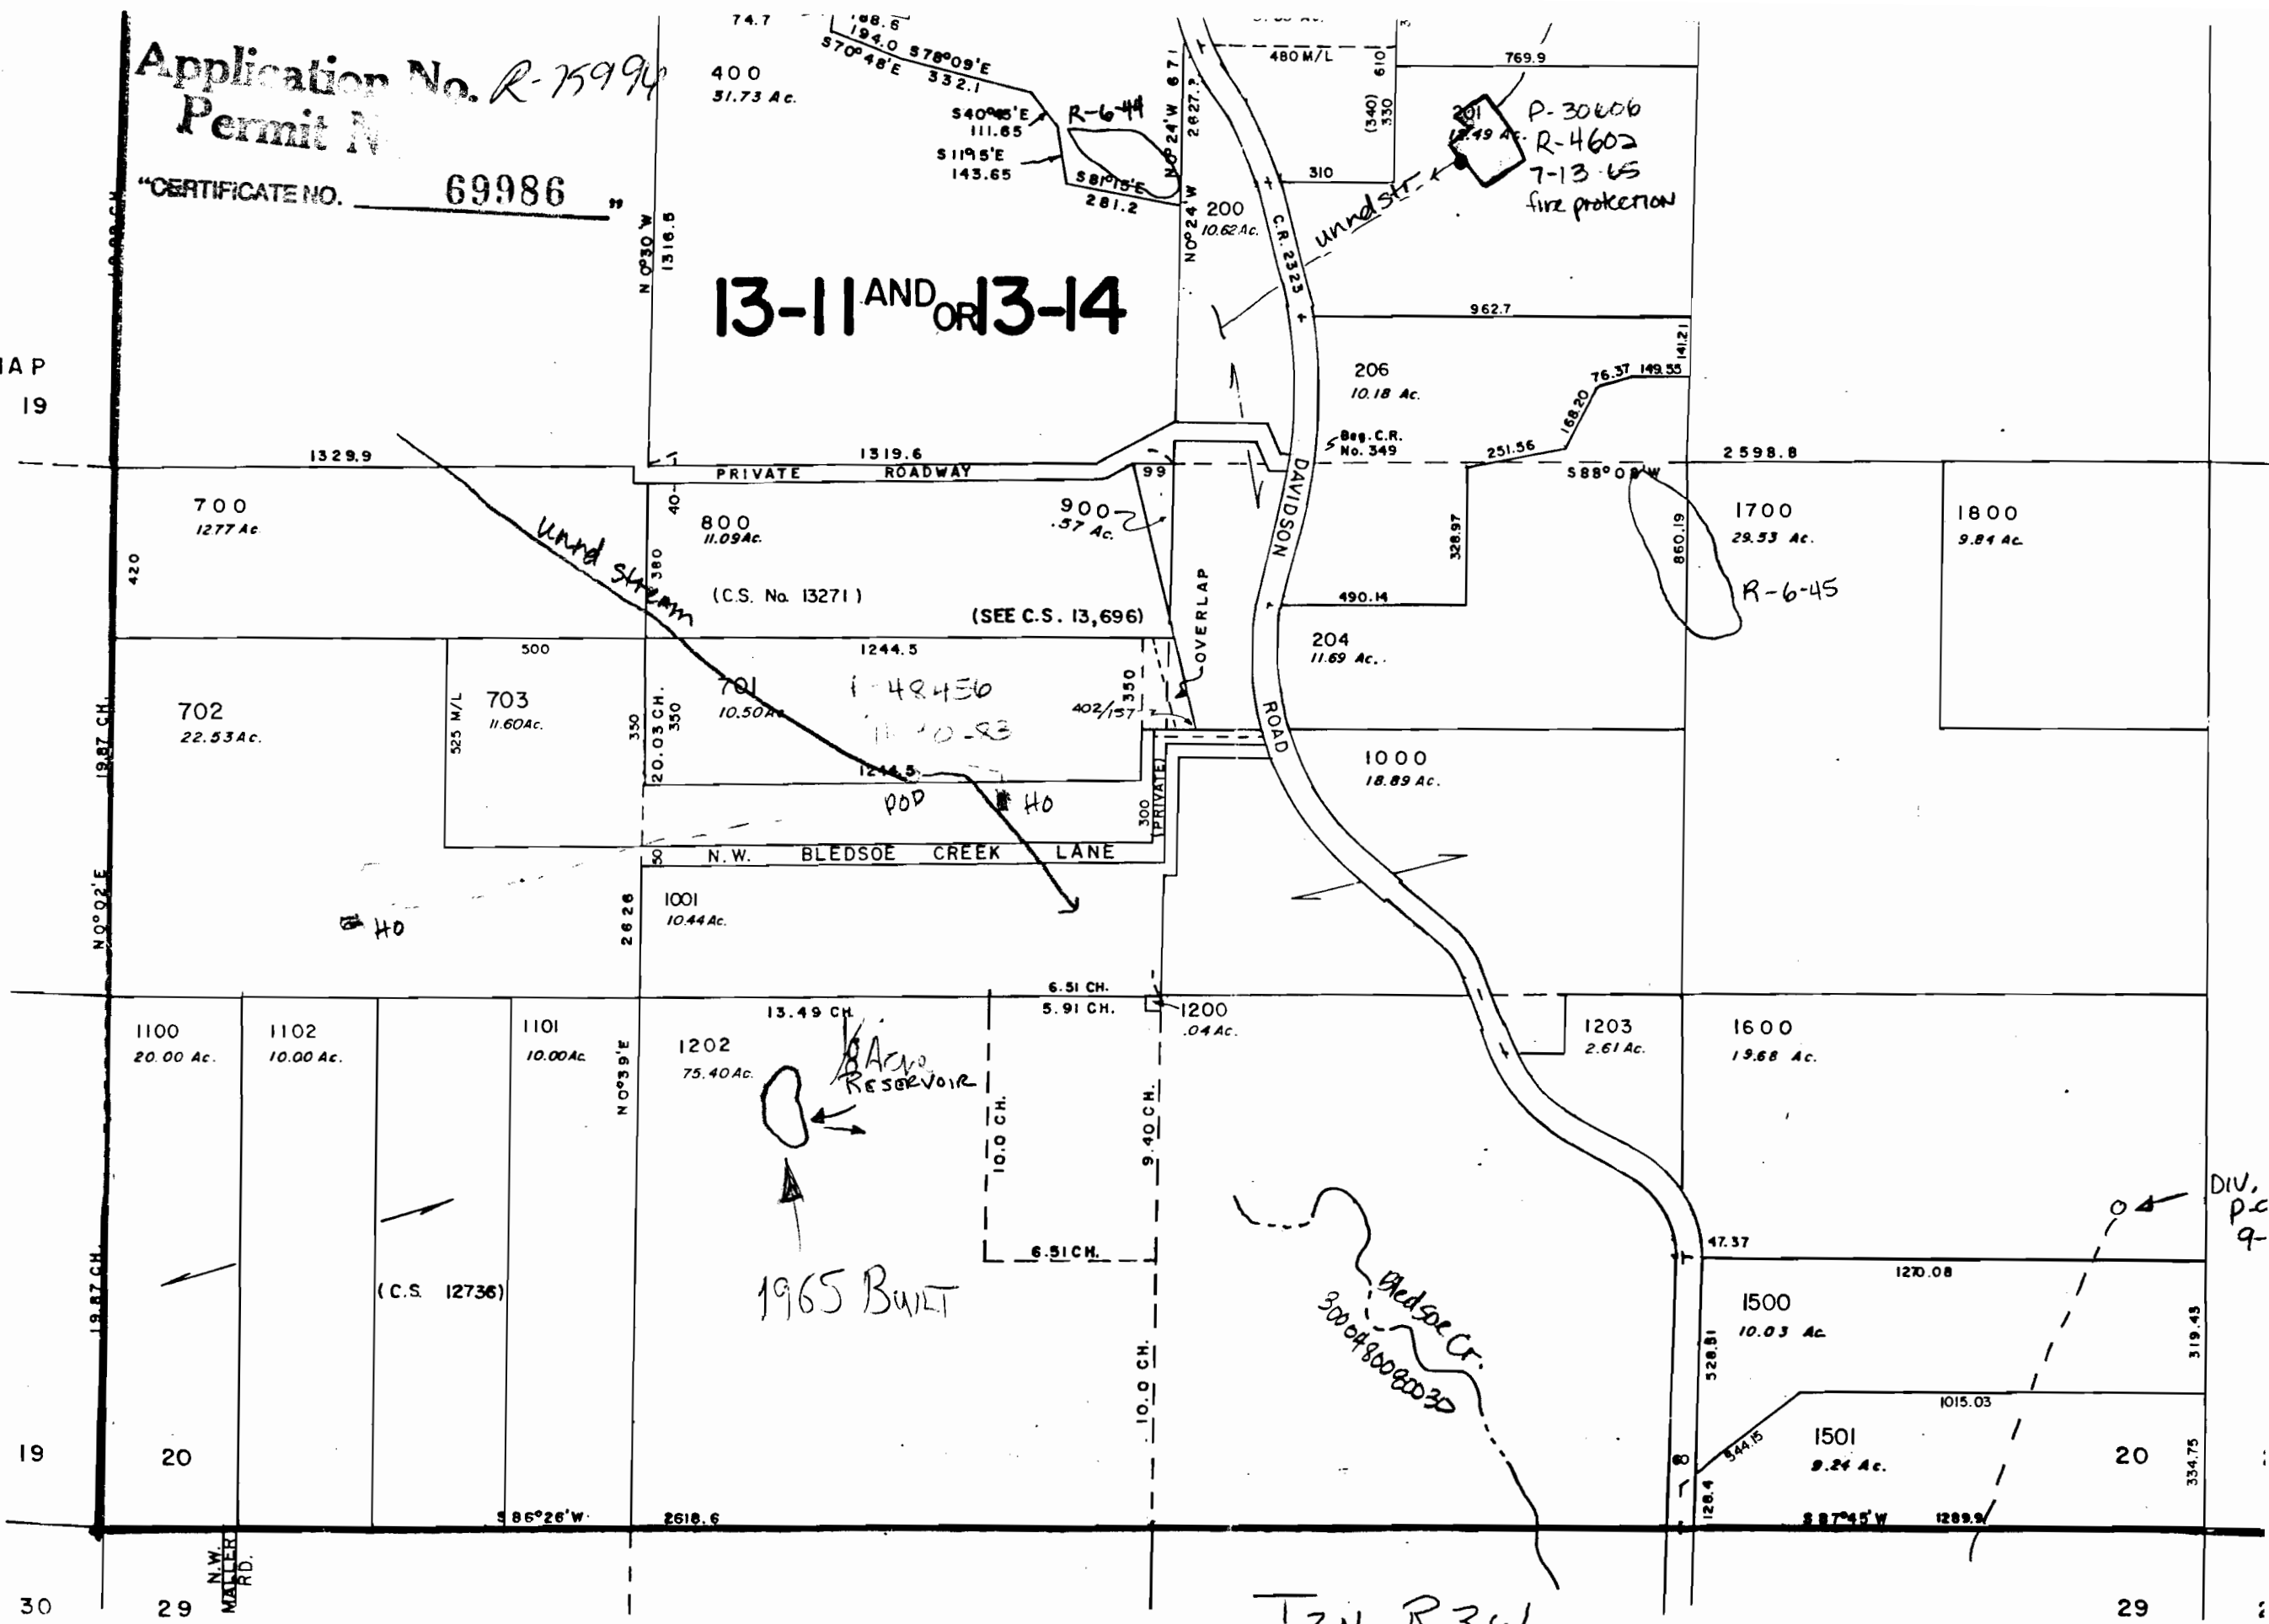

SEE MAP
2N 3 29

T2N R3W