

Application No. *R-76004*
Permit No. **69994**

RECEIVED

NEWBERG QUADRANGLE
OREGON


1970
1474 IV NE
(BEAVERTON)
60

7.5 MINUTE SERIES (TOPOGRAPHIC)

CERTIFICATE NO. **69994**

SW/4 BEAVERTON 15' QUADRANGLE

506 55' 1 380 000 FEET 508 509 122° 52' 30" 45° 22' 30"

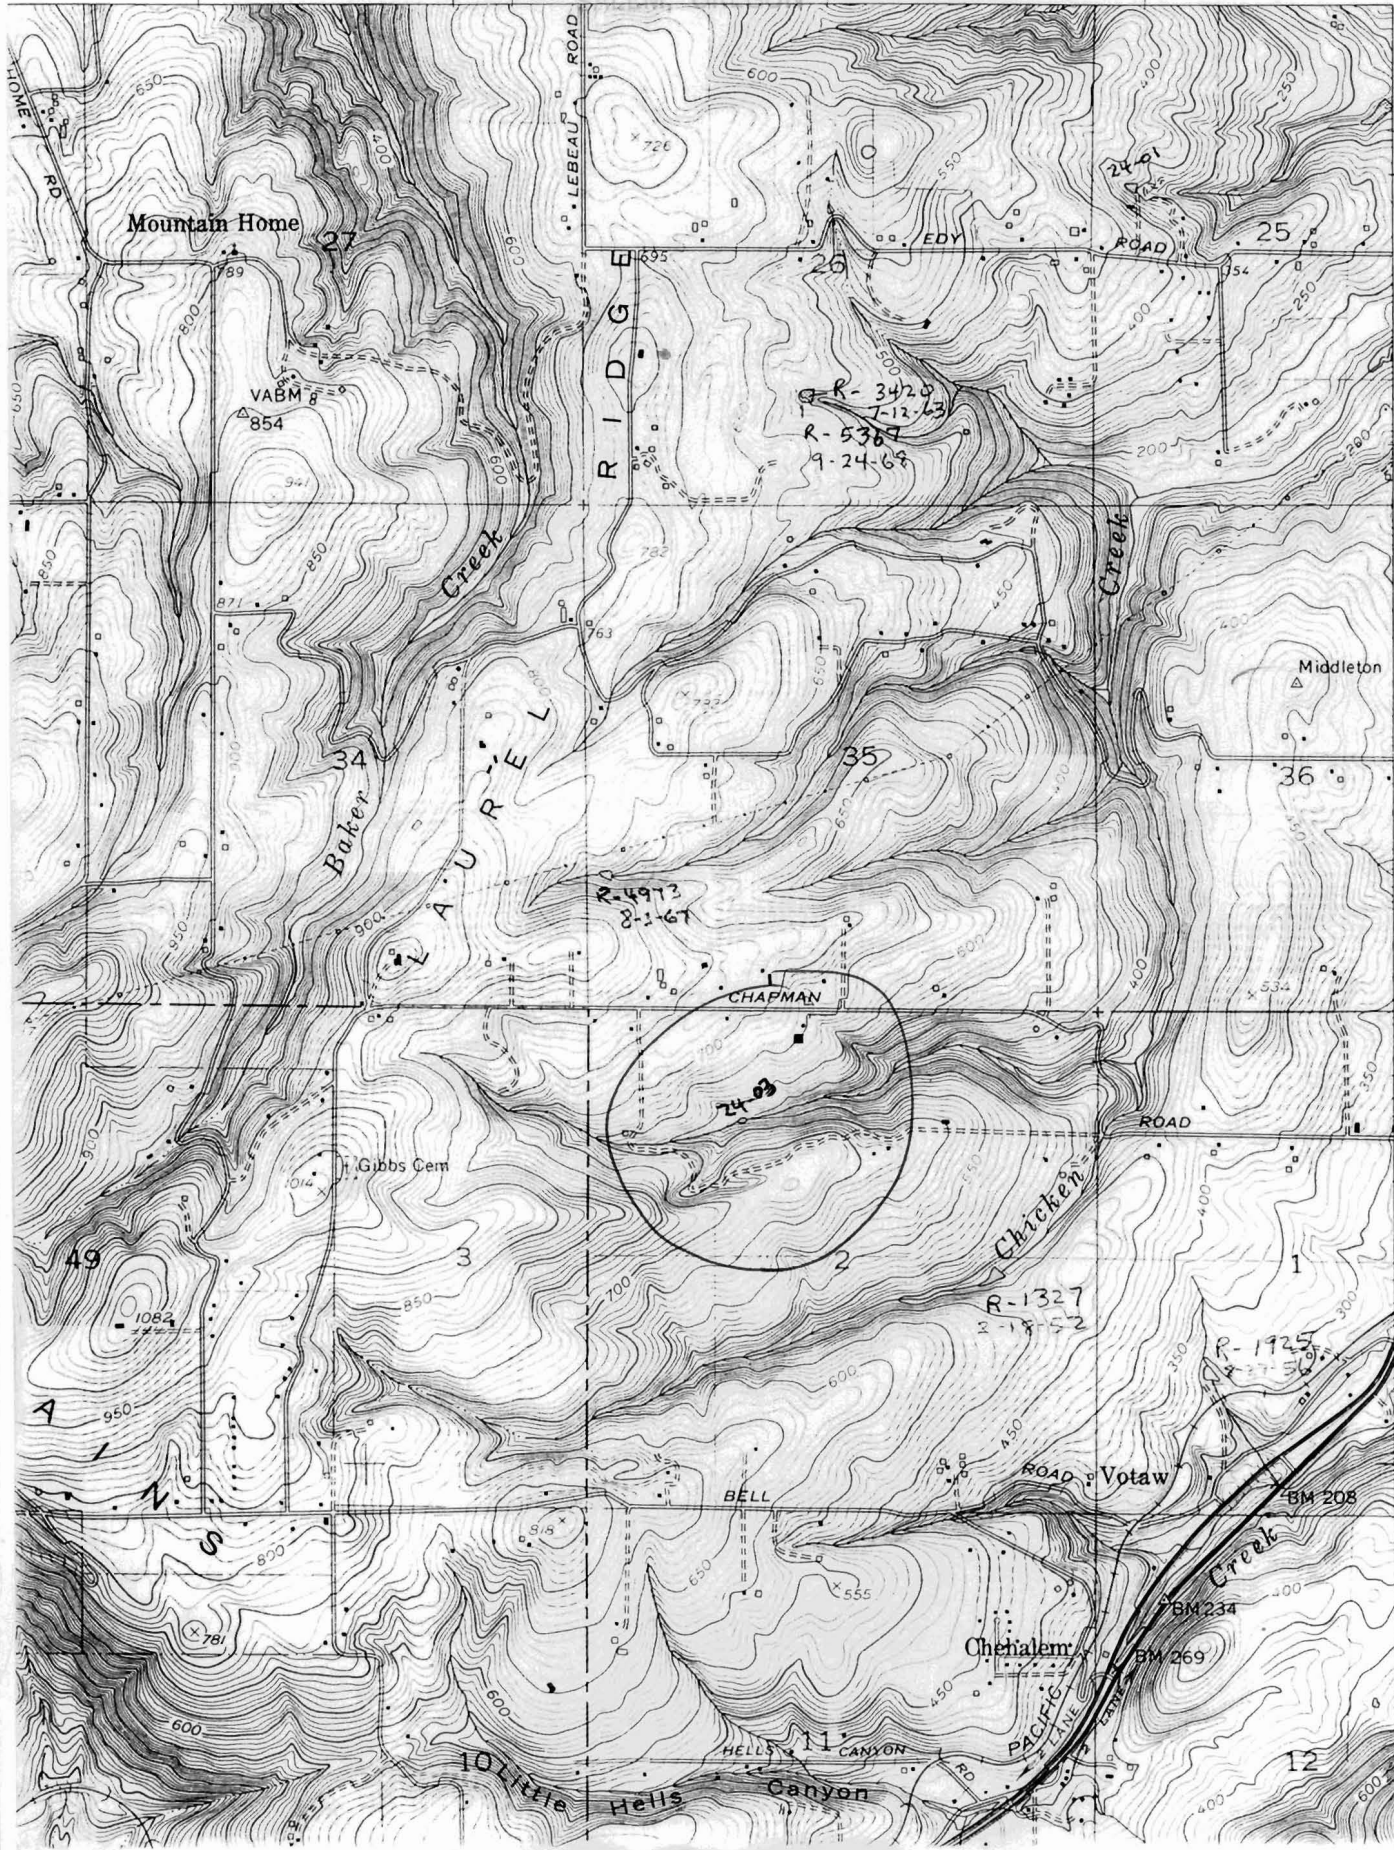

R-5349
5024 8-20-68

630 000
FEET

T. 2 S.
T. 3 S.

5021
SIX CORNERS 2.5 MI.
PORTLAND 18 MI

20'

5019