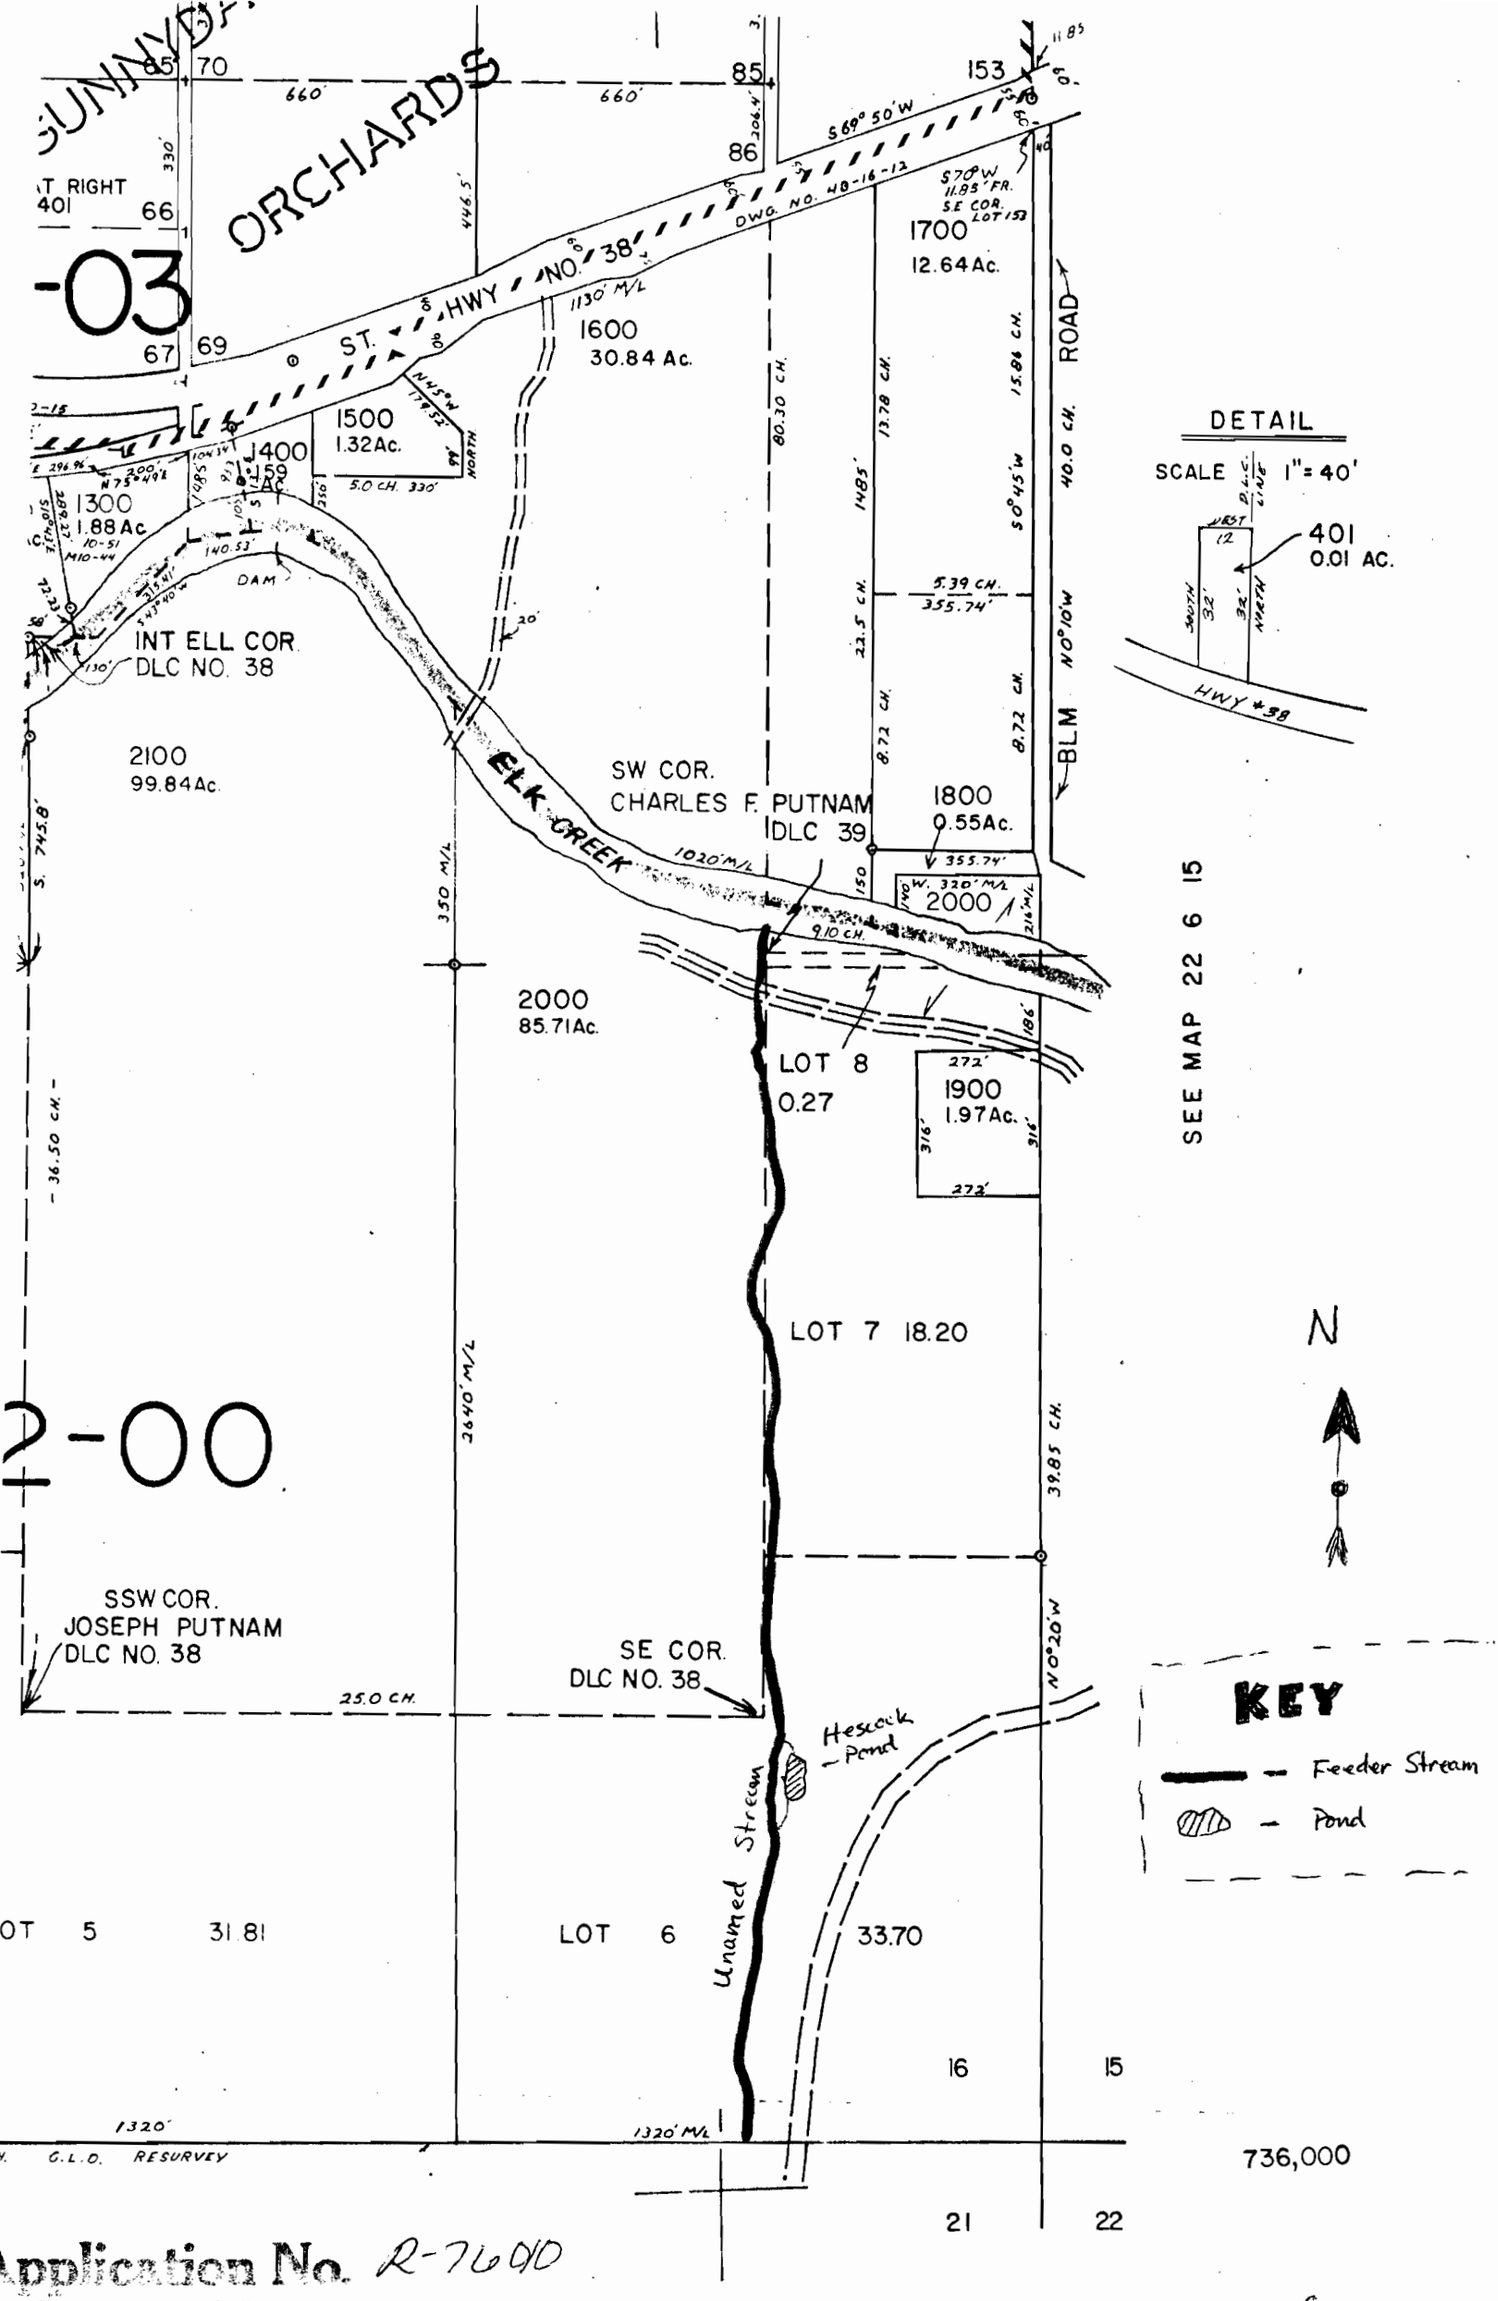

Application No. R-76010
Permit No.

CERTIFICATE NO. 70000

22 S 6 W 16
TL 2000