



LAKE

SCALE 1:48000

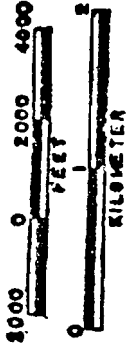

37 20

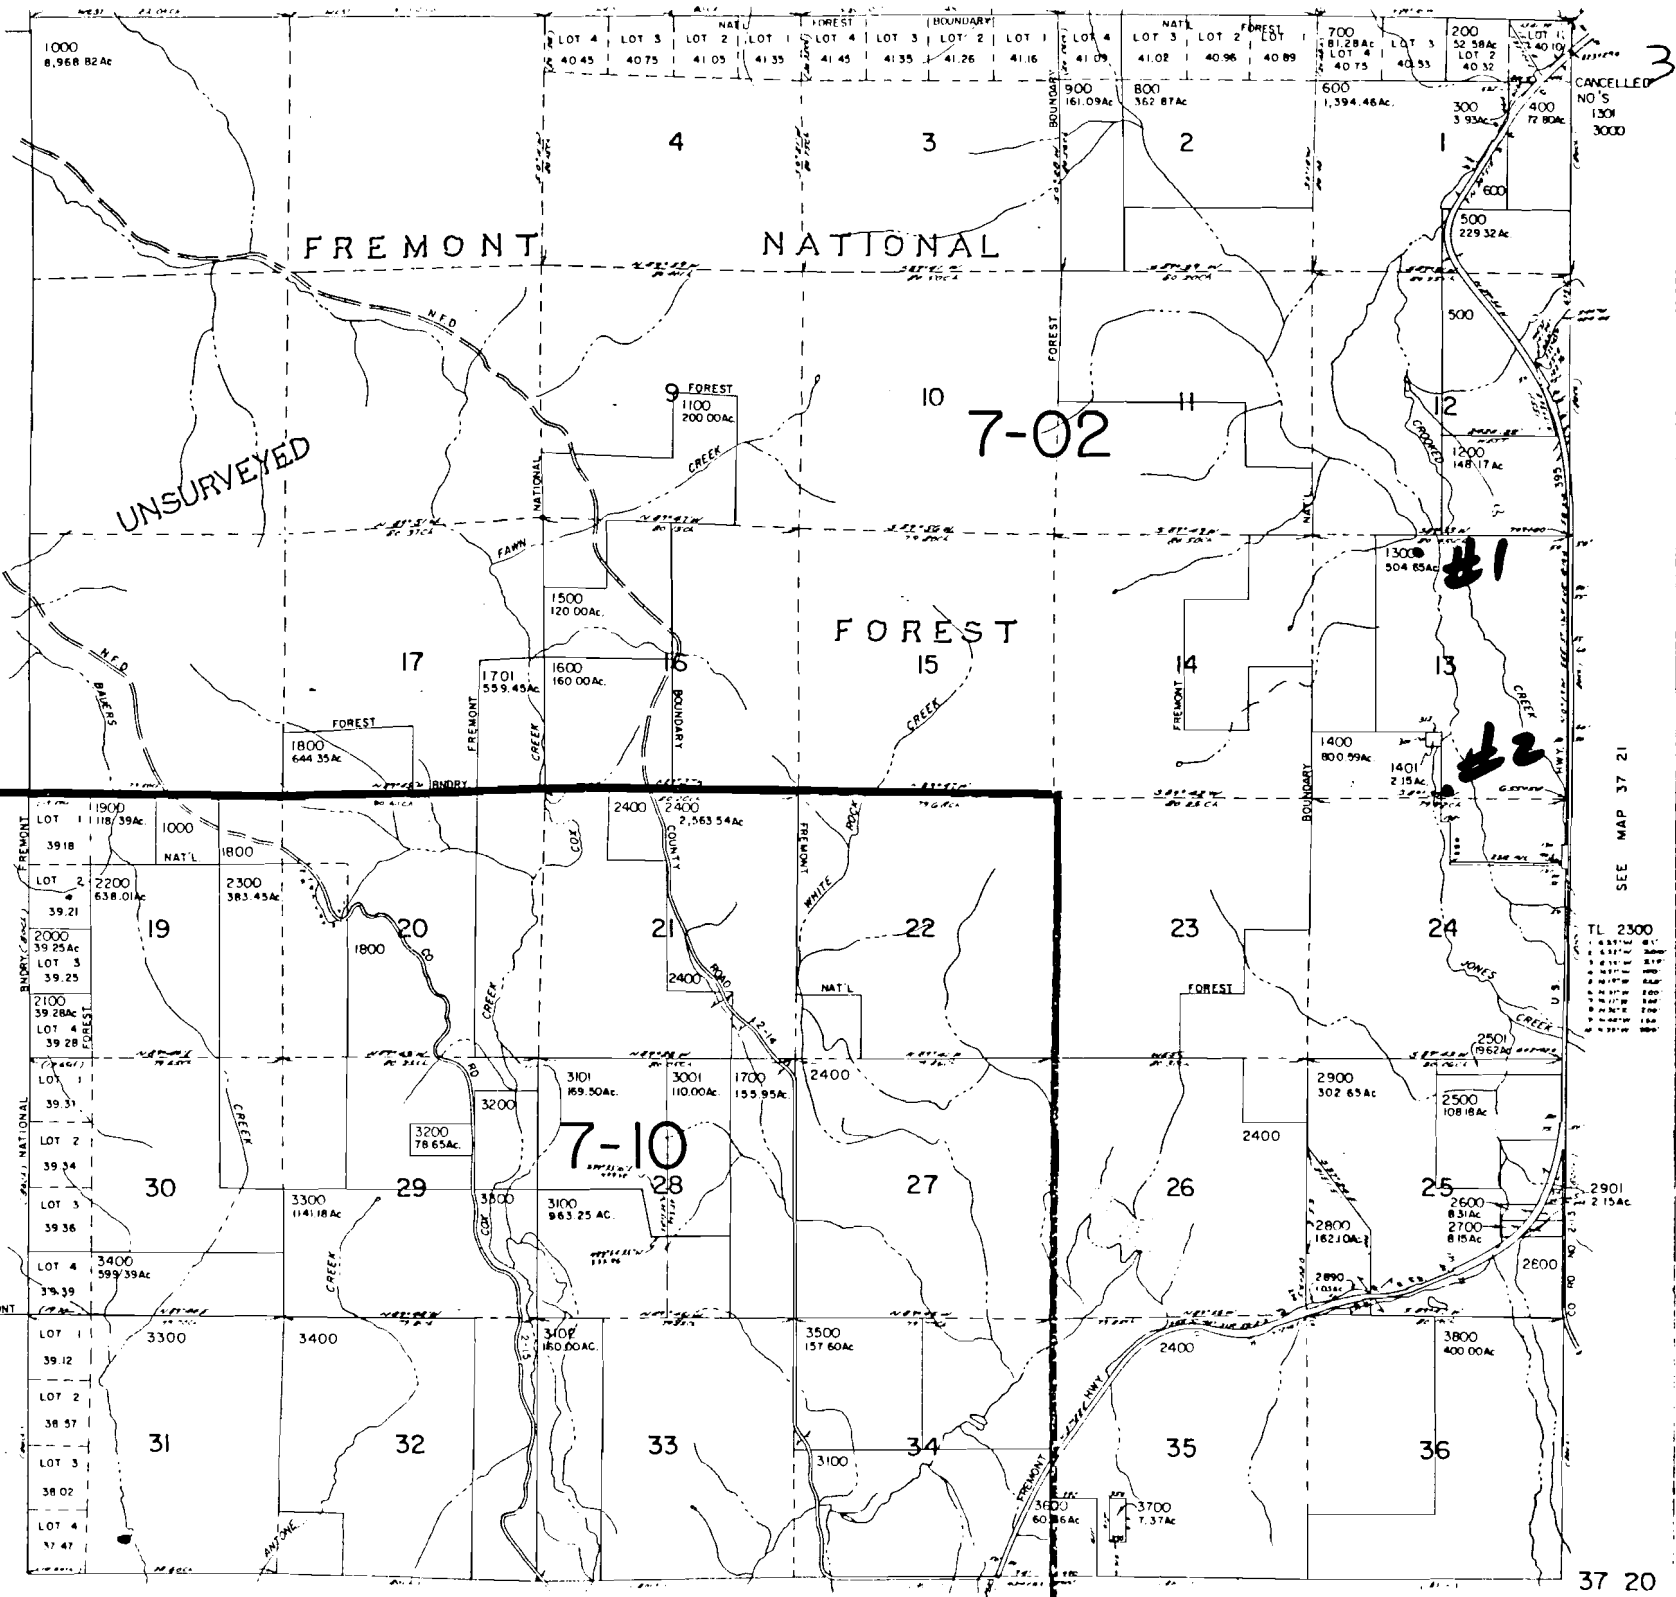

CANCELED NO'S 1301, 1301, 3000

TL 2300

37 20

CERTIFICATE NO. 70001

APPLICANT R-70001

SEE MAP 37 19

SEE MAP 37 21