


RECEIVED

DEC 27 1994

WATER RESOURCES DEPT.
SALEM, OREGON

Application No. R-70012
Permit No.

CERTIFICATE NO. 70002

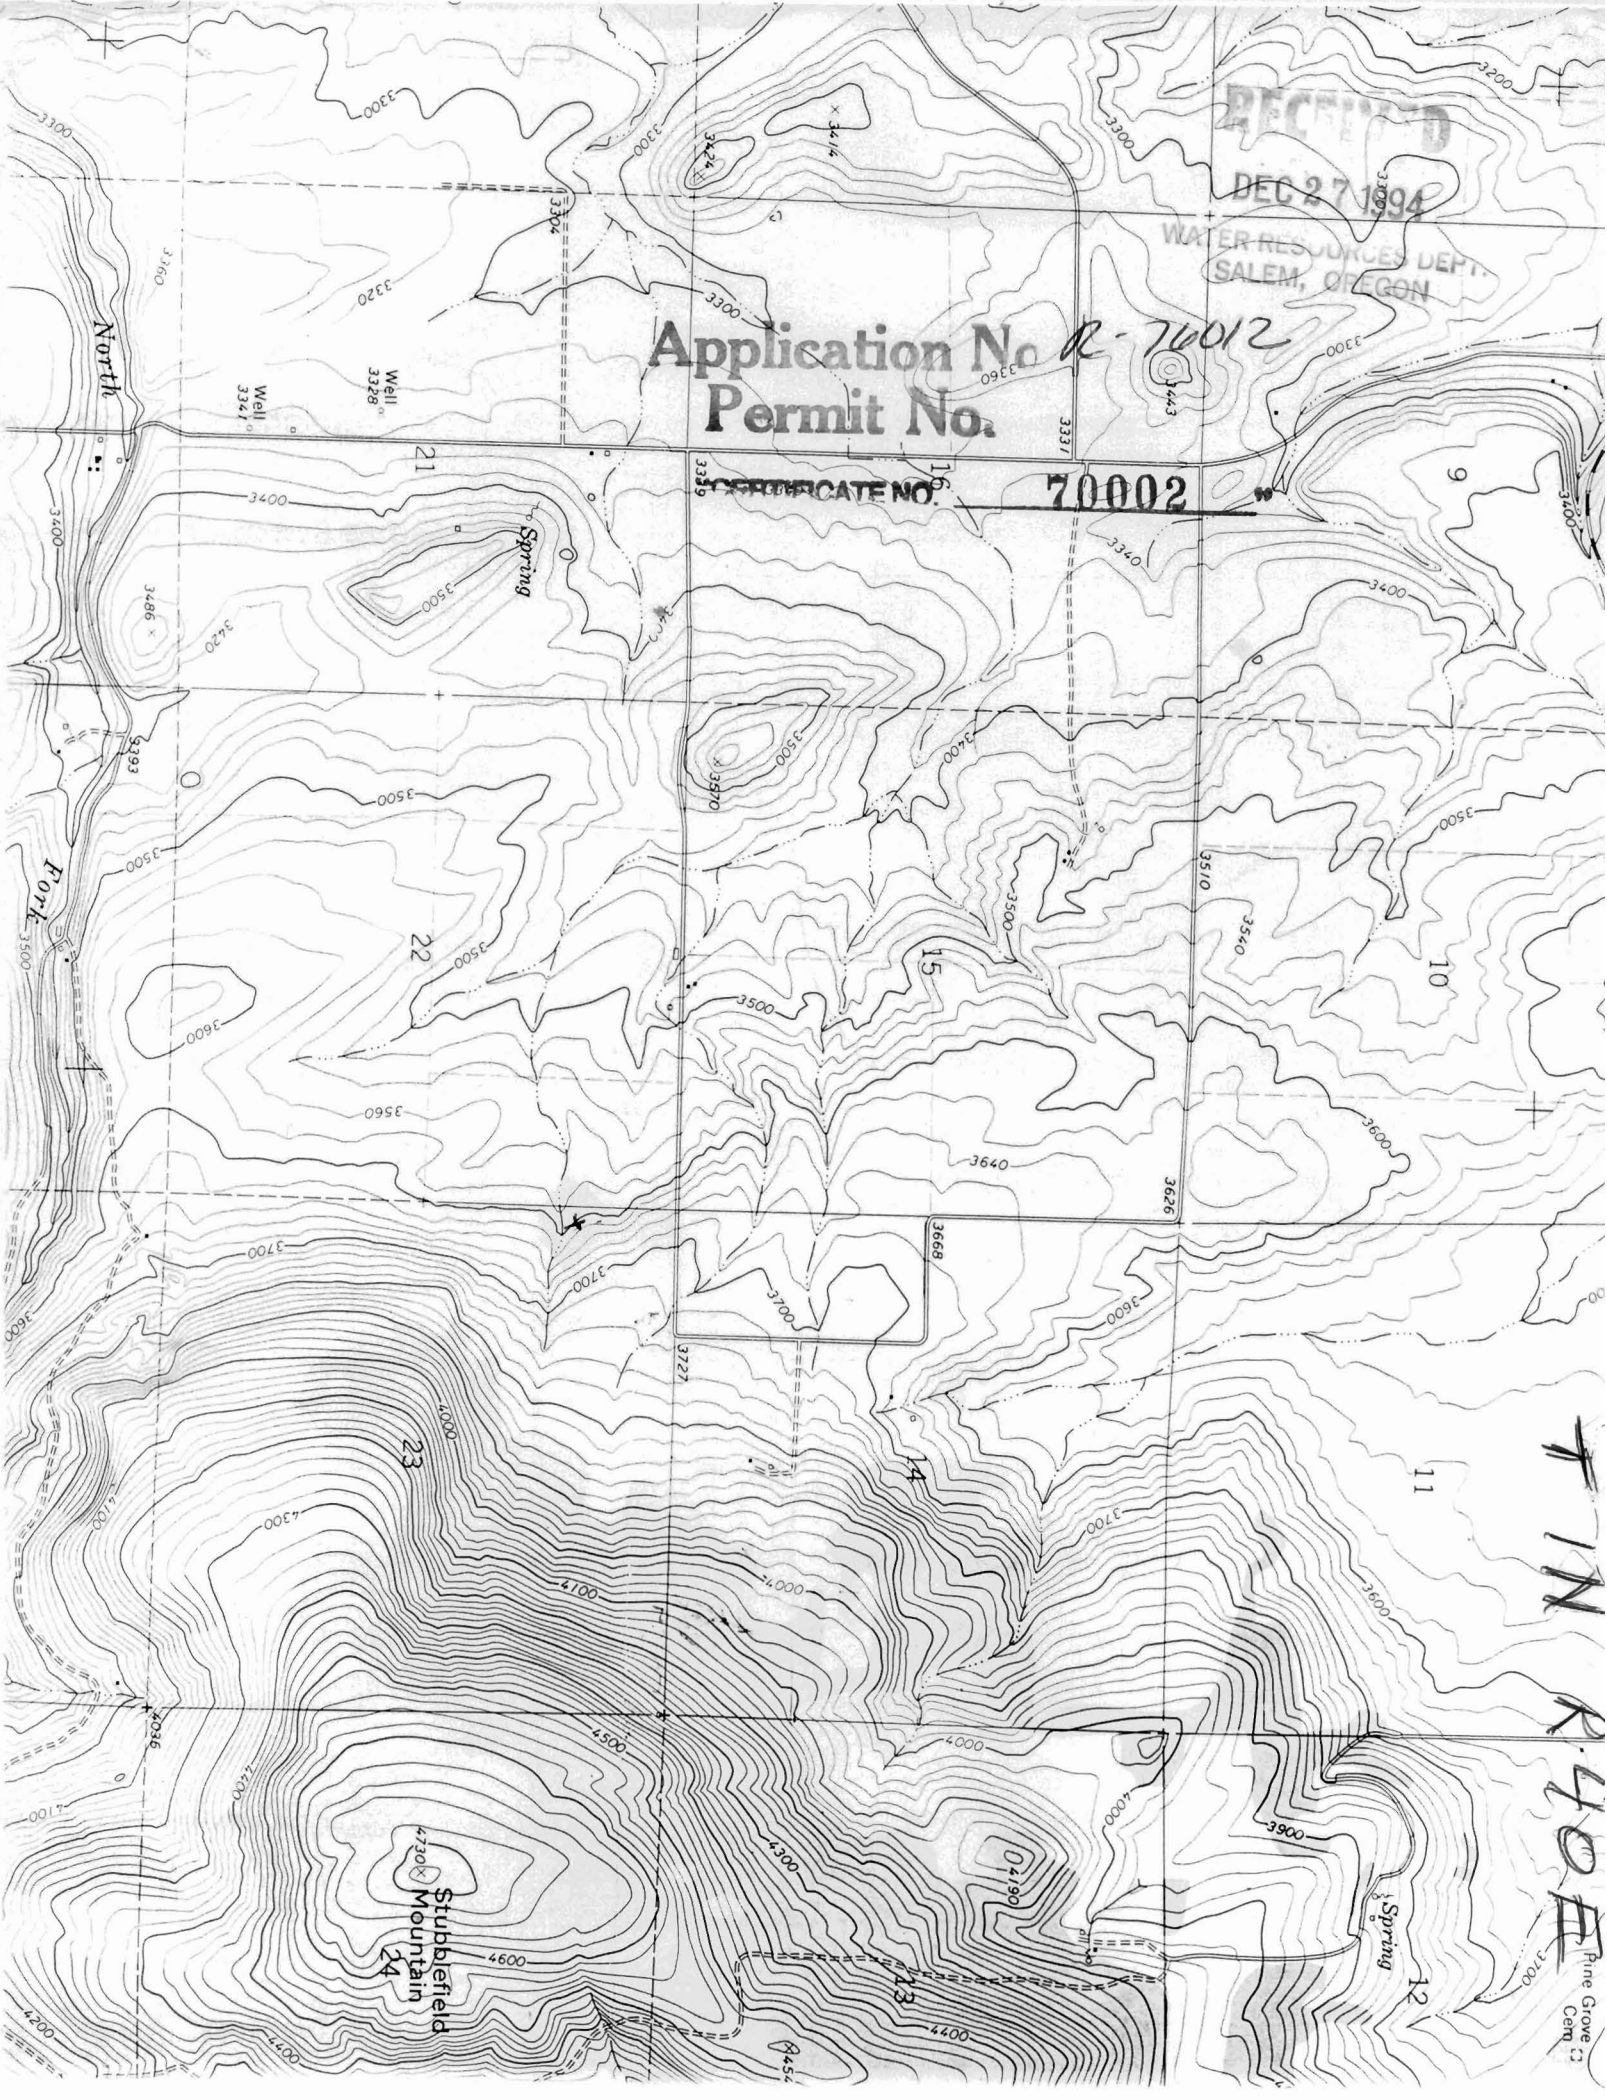

7 IN R-40 E
Prime Grove Camp