T.31S. R.16E. W.M.
LAKE COUNTY
1" = 2000'

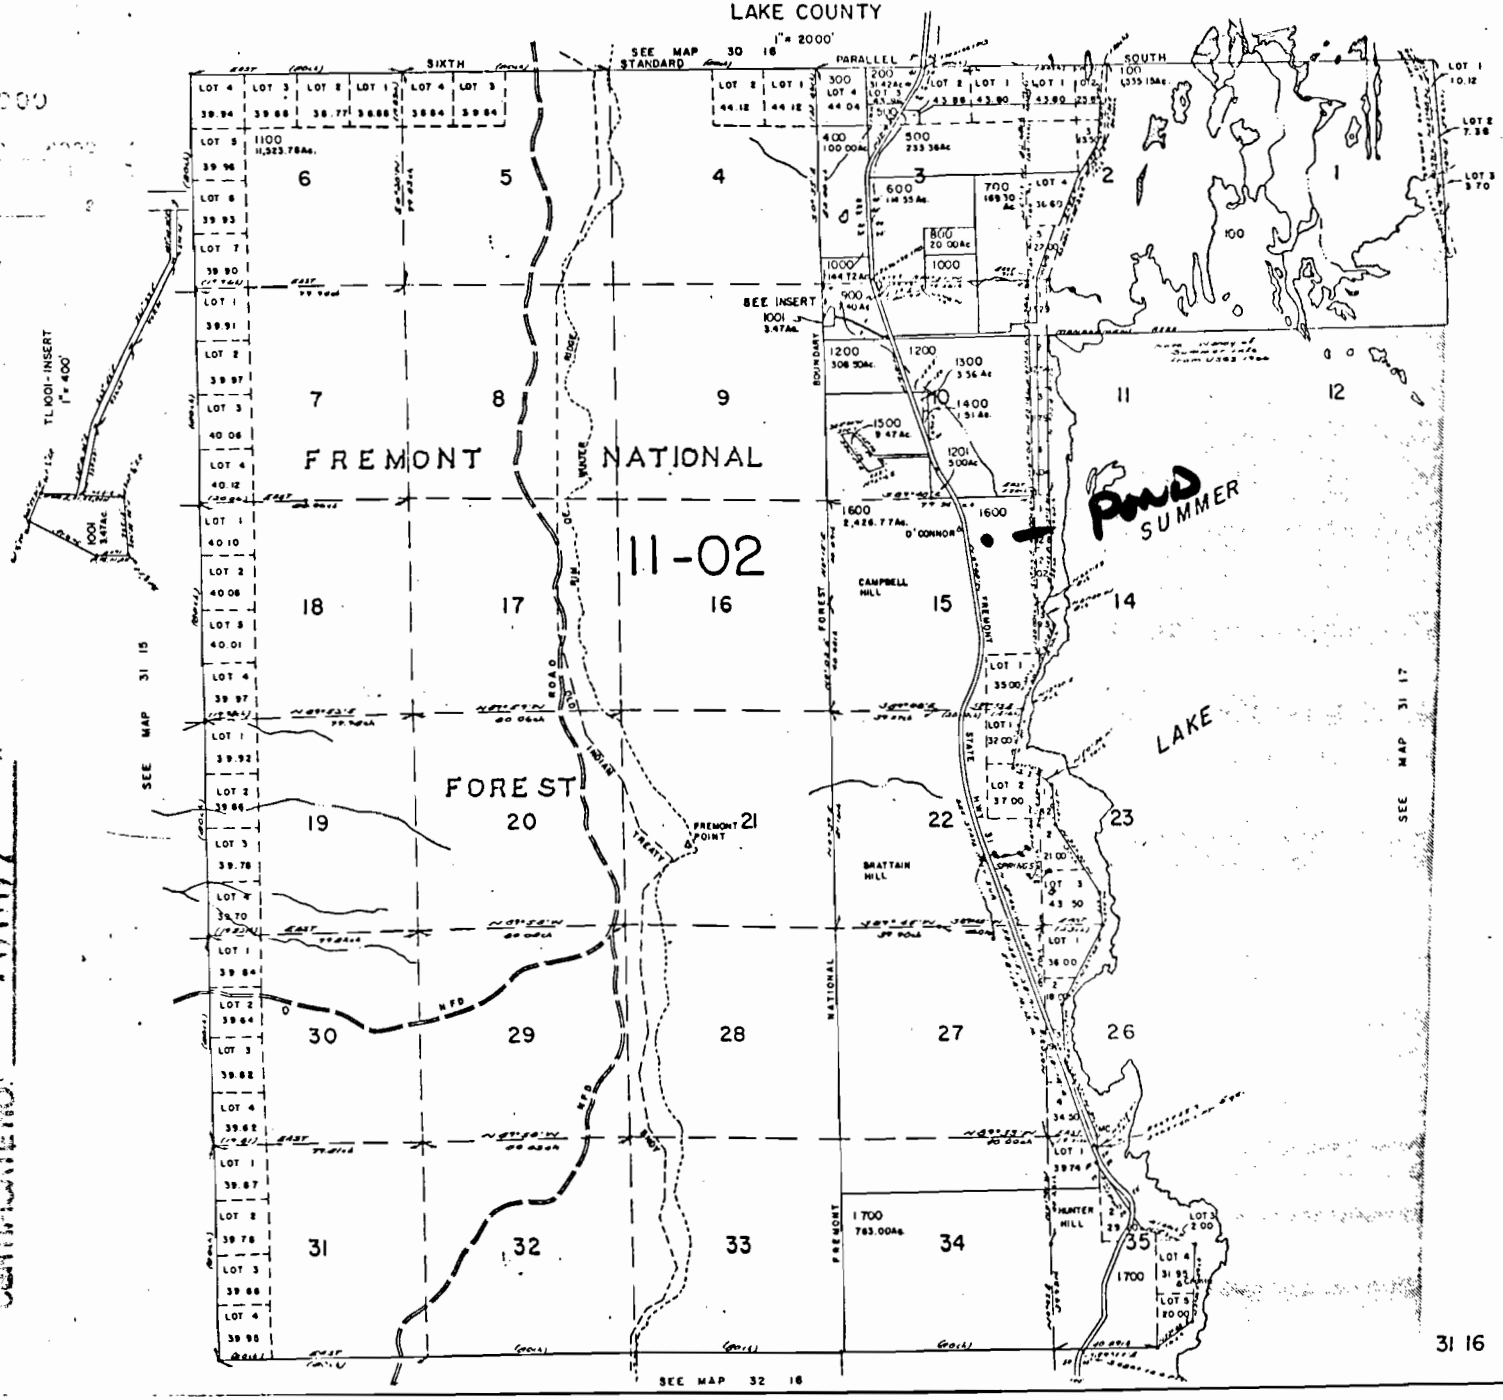

70002