


MAP

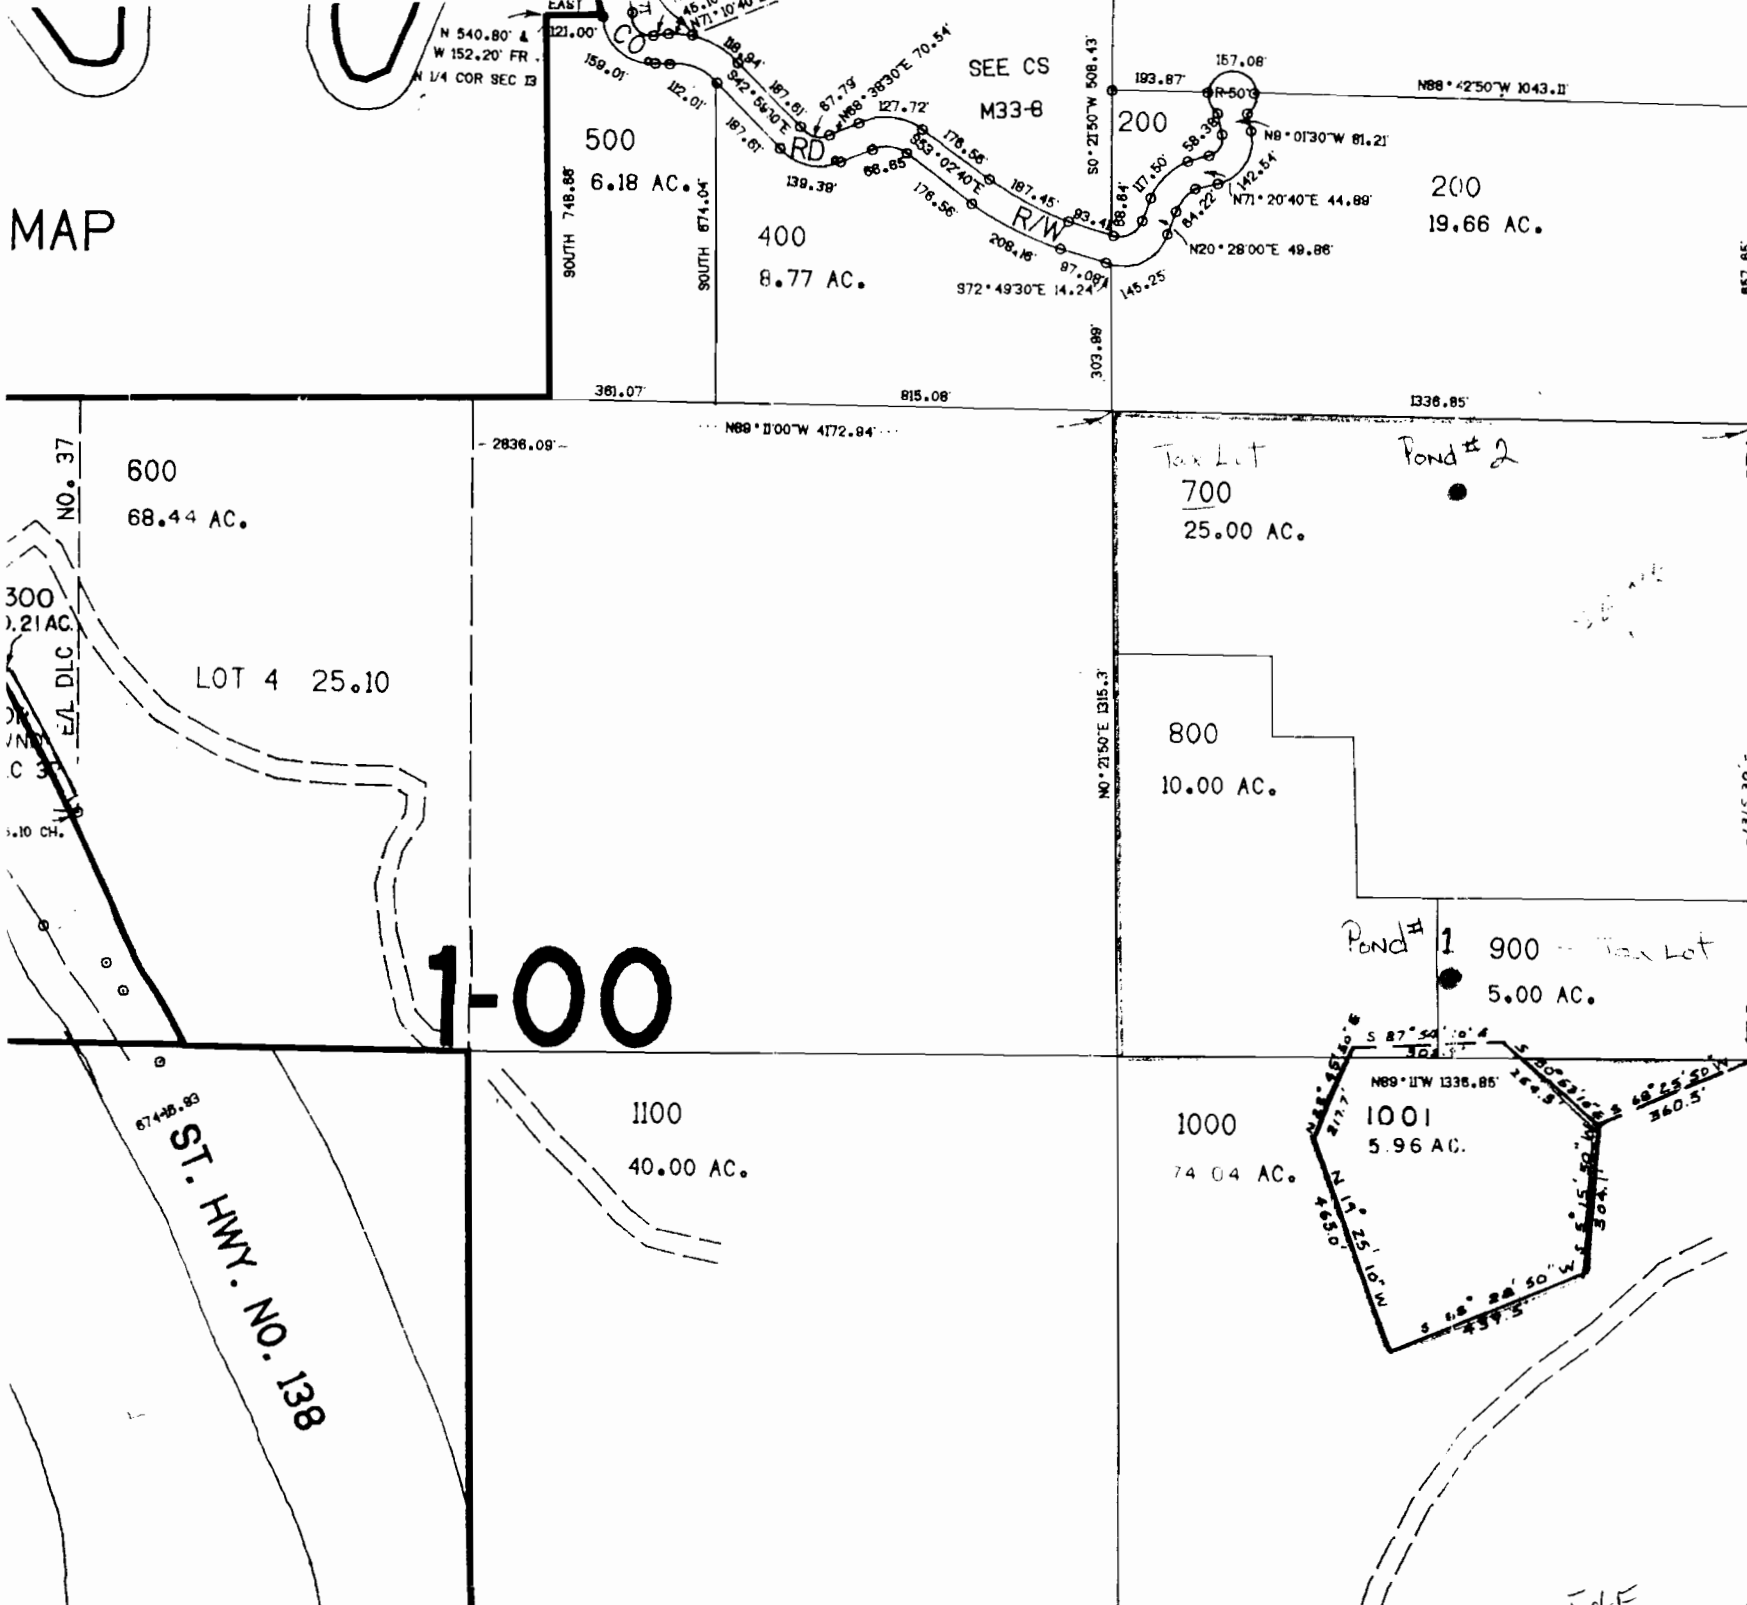

1-00

8000

Section 13
T 24 S
R 7 W

Tax Lots
700 and 900

SEE MAP 24 6 18

90° 21' 50" W 5281.20'

APPROVED
FOR
RECORD