

Application No. *R-76019*
Permit No.

"CERTIFICATE NO. 70009"

T8S. R23E. WM.


DEC - 8 1994

WATER RESOURCES DEPT.
SALEM, OREGON

Three Ponds

DEC 27 1994

WATER RESOURCES DEPT.
SALEM, OREGON

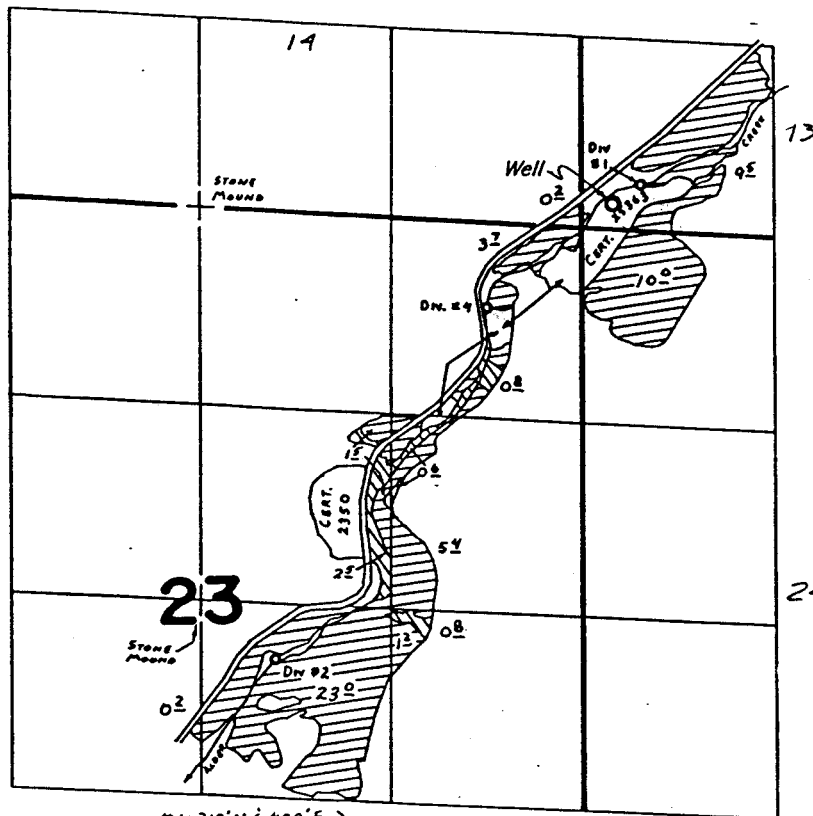

Div. Pts. Loc: $\begin{cases} \#1-310'N. \& 400'E. \\ \#2-3060'S. \& 2100'W. \\ \#4-580'S. \& 650'W. \end{cases}$ ALL FROM NE. COR. SEC. 23.

- App. # 41229
 - App. # 52798

Well Loc: 150' N. & 210' E. from NE Corner Section 23

FINAL PROOF SURVEY UNDER

TRANSFER NO. 3469

G-7426 G-6925
52798 39852

Application No. 41229 Permit No. 30826
IN NAME OF

ARTHUR ROBISON

Surveyed AUG. 6 1974, by L. H. NUNN

JUNE 6 1975 L. TOLL

AUG 25 1976 D. NORBY

AUG. 14, 1979 *Al Braun*