


RECEIVED


DEC 27 1994

WATER RESOURCES
SALEM, OREGON

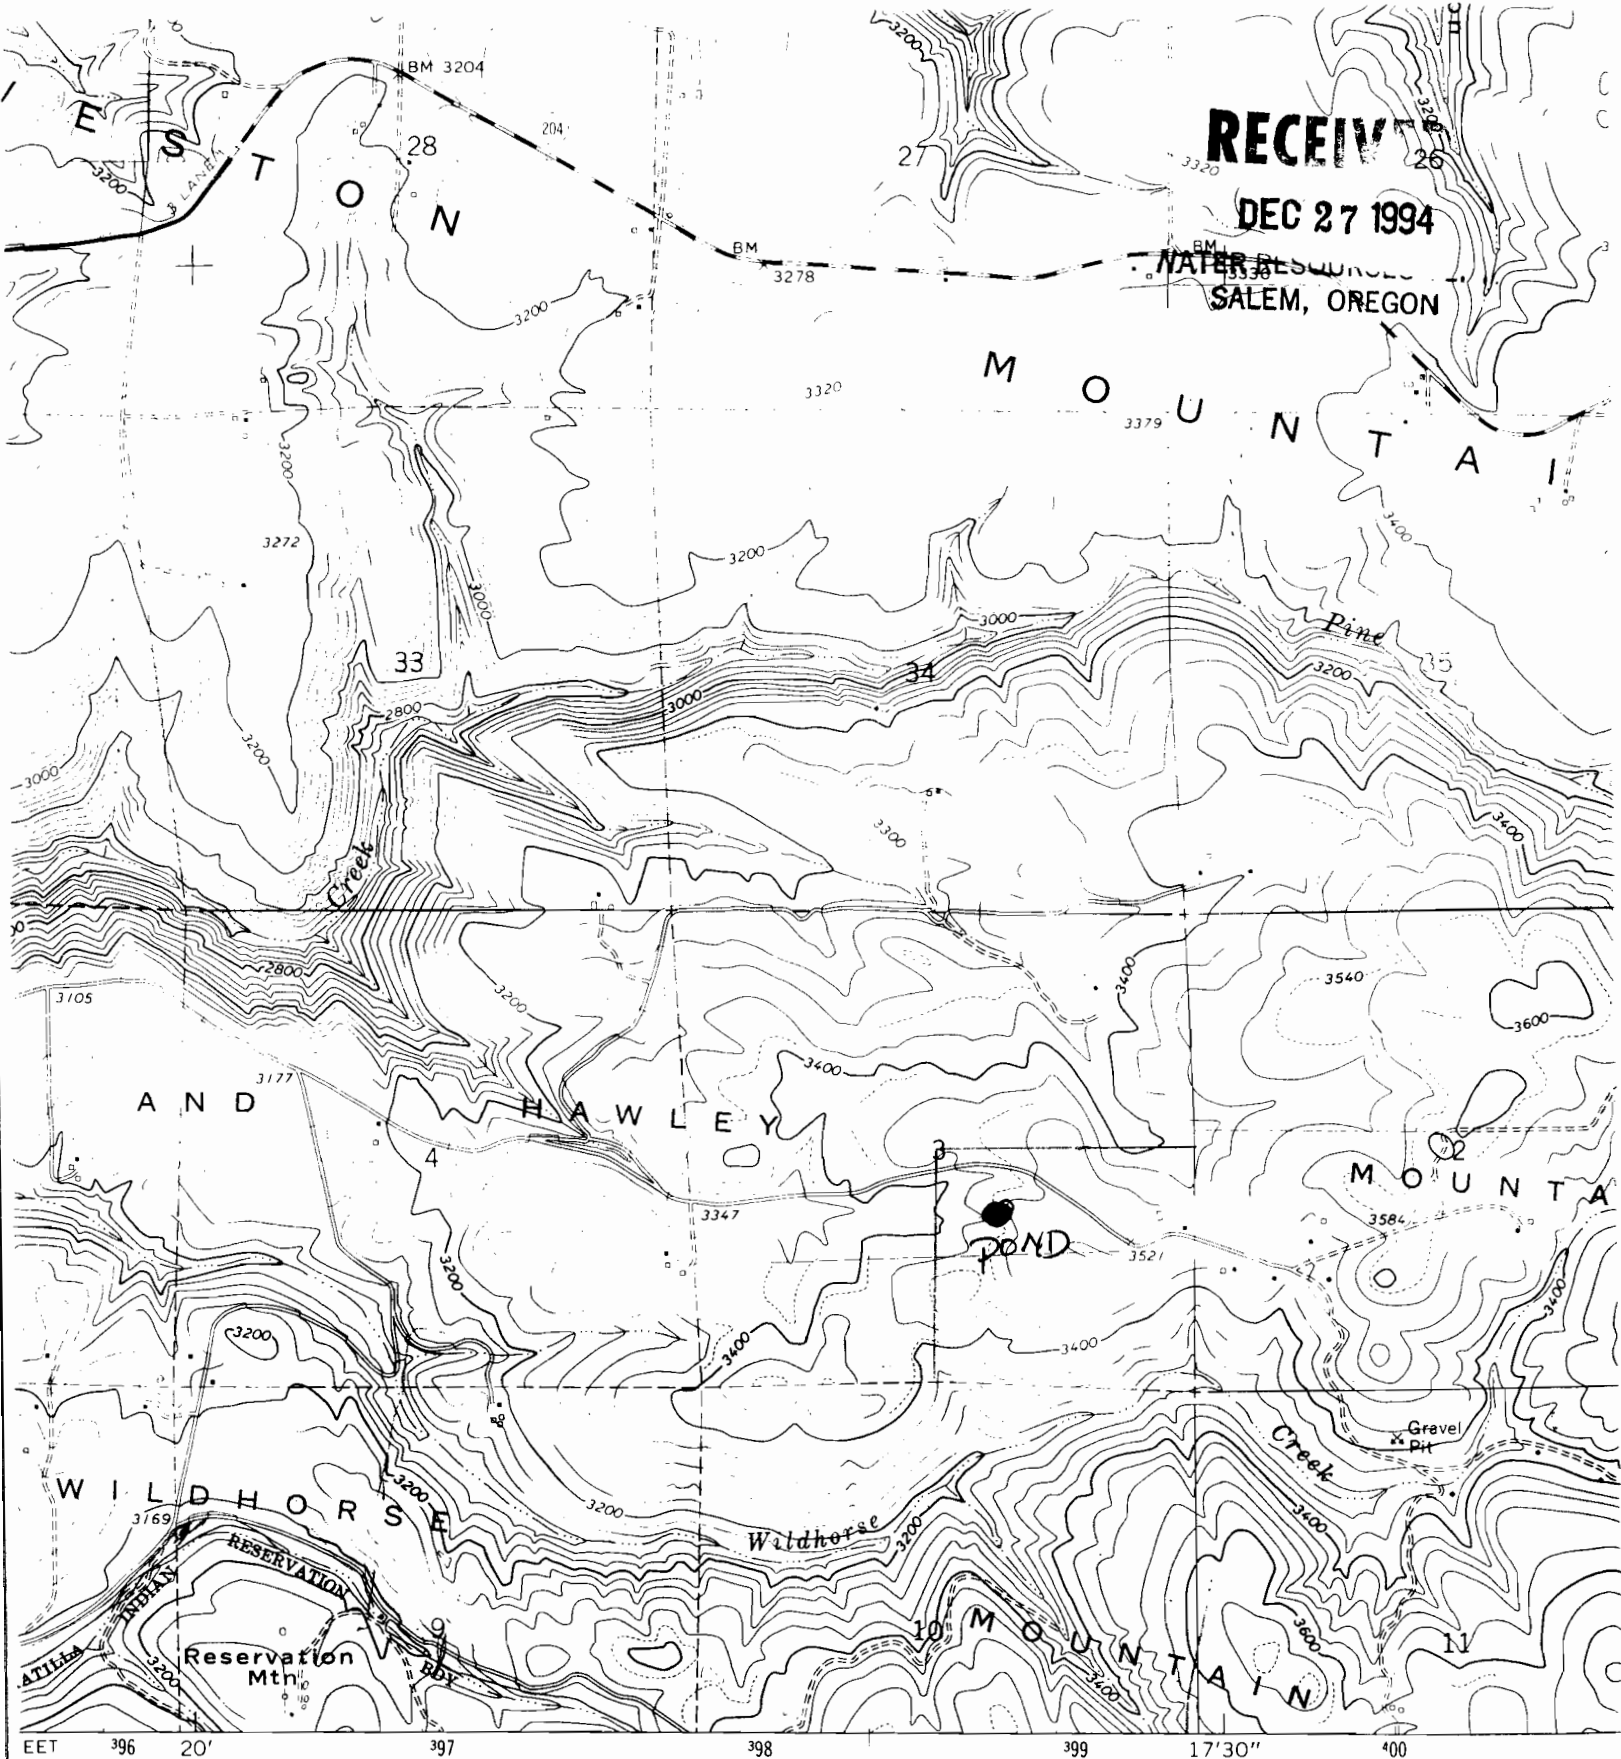

SCALE 1:24000

"CERTIFICATE NO. 70011"

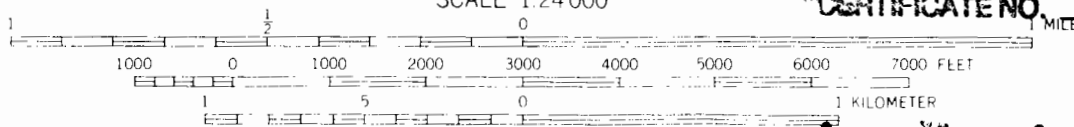

CONTOUR INTERVAL 40 FEET
DOTTED LINES REPRESENT 20-FOOT CONTOURS
DATUM IS MEAN SEA LEVEL

Application No. K-76621
Permit No.

OREGON

Sec. 3, Range 36E W.M., Umatilla Co.

TOWNSHIP

MAGNETIC NORTH
NTER OF SHEET