


APPROVED FOR
 PARTIAL NO. R-76628


"CERTIFICATE NO. 70017"

(PRIDAY RESERVOIR)
 2068 IV SW

DEC 27 1994

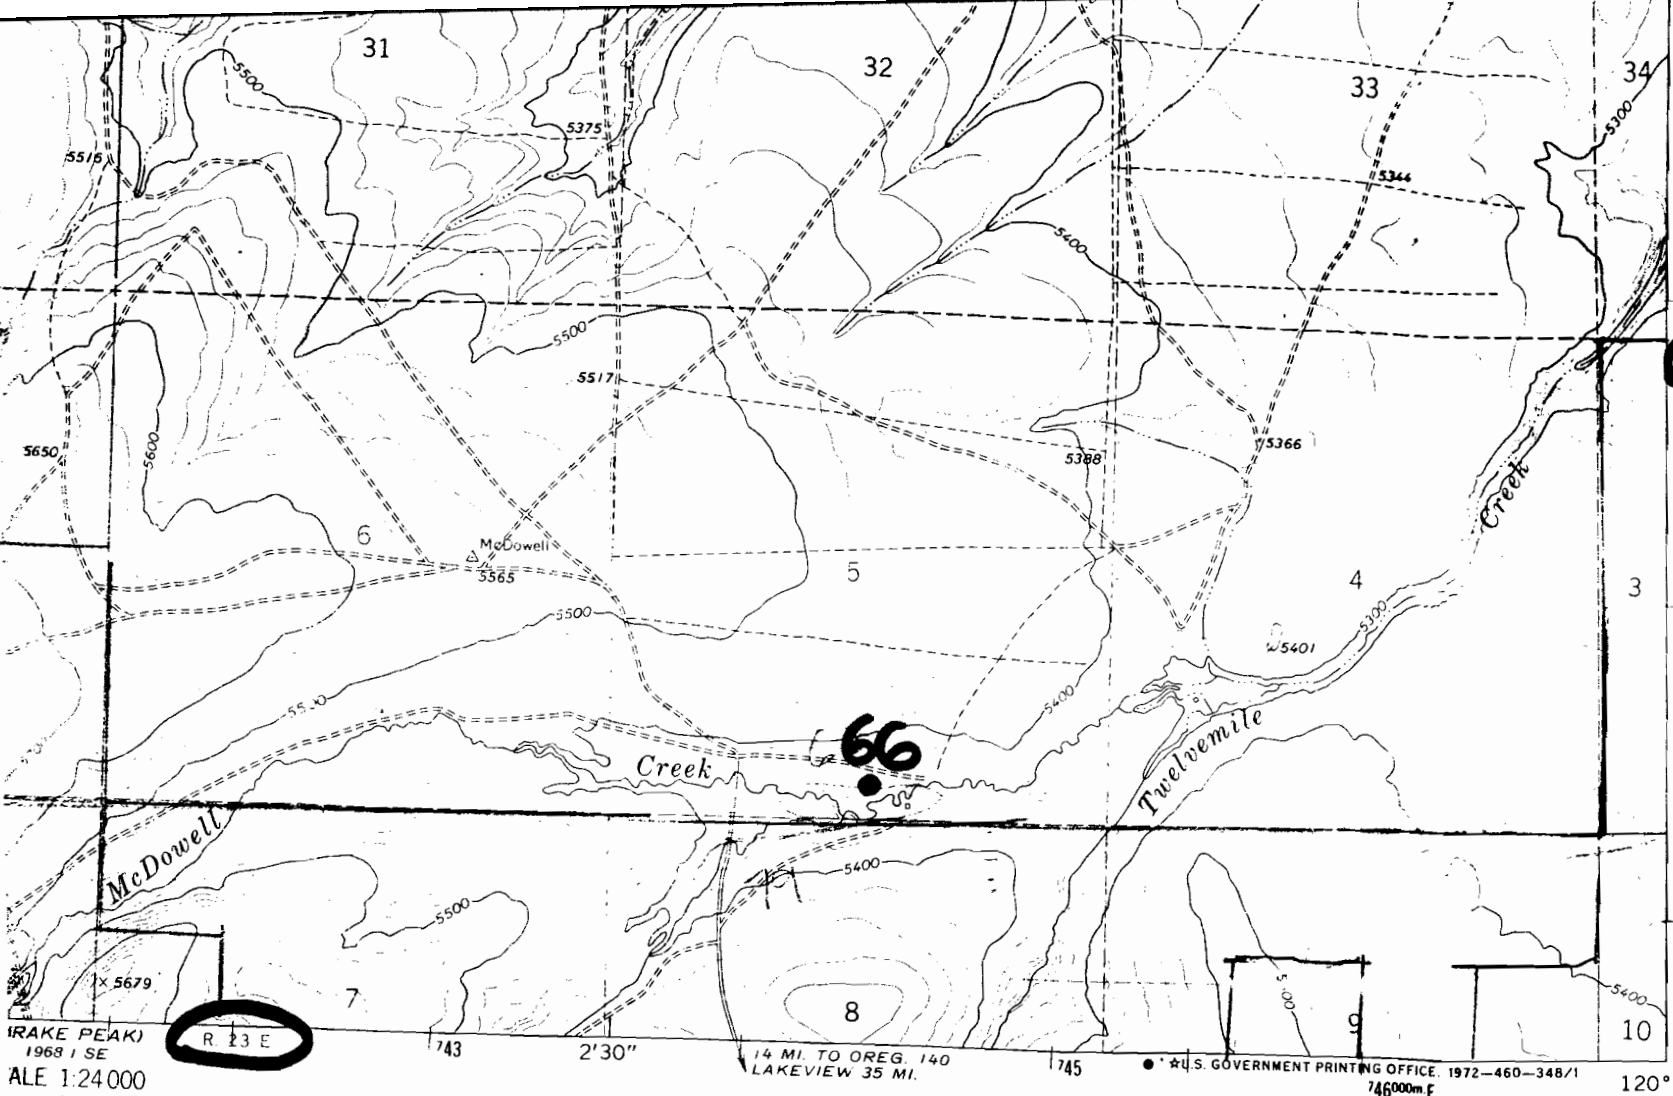

DRAKE PEAK)
 1968 I SE
 SCALE 1:24 000

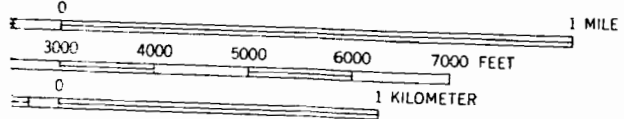

QUADRANGLE LOCATION

ROAD CLASSIFICATION

Primary highway, hard surface ——— Light-duty road, hard or improved surface ———

Secondary highway, hard surface ——— Unimproved road - - - - -

○ Interstate Route ○ U. S. Route ○ State Route

DRAKE PEAK NE, OREG.
 N4222.5—W12000/7.5

1968

AMS 1968 I NE—SERIES V892

A23E

FT2 Co.

DRAKE PEAK QUADRANGLE

OREGON - LAKE CO.

7.5 MINUTE SERIES (TOPOGRAPHIC)

DEC 27 1994

2068 1/4 NW (PLUSH)

120°00' 42°22'30"

2 130 000 FEET 746

744

2'30"

T37S

Application No. **R-76628**
Permit No.

CERTIFICATE NO.

70017

