
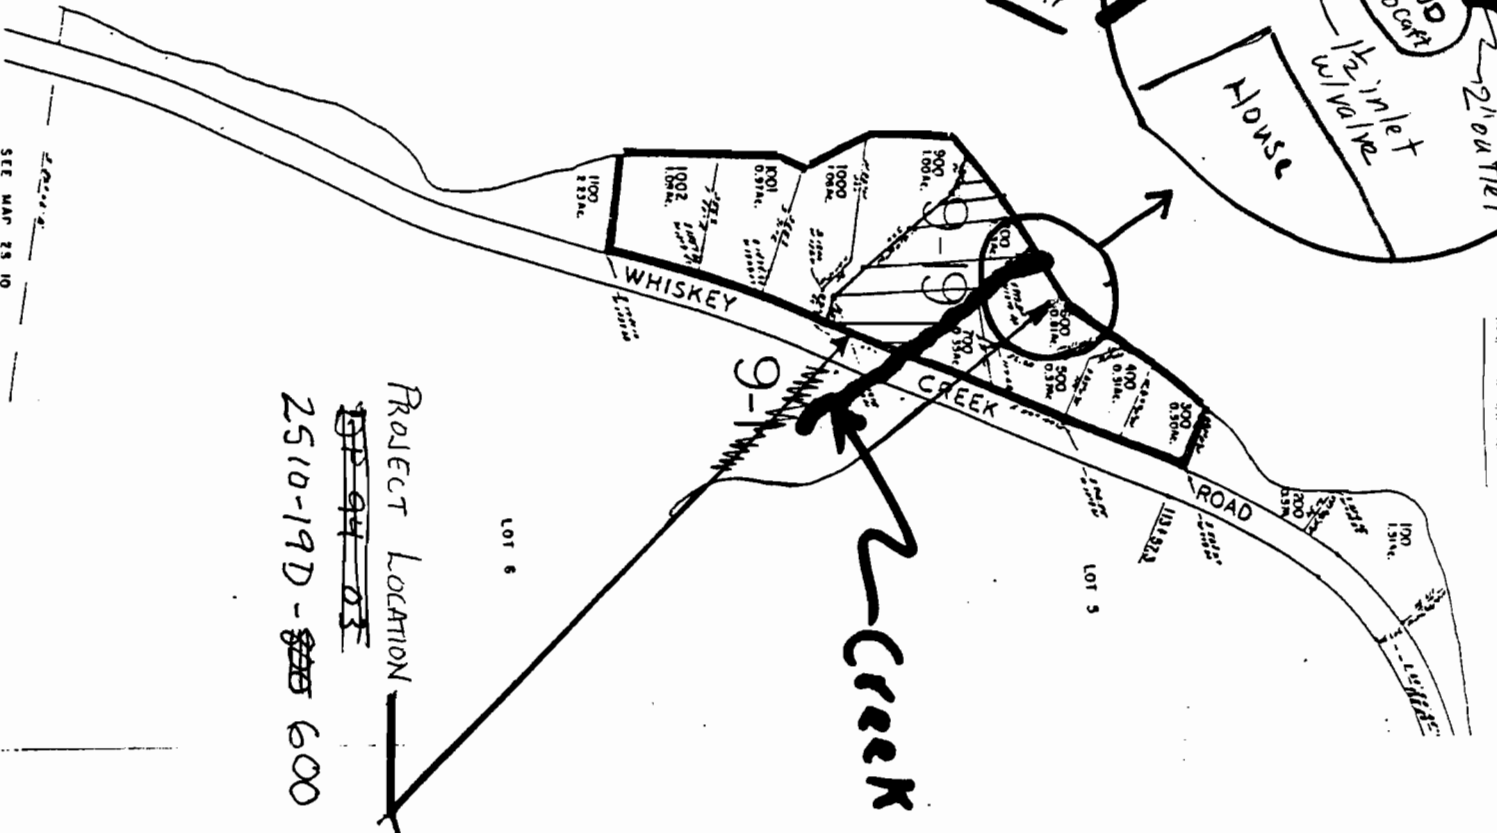


Application No. R-76033

Permit No.

CERTIFICATE NO. 70022

NETARTS

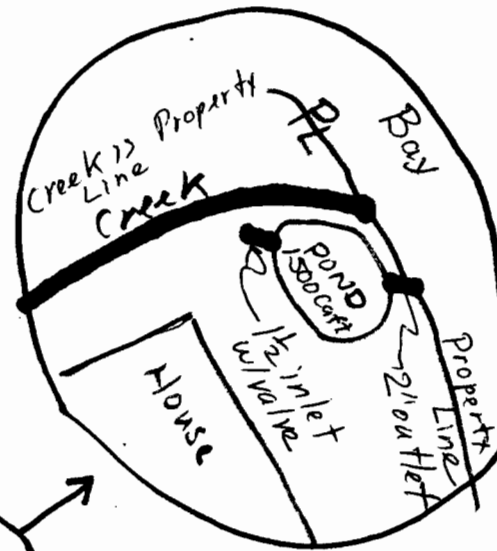

Project Location  
~~2510-19D-03~~  
 2510-19D-~~03~~ 600

