

RECEIVED

DEC 27 1994

**WATER RESOURCES DEP.
SALEM, OREGON**

COMPLIMENTS OF
CENTRAL OREGON
TITLE COMPANY
This sketch is furnished
to assist in property
location and the company
does not guarantee
its accuracy.




This map was prepared for assessment purposes only.

SEE MAP 15 17



SE 1/4 SW 1/4 SEC. 5 T13S. R17E. W4M.
CROOK COUNTY
S = 100'

SEE MAP 15 17

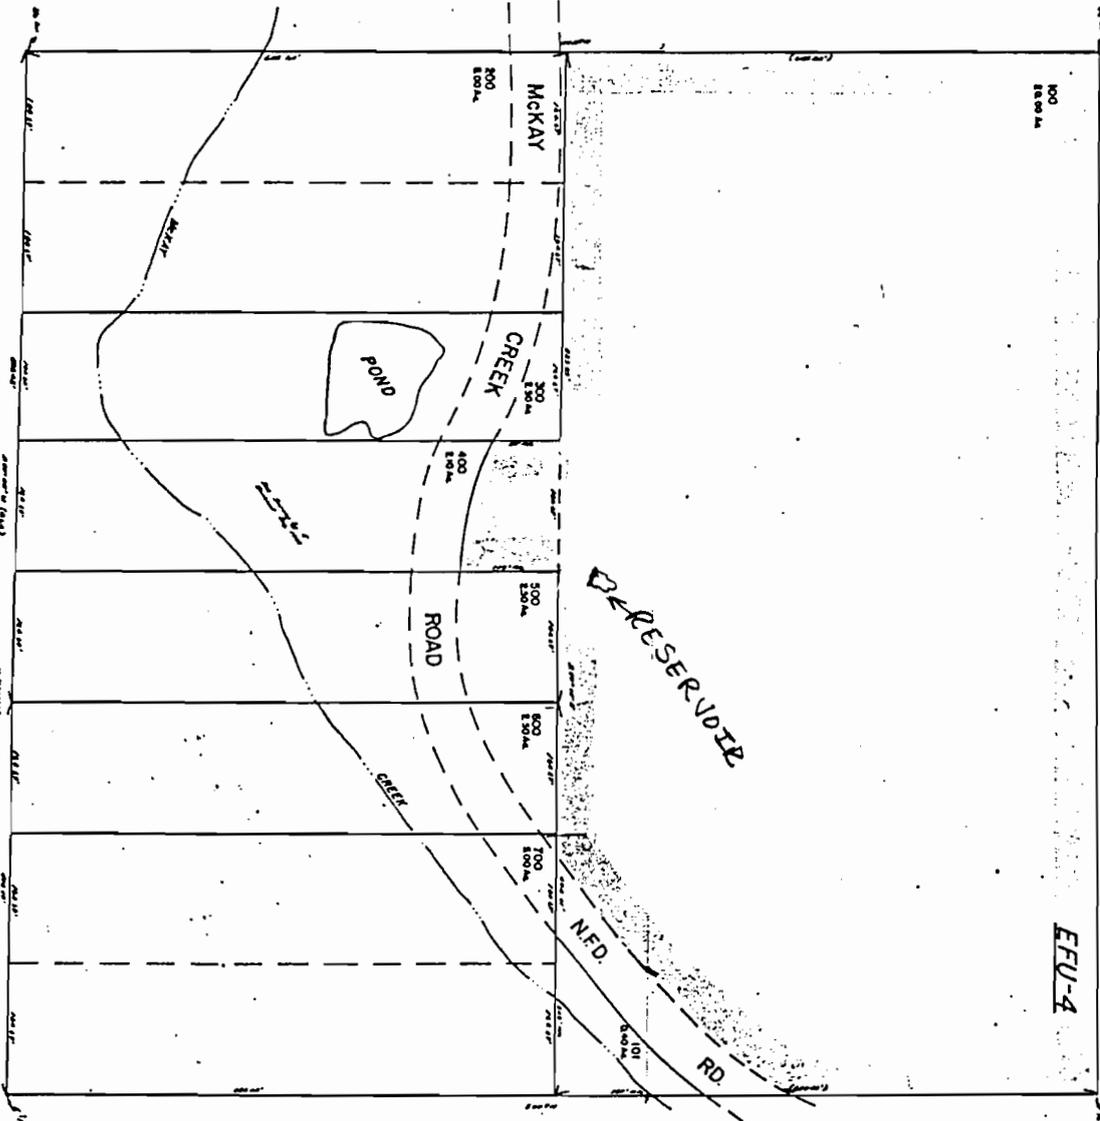

SEE MAP 15 17

13 17 5CD

SEE MAP 15 17

Application No. R-76034

Permit No.

"CERTIFICATE NO. 70023"

13 17 5CD