


ROLLING HILLS DR.

Section 34 T 35 R 1W

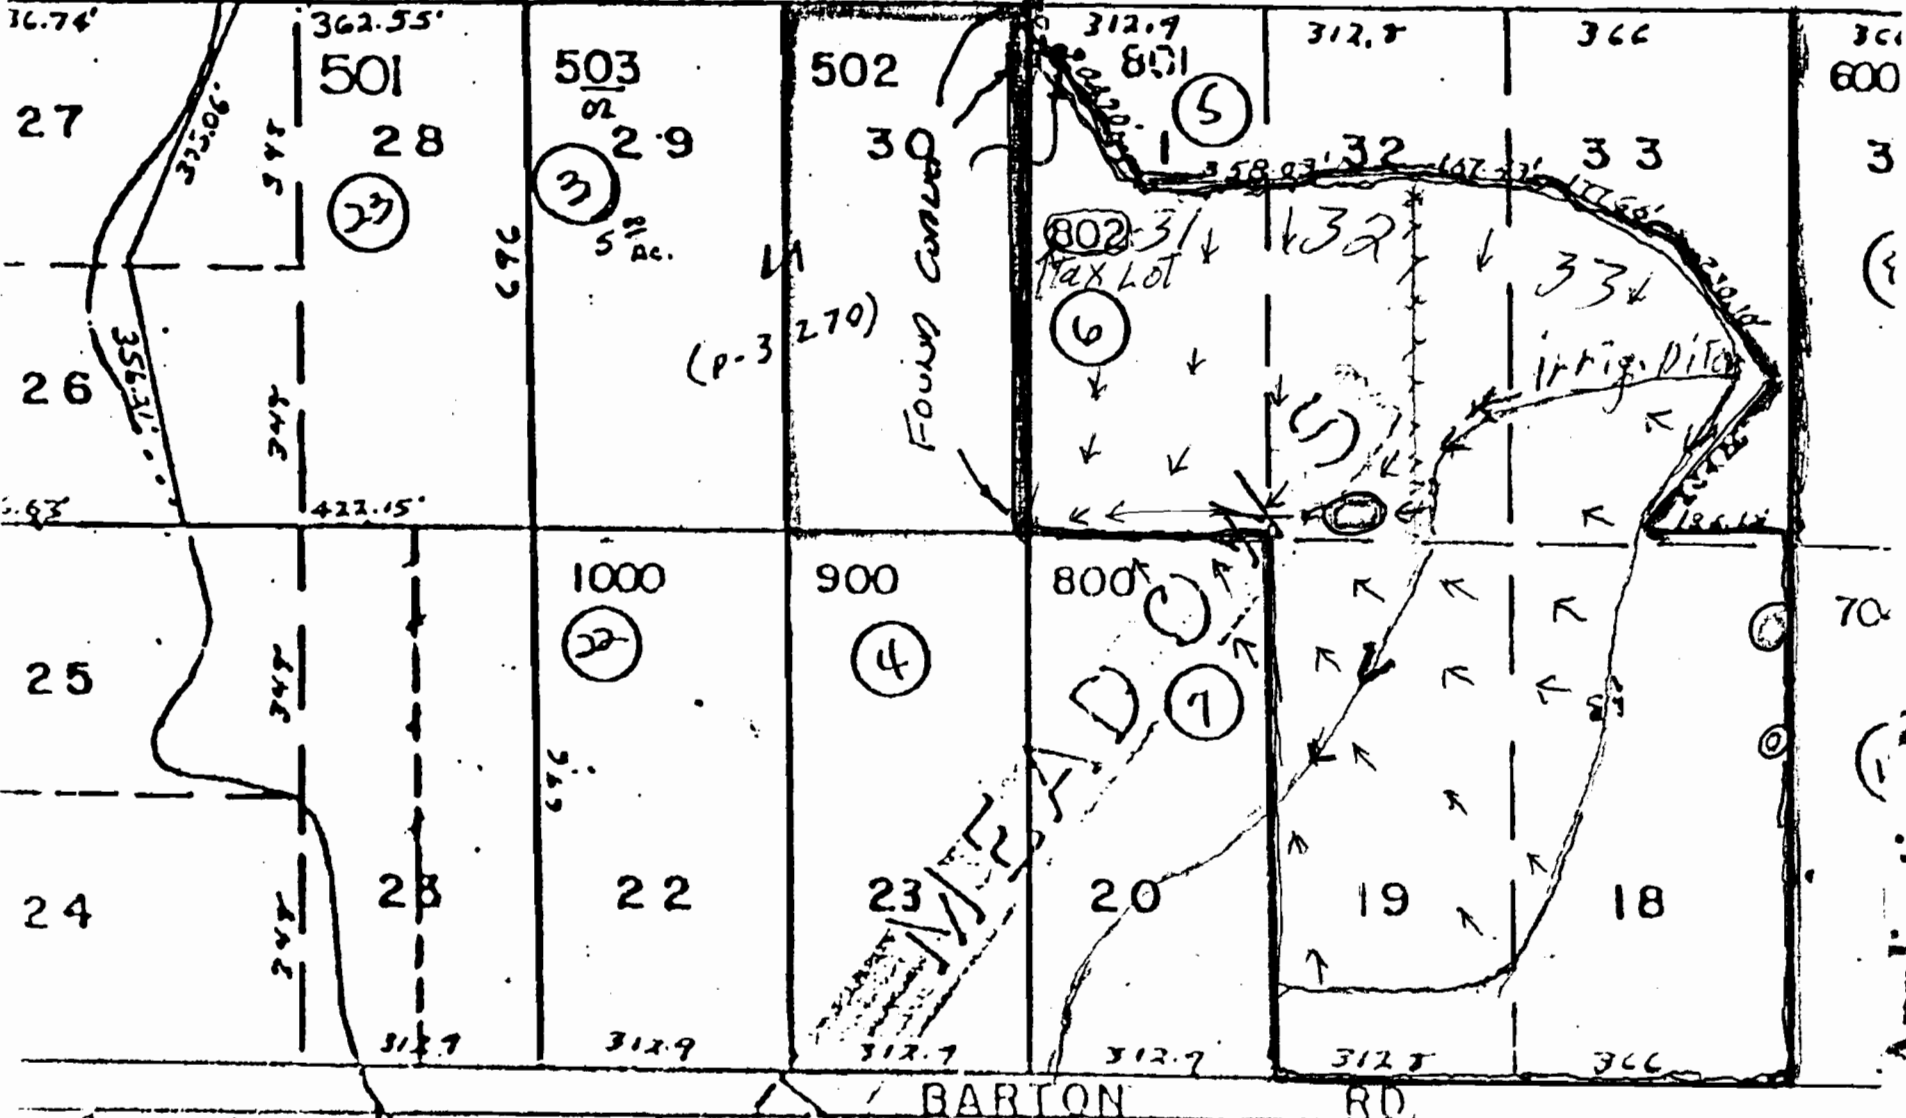

Application No. R-76040
 Permit No. 70029

DEC 27 1994

The Red arrows show the irrigation water flow
 in summer ~~use~~ use. I have cut a small ditch down
 the lowest ground for winter run off. The property
 outlined in Red is ours.