

PERMUT INC.
KILMESTER

CERTIFICATE NO

2103




CANCELLED NO

4501
2601
2801
2700
6300
6600
6601
6700
6701
6800
6900
1600
4200
4300
3400

SCALE 1:48000

SEE MAP 30 21

FOREST
SECTION
PARCEL

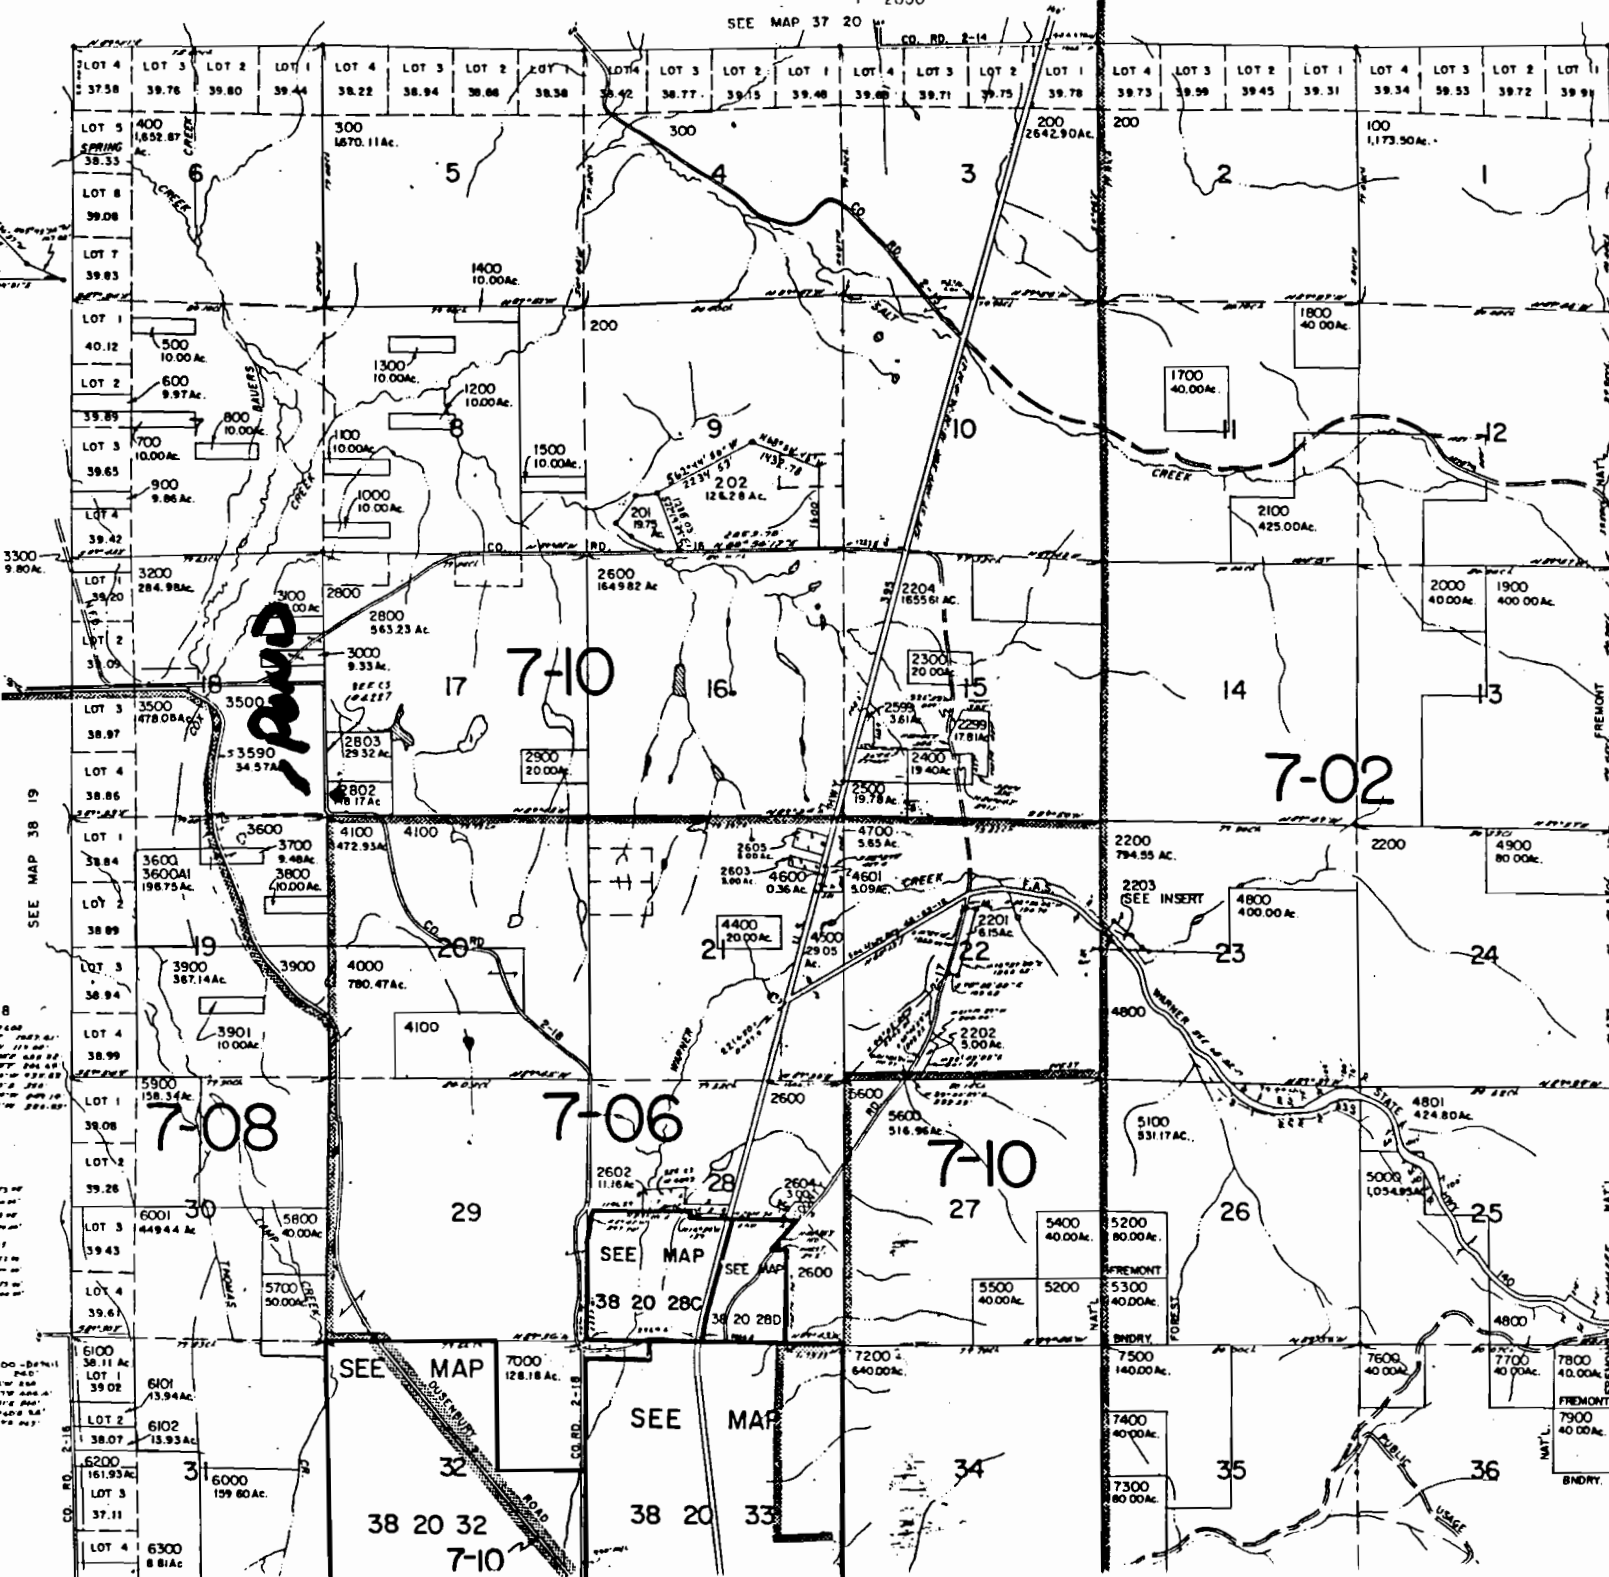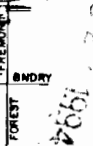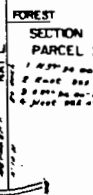

11" = 400'

SEC. 28

SEC. 21

TL 7100-Defail