


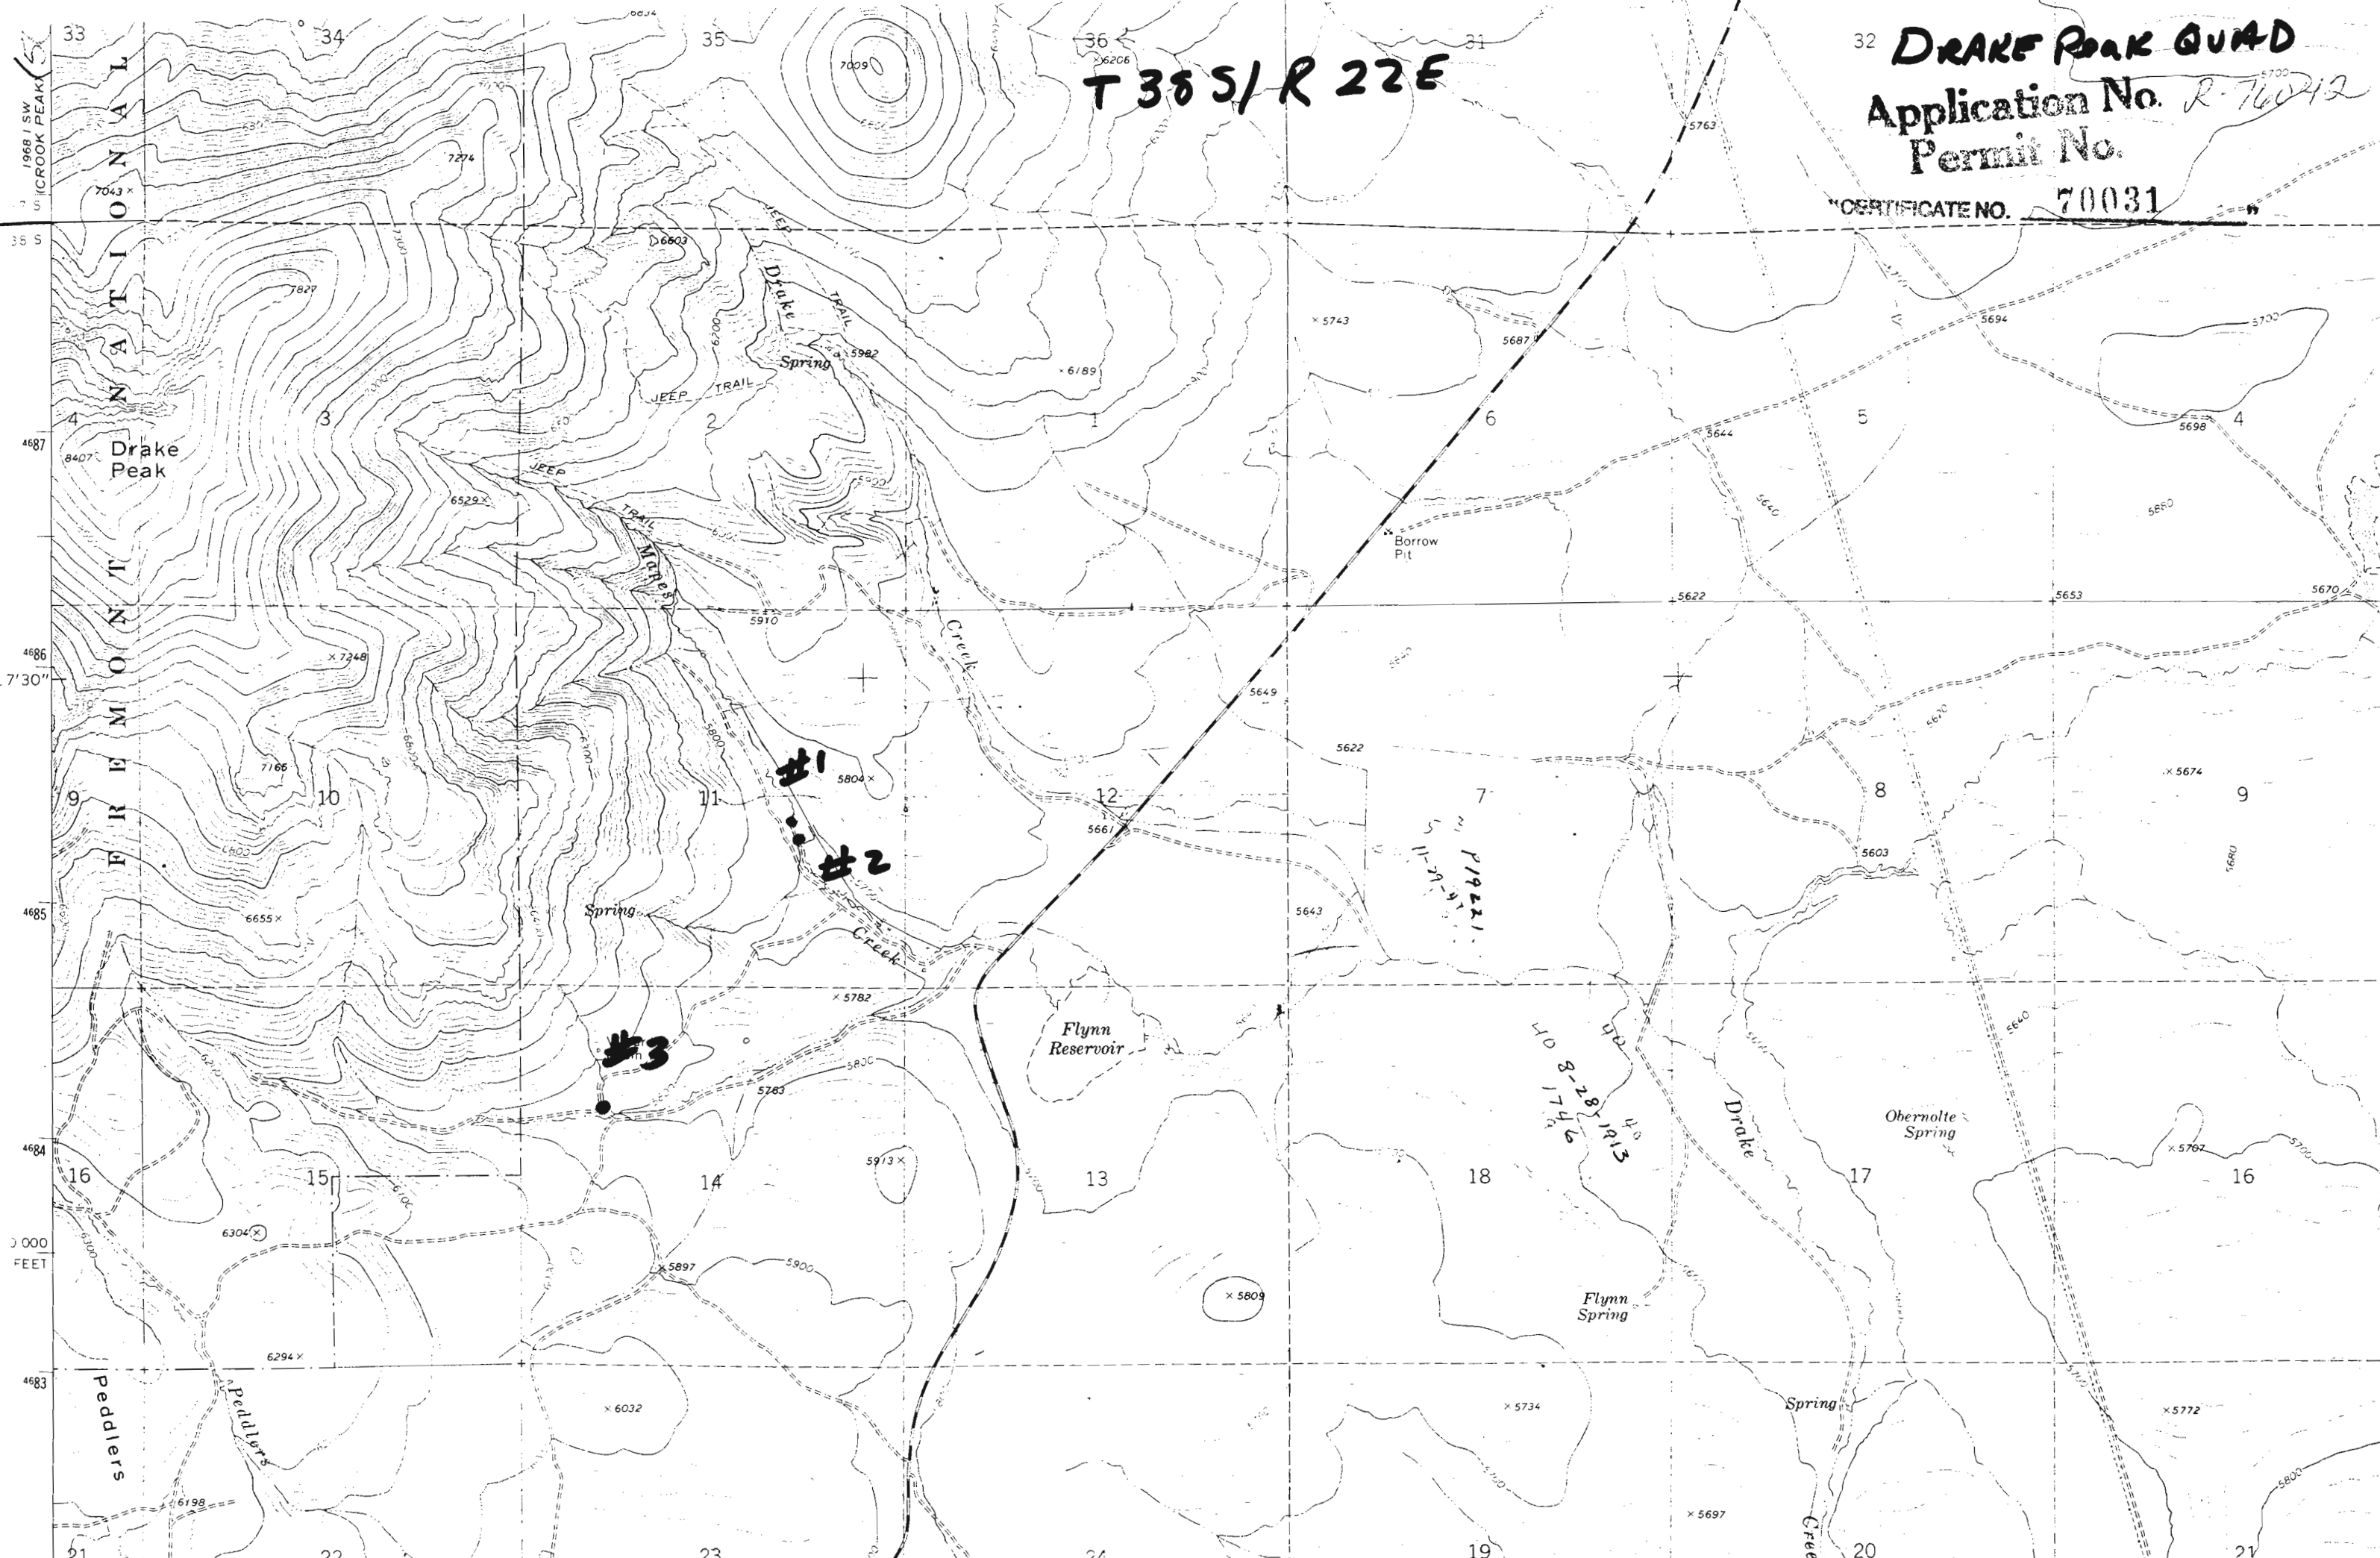

T 38 S / R 22 E

32 **Drake Peak Quad**  
Application No. *R-76042*  
Permit No.  
Certificate No. **70031**

#1  
#2

#3

P19221  
40-8-28-1913

