


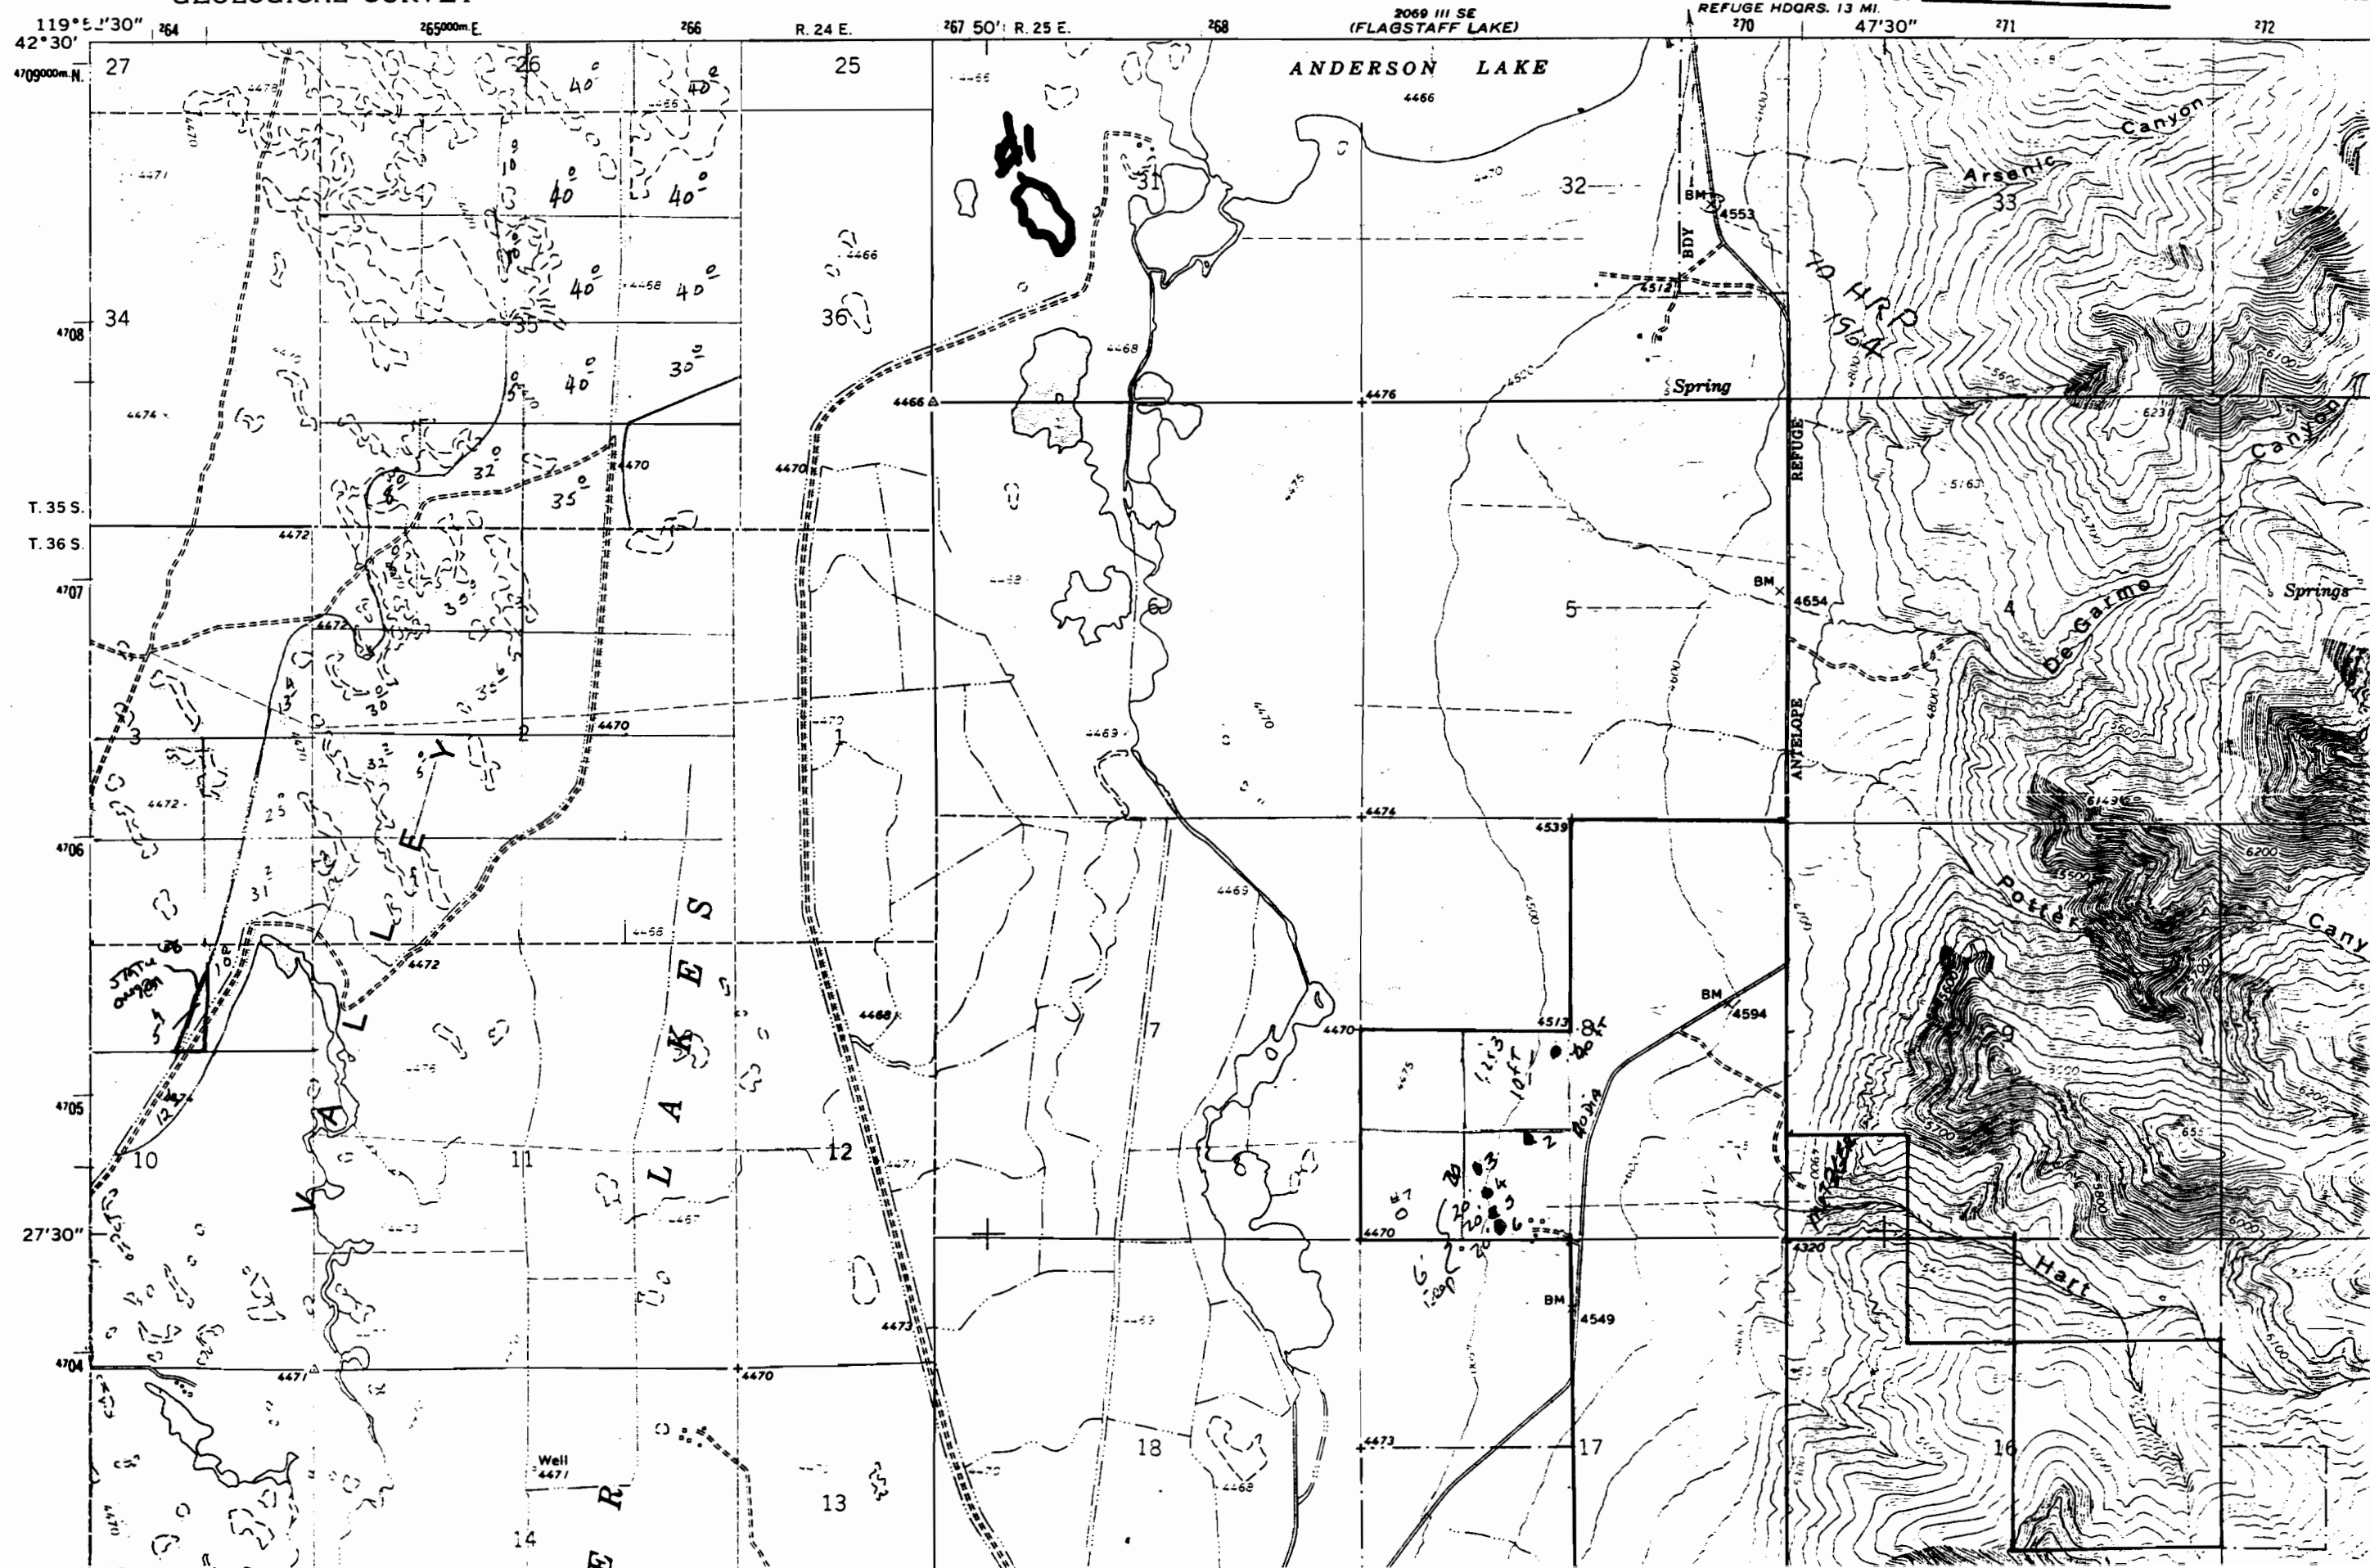

S
35/25 E
2600
Sp. 31