

Application No. R 76047  
Permit No.

Bob Olson  
45 SW 14<sup>th</sup>  
Scale 1" = 40'


"CERTIFICATE NO. 70035"

RECEIVED

DEC 29 1994

WATER RESOURCES DIV  
OREGON

BAKER CREEK RD

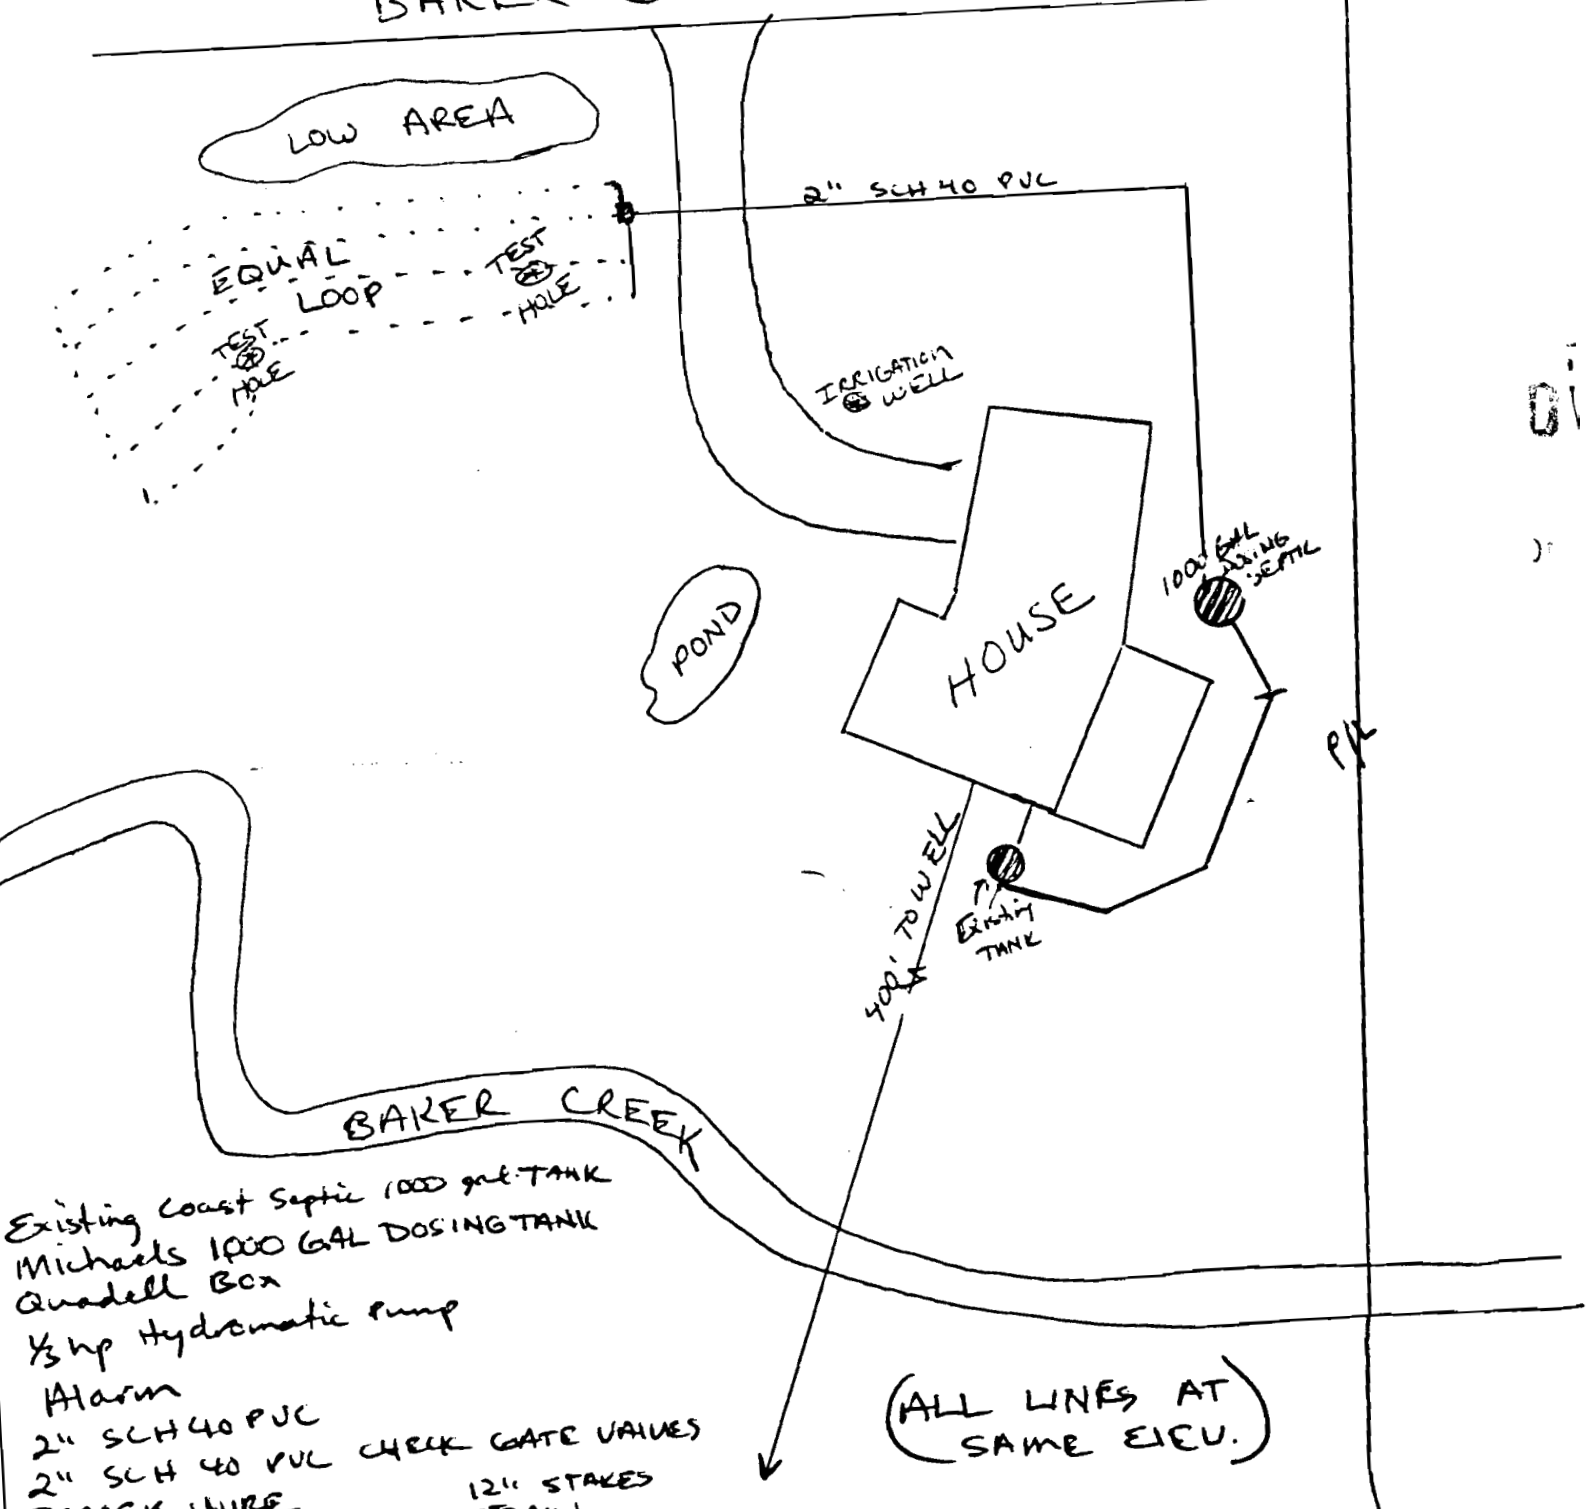

LOW AREA

EQUAL LOOP

TEST HOLE

TEST HOLE

2" SCH 40 PVC

IRRIGATION WELL

1000 GAL DOSING TANK

HOUSE

POND

400' TO WELL

EXISTING TANK

BAKER CREEK

- Existing Coast Septic 1000 gal. TANK
- Michaels 1000 GAL DOSING TANK
- Quadell Box
- 1/3 hp Hydromatic pump
- Alarm
- 2" SCH 40 PVC
- 2" SCH 40 PVC CHECK GATE VALVES
- TRACER WIRE
- 12" STAKES
- SPRAW

(ALL LINES AT SAME ELEV.)