



Application No. A-76058
Permit No.

"CERTIFICATE NO. 70045"

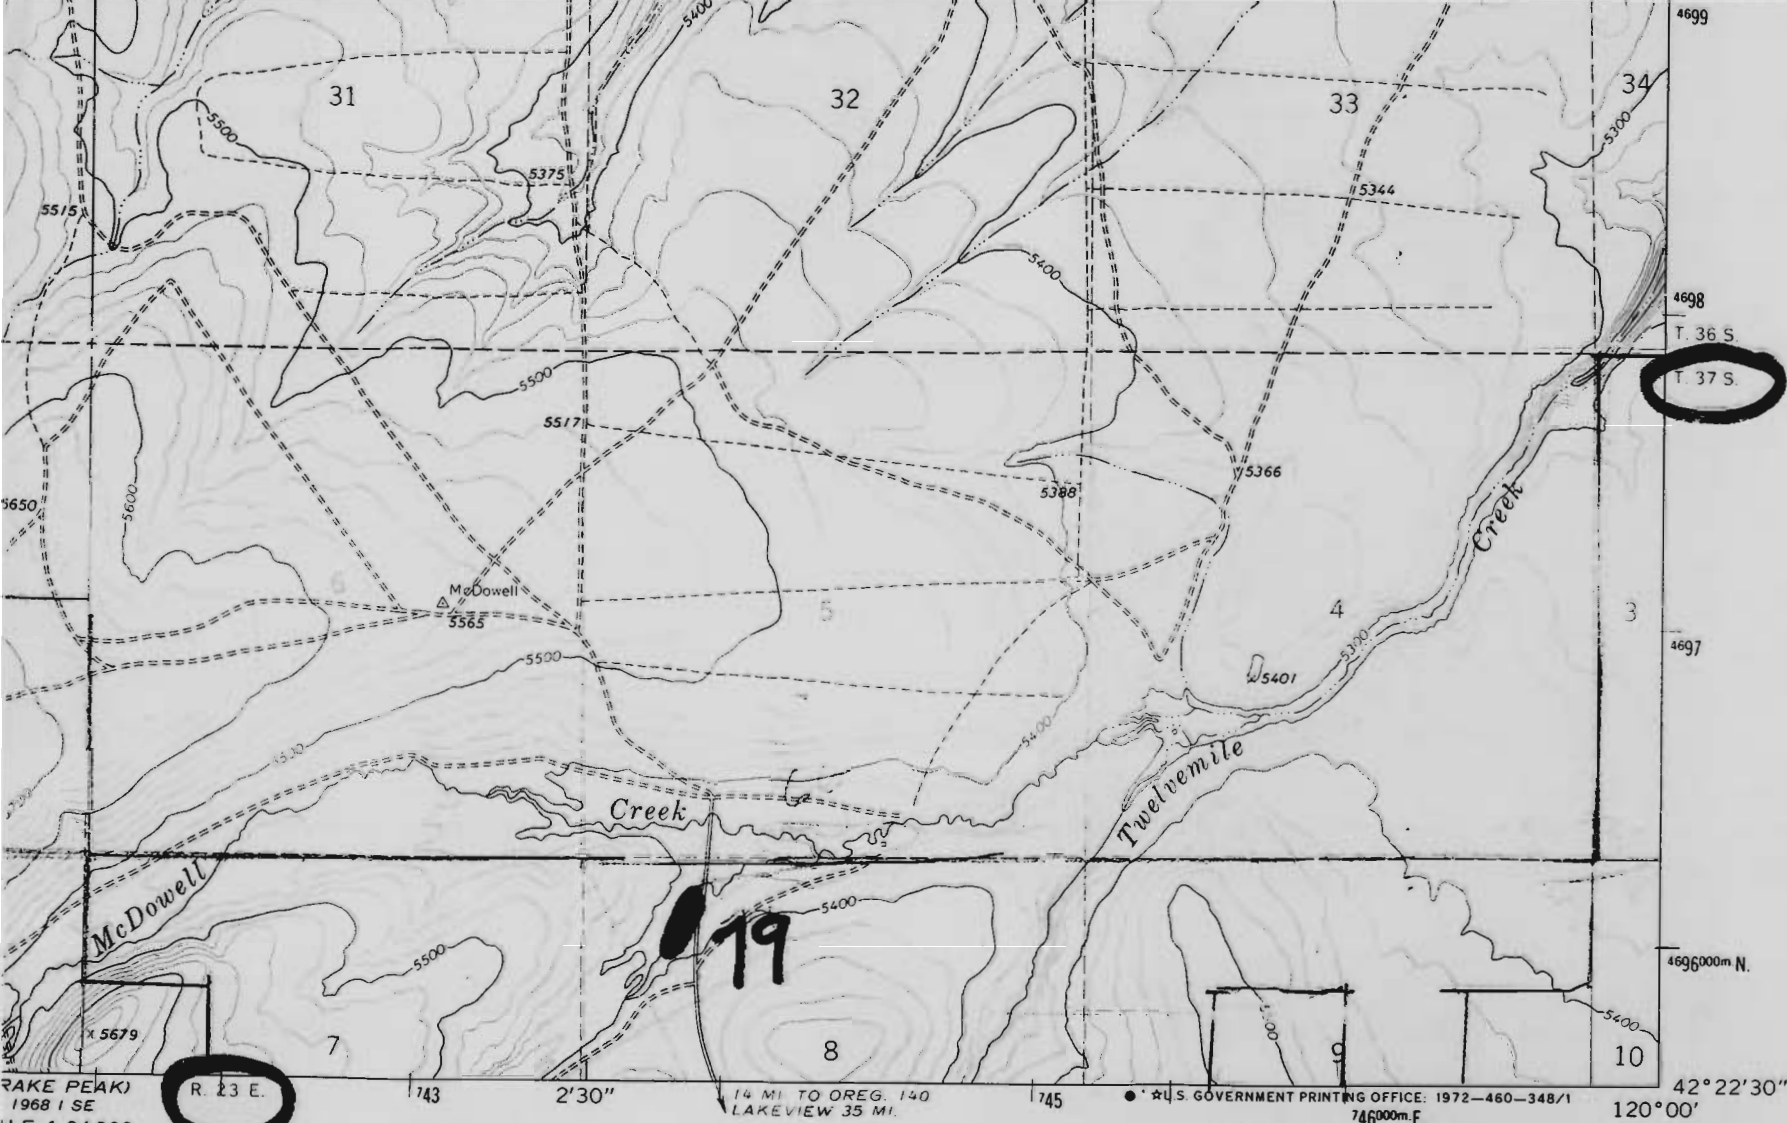

RAKE PEAK)
1968 1 SE
ALE 1:24000

R. 23 E.

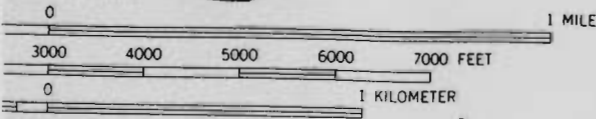

INTERVAL 20 FEET
PRESENT 10-FOOT CONTOURS
MEAN SEA LEVEL



QUADRANGLE LOCATION

ROAD CLASSIFICATION

Primary highway, hard surface ———— Light-duty road, hard or improved surface ————
Secondary highway, hard surface ———— Unimproved road ————
○ Interstate Route ○ U. S. Route ○ State Route

DRAKE PEAK NE, OREG.
N4222.5—W12000/7.5

1968

(PRIDAY RESERVOIR)
2068 IV SW

WATER IN
SALEM, OREGON

DEC 27 1994

RECEIVED

NATIONAL MAP ACCURACY STANDARDS
RIVER, COLORADO 80225, OR WASHINGTON, D. C. 20242
MAPS AND SYMBOLS IS AVAILABLE ON REQUEST

R22E

CROOK PEAK QUADRANGLE
OREGON-LAKE CO.
7.5 MINUTE SERIES (TOPOGRAPHIC)

RECEIVED
1988 LINE
DRAKE PEAK NE
DEC 27 1994
WATER RESOURCES
SALEM, OREGON

733 10' 734 735 2 100 000 FEET 120°07'30" 42°22'30"



Application No. R-76058
Permit No.
CERTIFICATE NO. 70045

T37S