


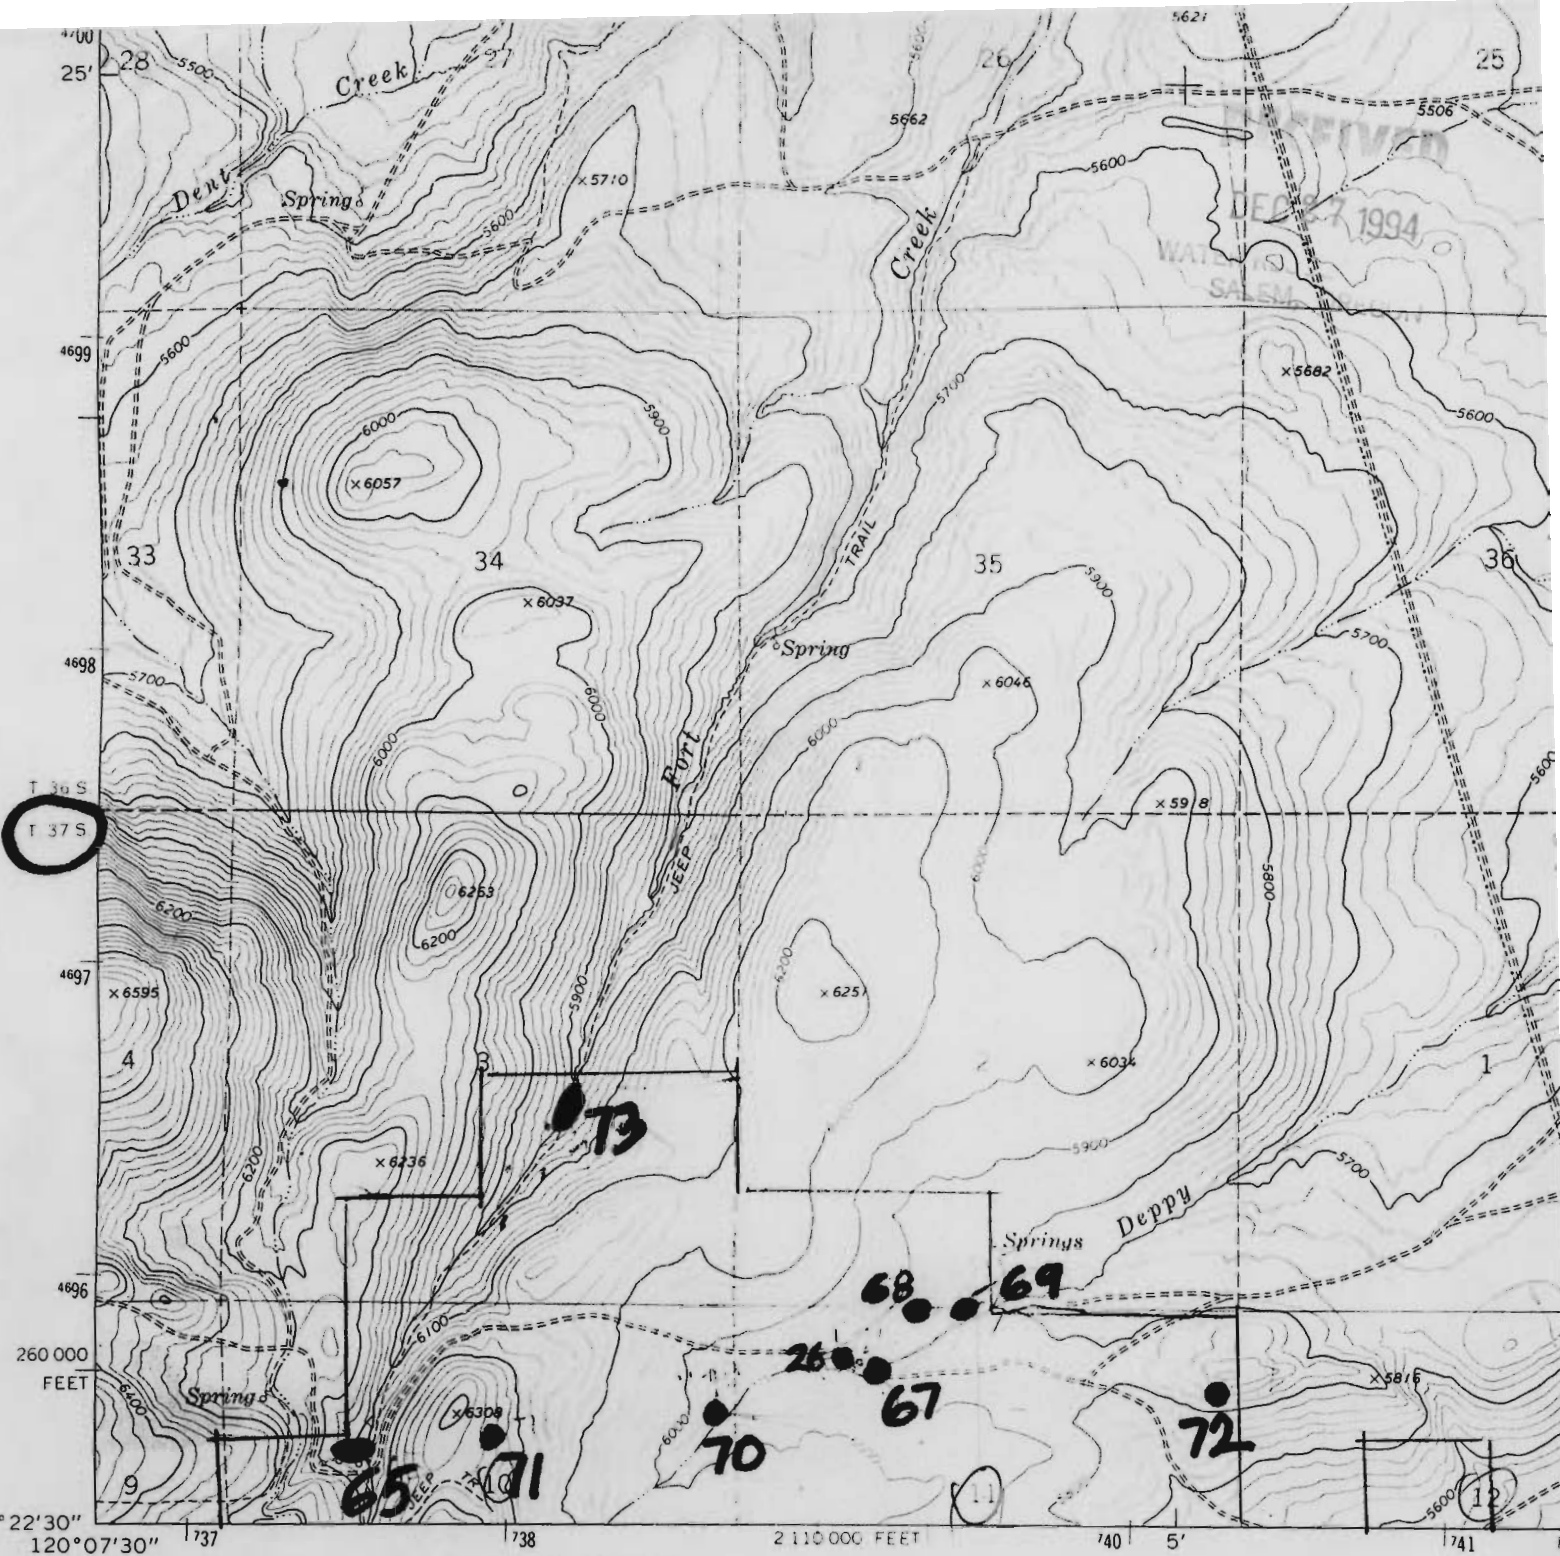

Mapped, edited, and published by the Geological Survey

Control by USGS and USC&GS


Topography by photogrammetric methods from aerial photographs taken 1967. Field checked 1968

Polyconic projection. 1927 North American datum 10,000-foot grid based on Oregon coordinate system, south zone

1000-meter Universal Transverse Mercator grid ticks, zone 10, shown in blue

Fine red dashed lines indicate selected fence lines

R22E

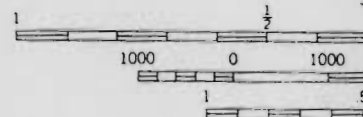

UTM GRID AND 1968 MAGNETIC NORTH DECLINATION AT CENTER OF SHEET

Application No. R-76059
 Permit No.
 "CERTIFICATE NO. 70046"

THIS MAP COMPLIES
 FOR SALE BY U. S. GEOLOGICAL SURVEY
 A FOLDER DESCRIBING TOP