

1968 / NW
E HONEY CREEK

737000- E


738

739

740

5'

41 R. 22 E. 1968 IN (DRAKE PE)

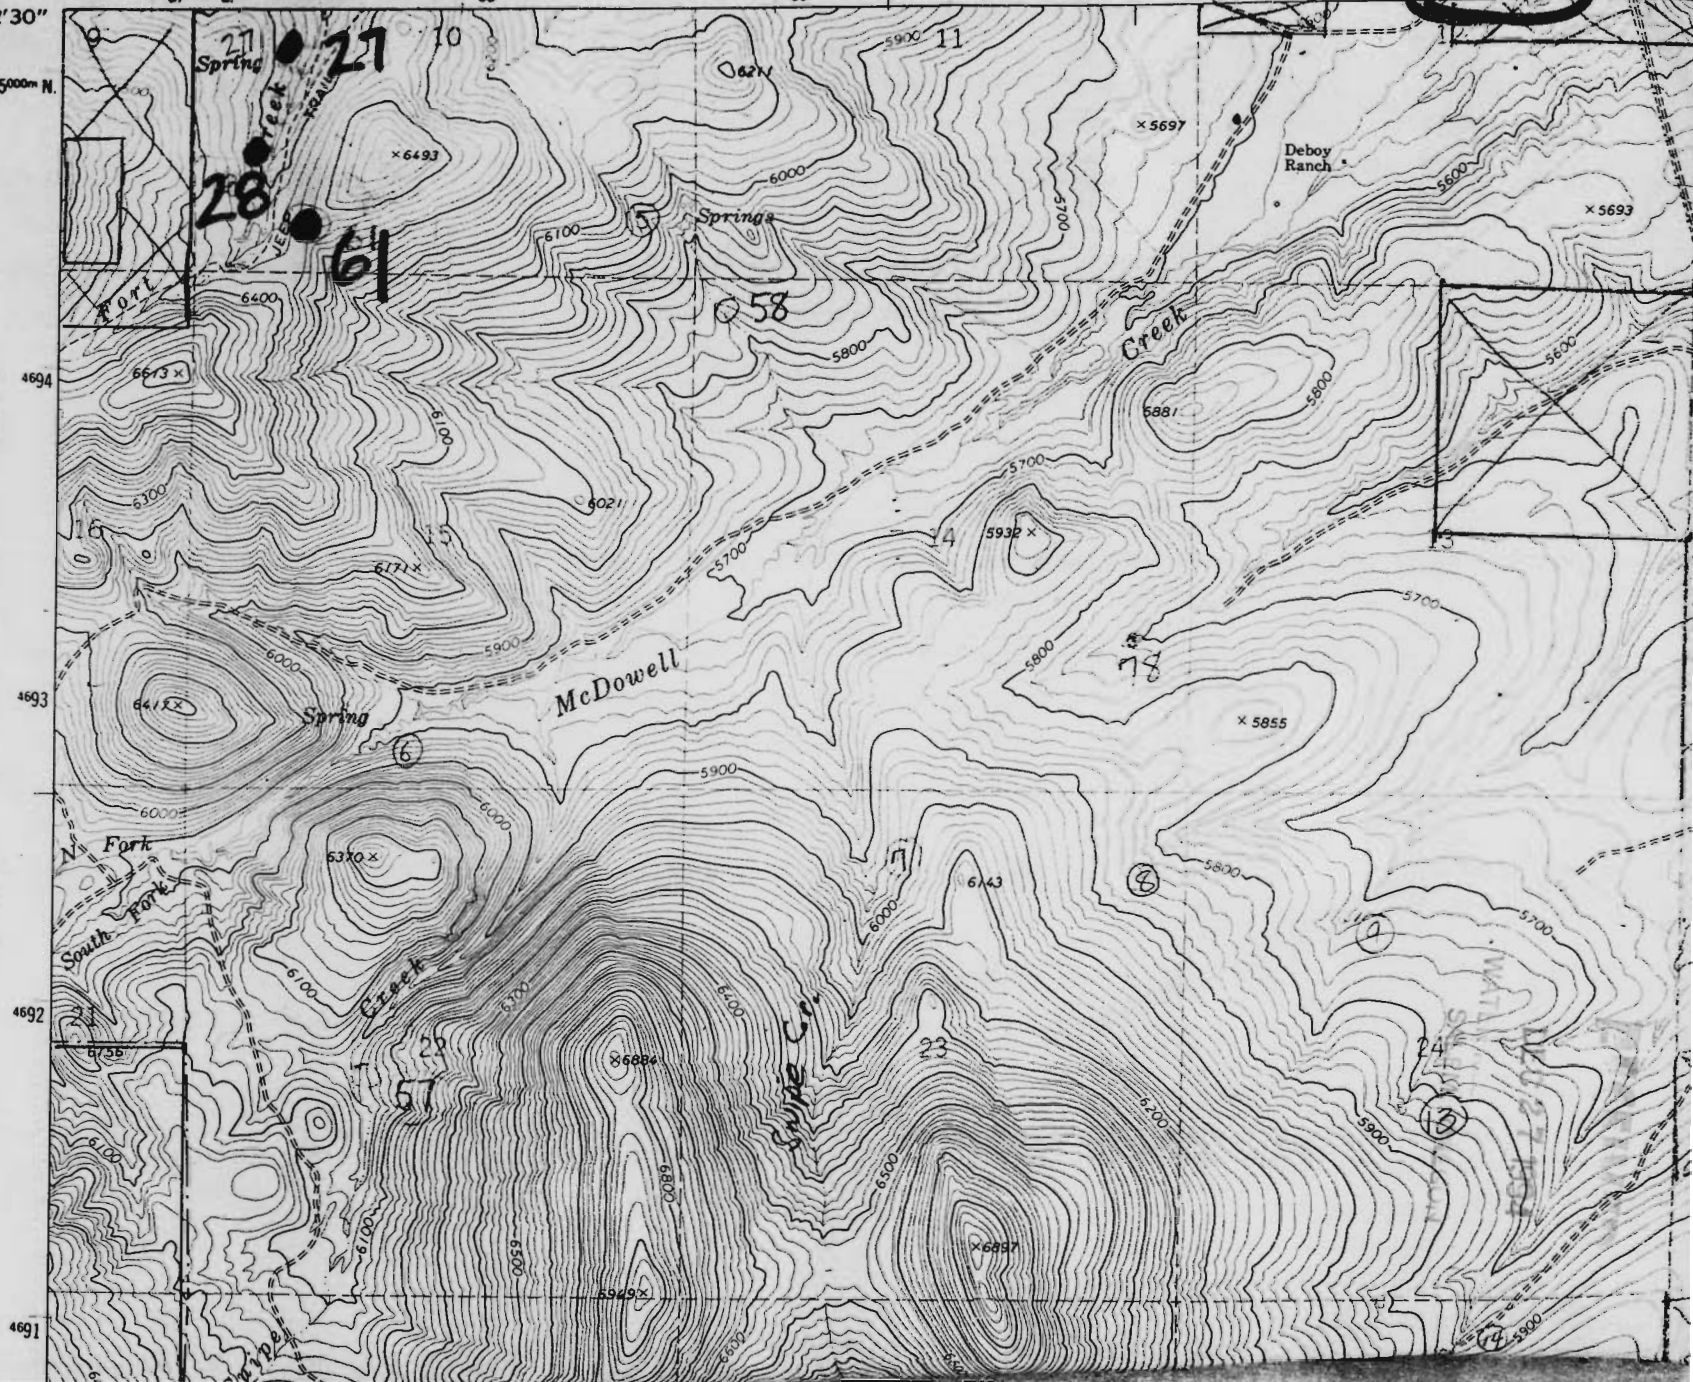

T37S

CERTIFICATE NO.

70053

Application No. *D-70066*
Permit No.