


T35S R22E



CERTIFICATE NO.

70054

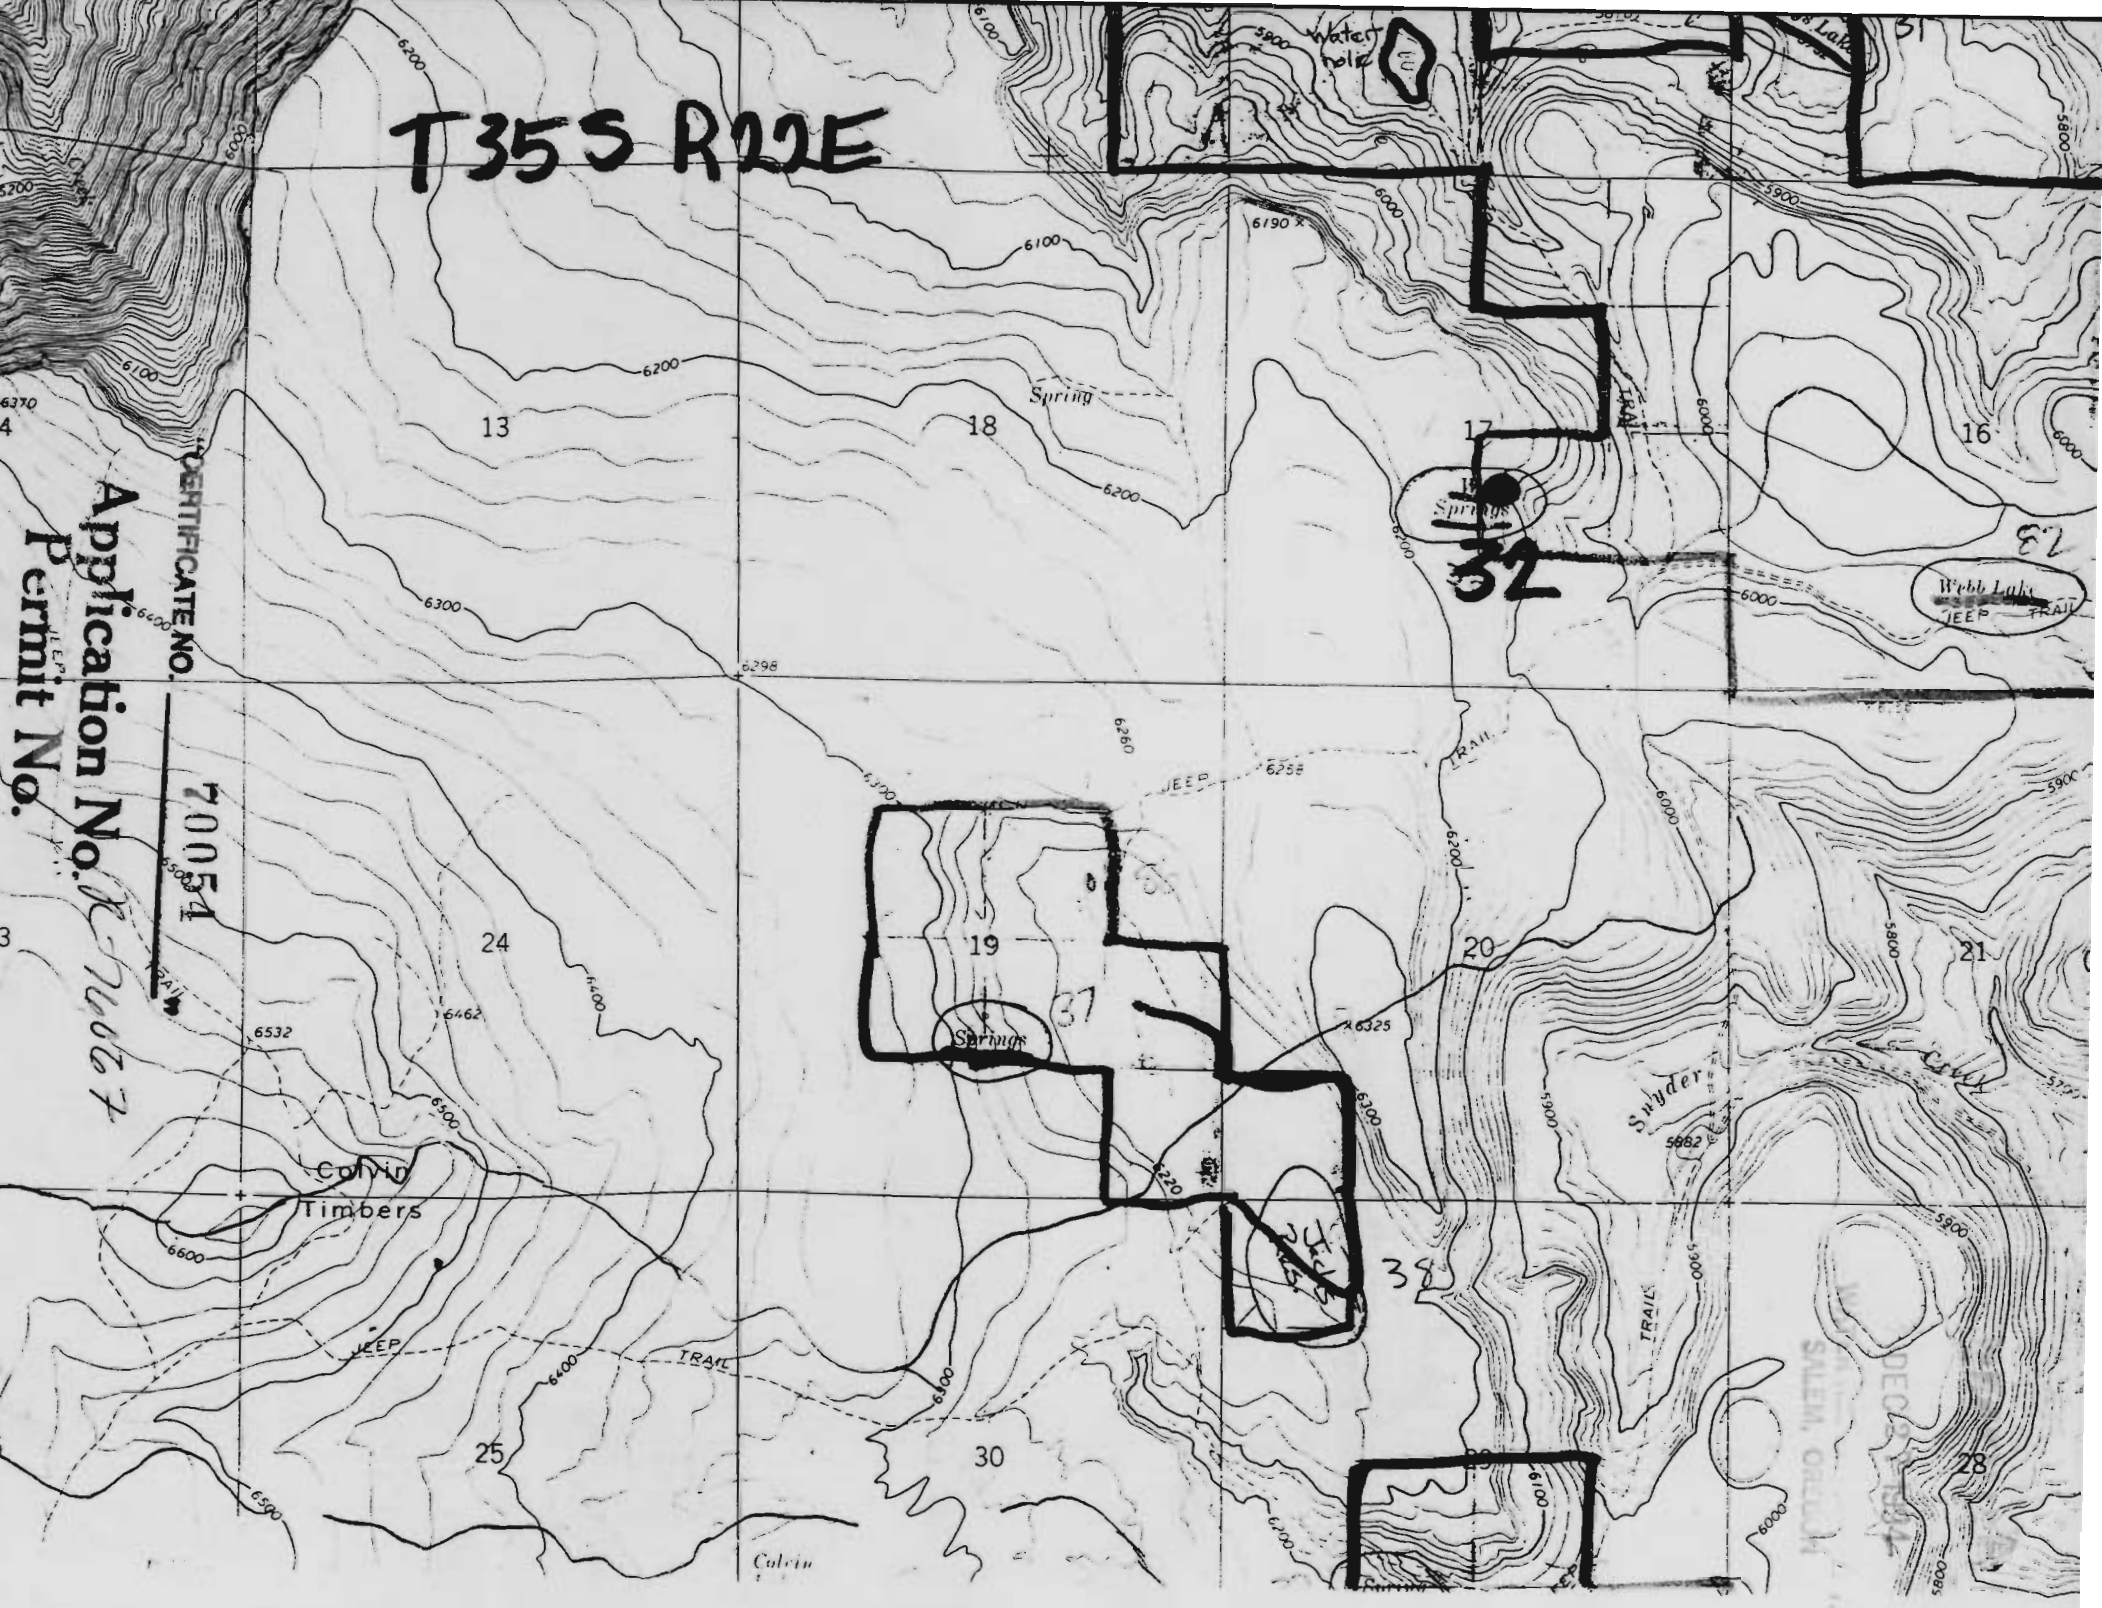

T 35 S R 23 E

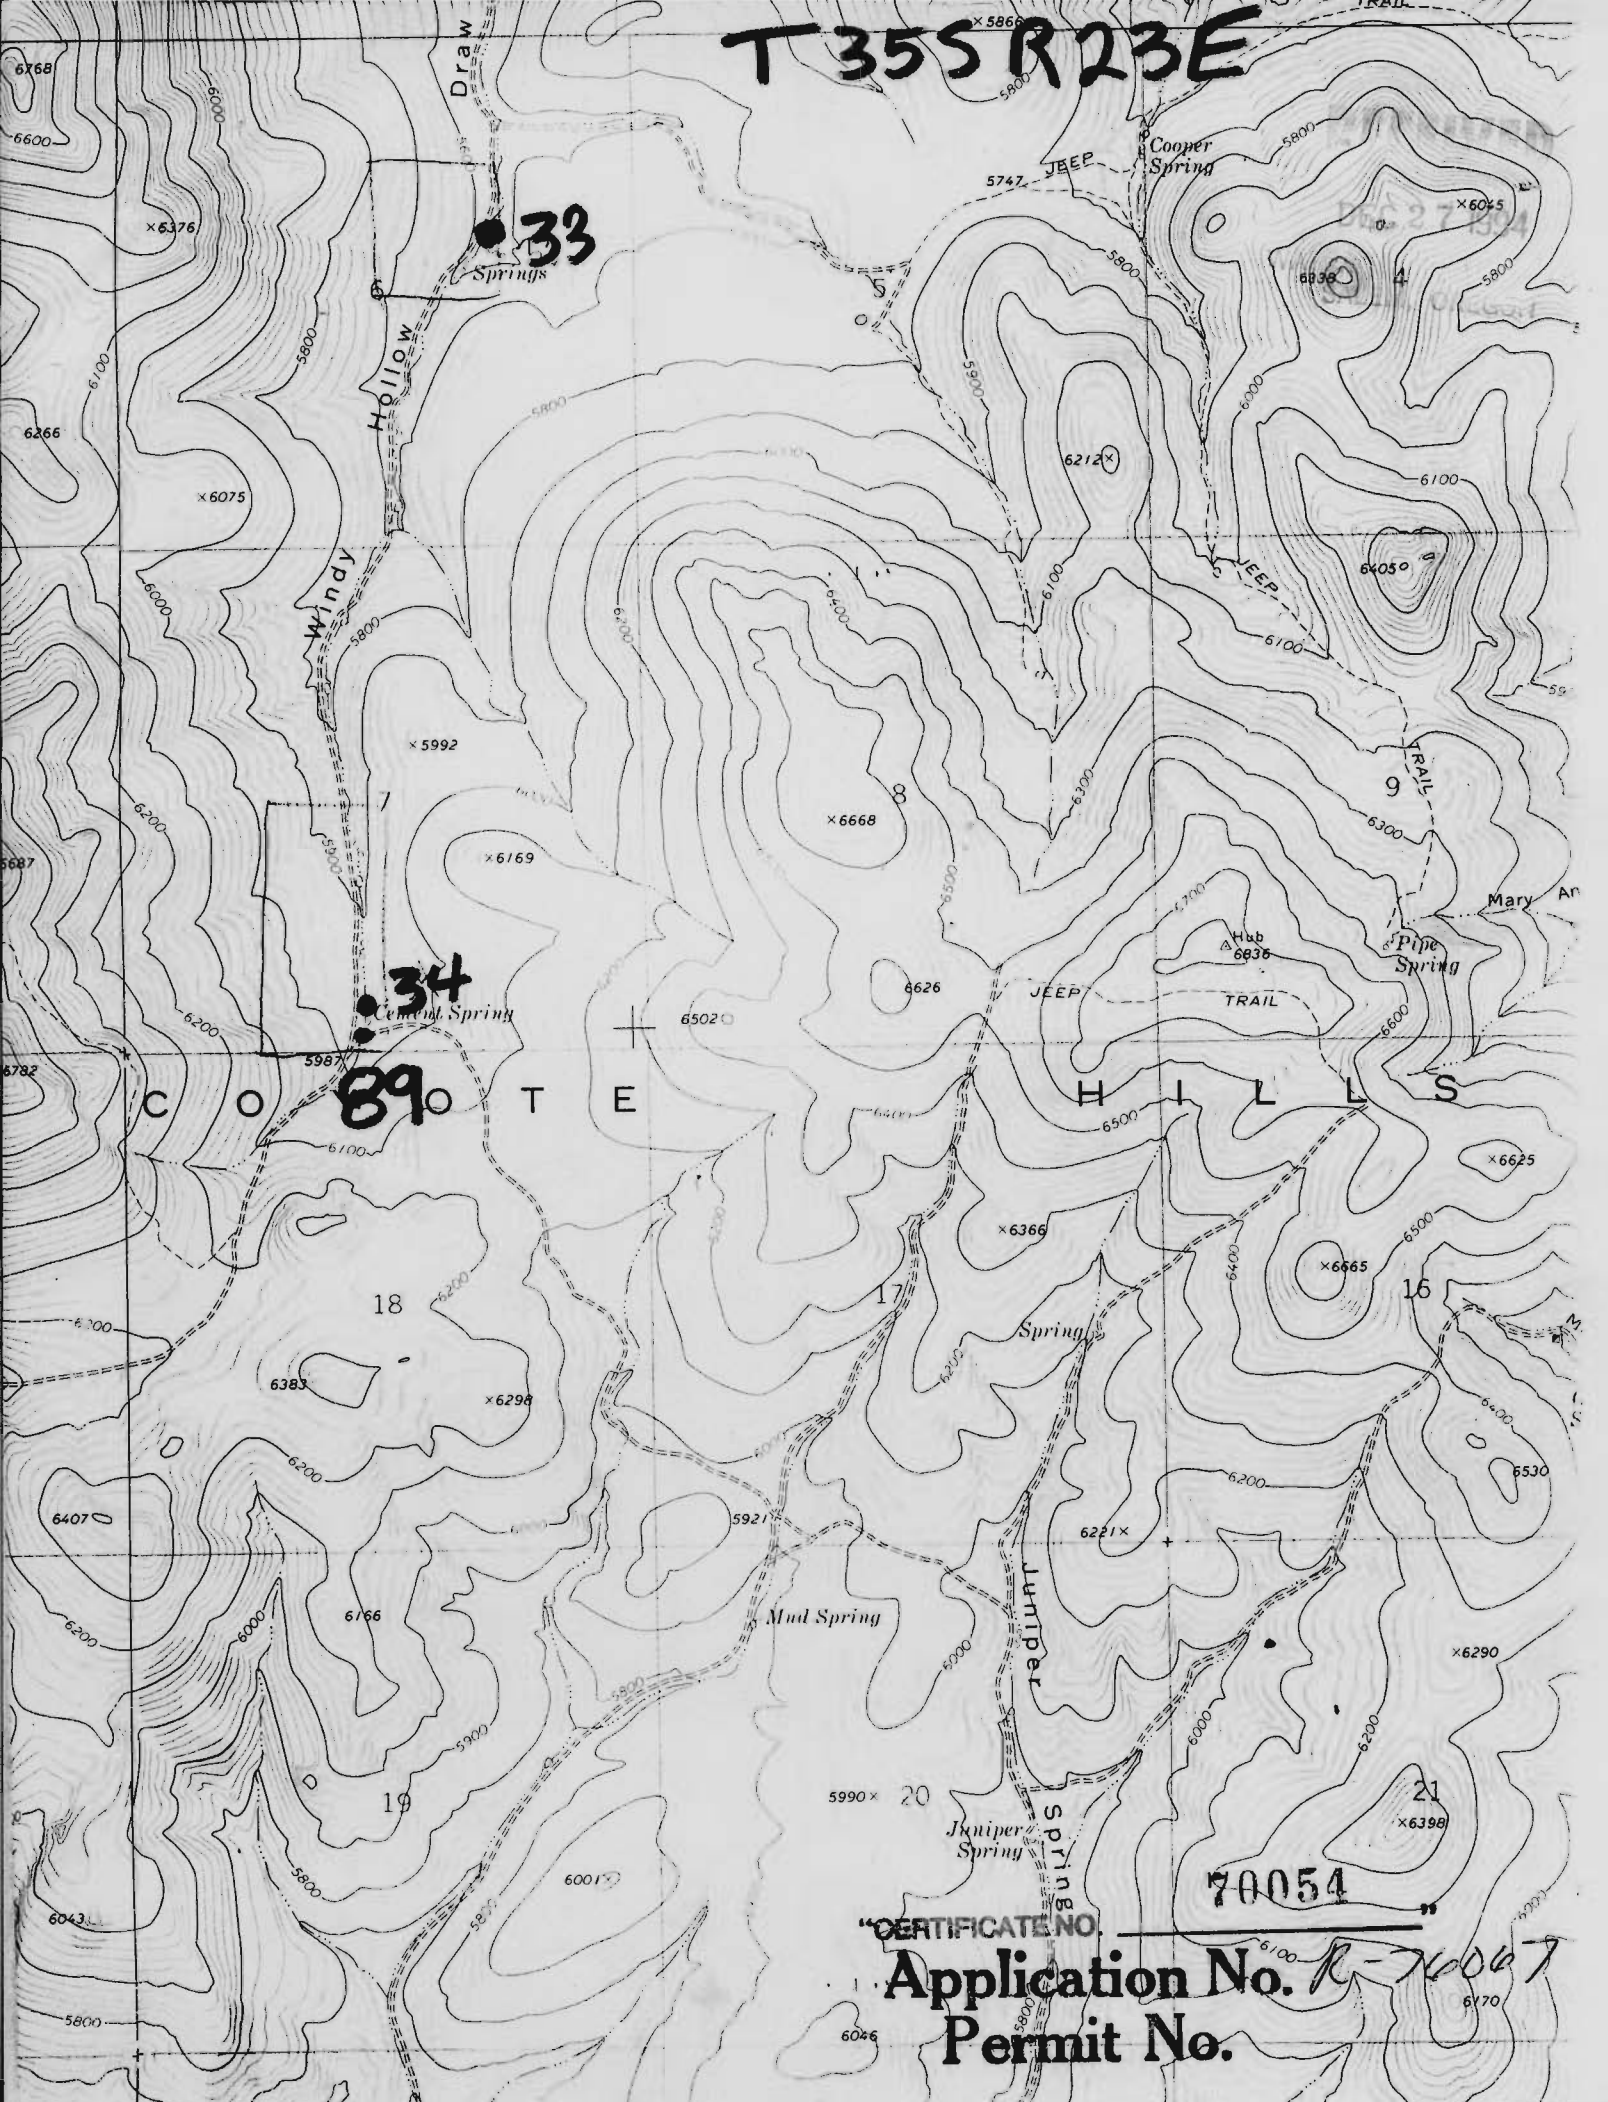

33
Springs

34
Cent Spring
89

CERTIFICATE NO.

Application No. R-76067

Permit No.

70054

Application No. R-76067
Permit No.

CERTIFICATE NO.

70054

T 35S R 23E

DEC 27 1934

SALE, OREGON

