



Application No. *R-76078*
Permit No.
"CERTIFICATE NO. 70055"

DEC 27 1994

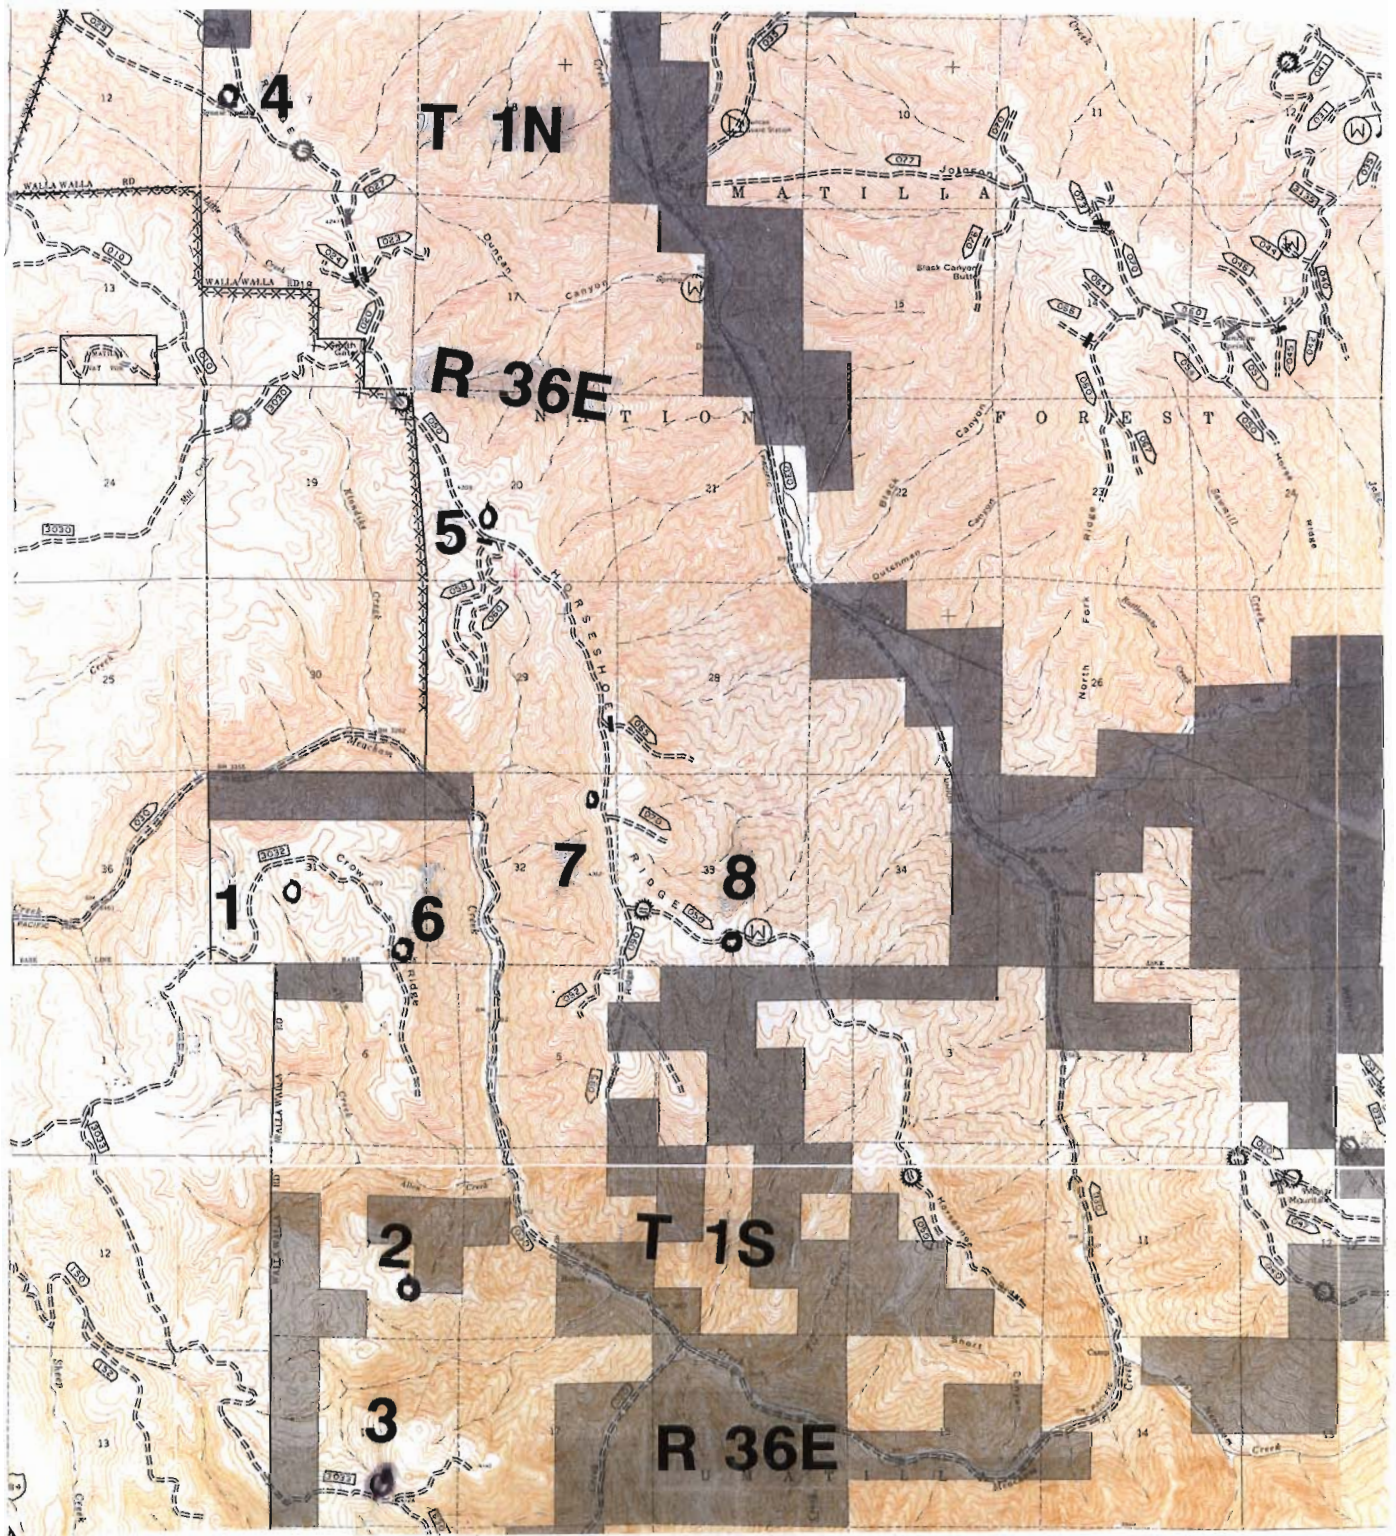

"CERTIFICATE NO. 70055

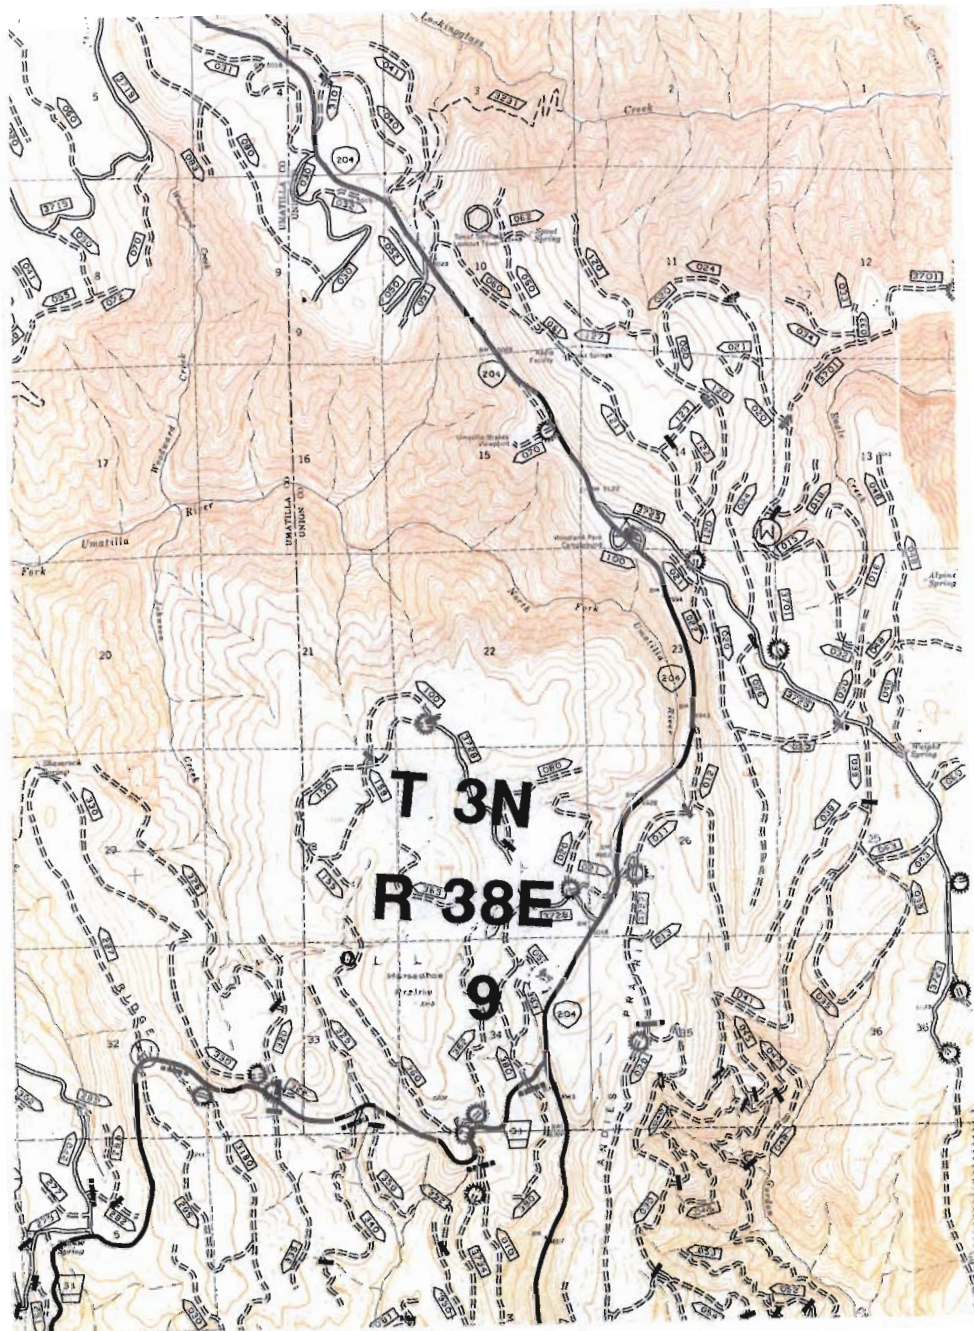

Application No. R-76068
Permit No.

"CERTIFICATE NO. 70055"

