

SECTION 24 T.39 S. R.8W. W.M.

JOSEPHINE COUNTY

Application No. R-76080
Permit No.

1" = 400'

RECEIVED


DEC 28 1994

CERTIFICATE NO.

70067

SEE MAP 39 8

WATER RESOURCES DEP.
SALEM, OREGON

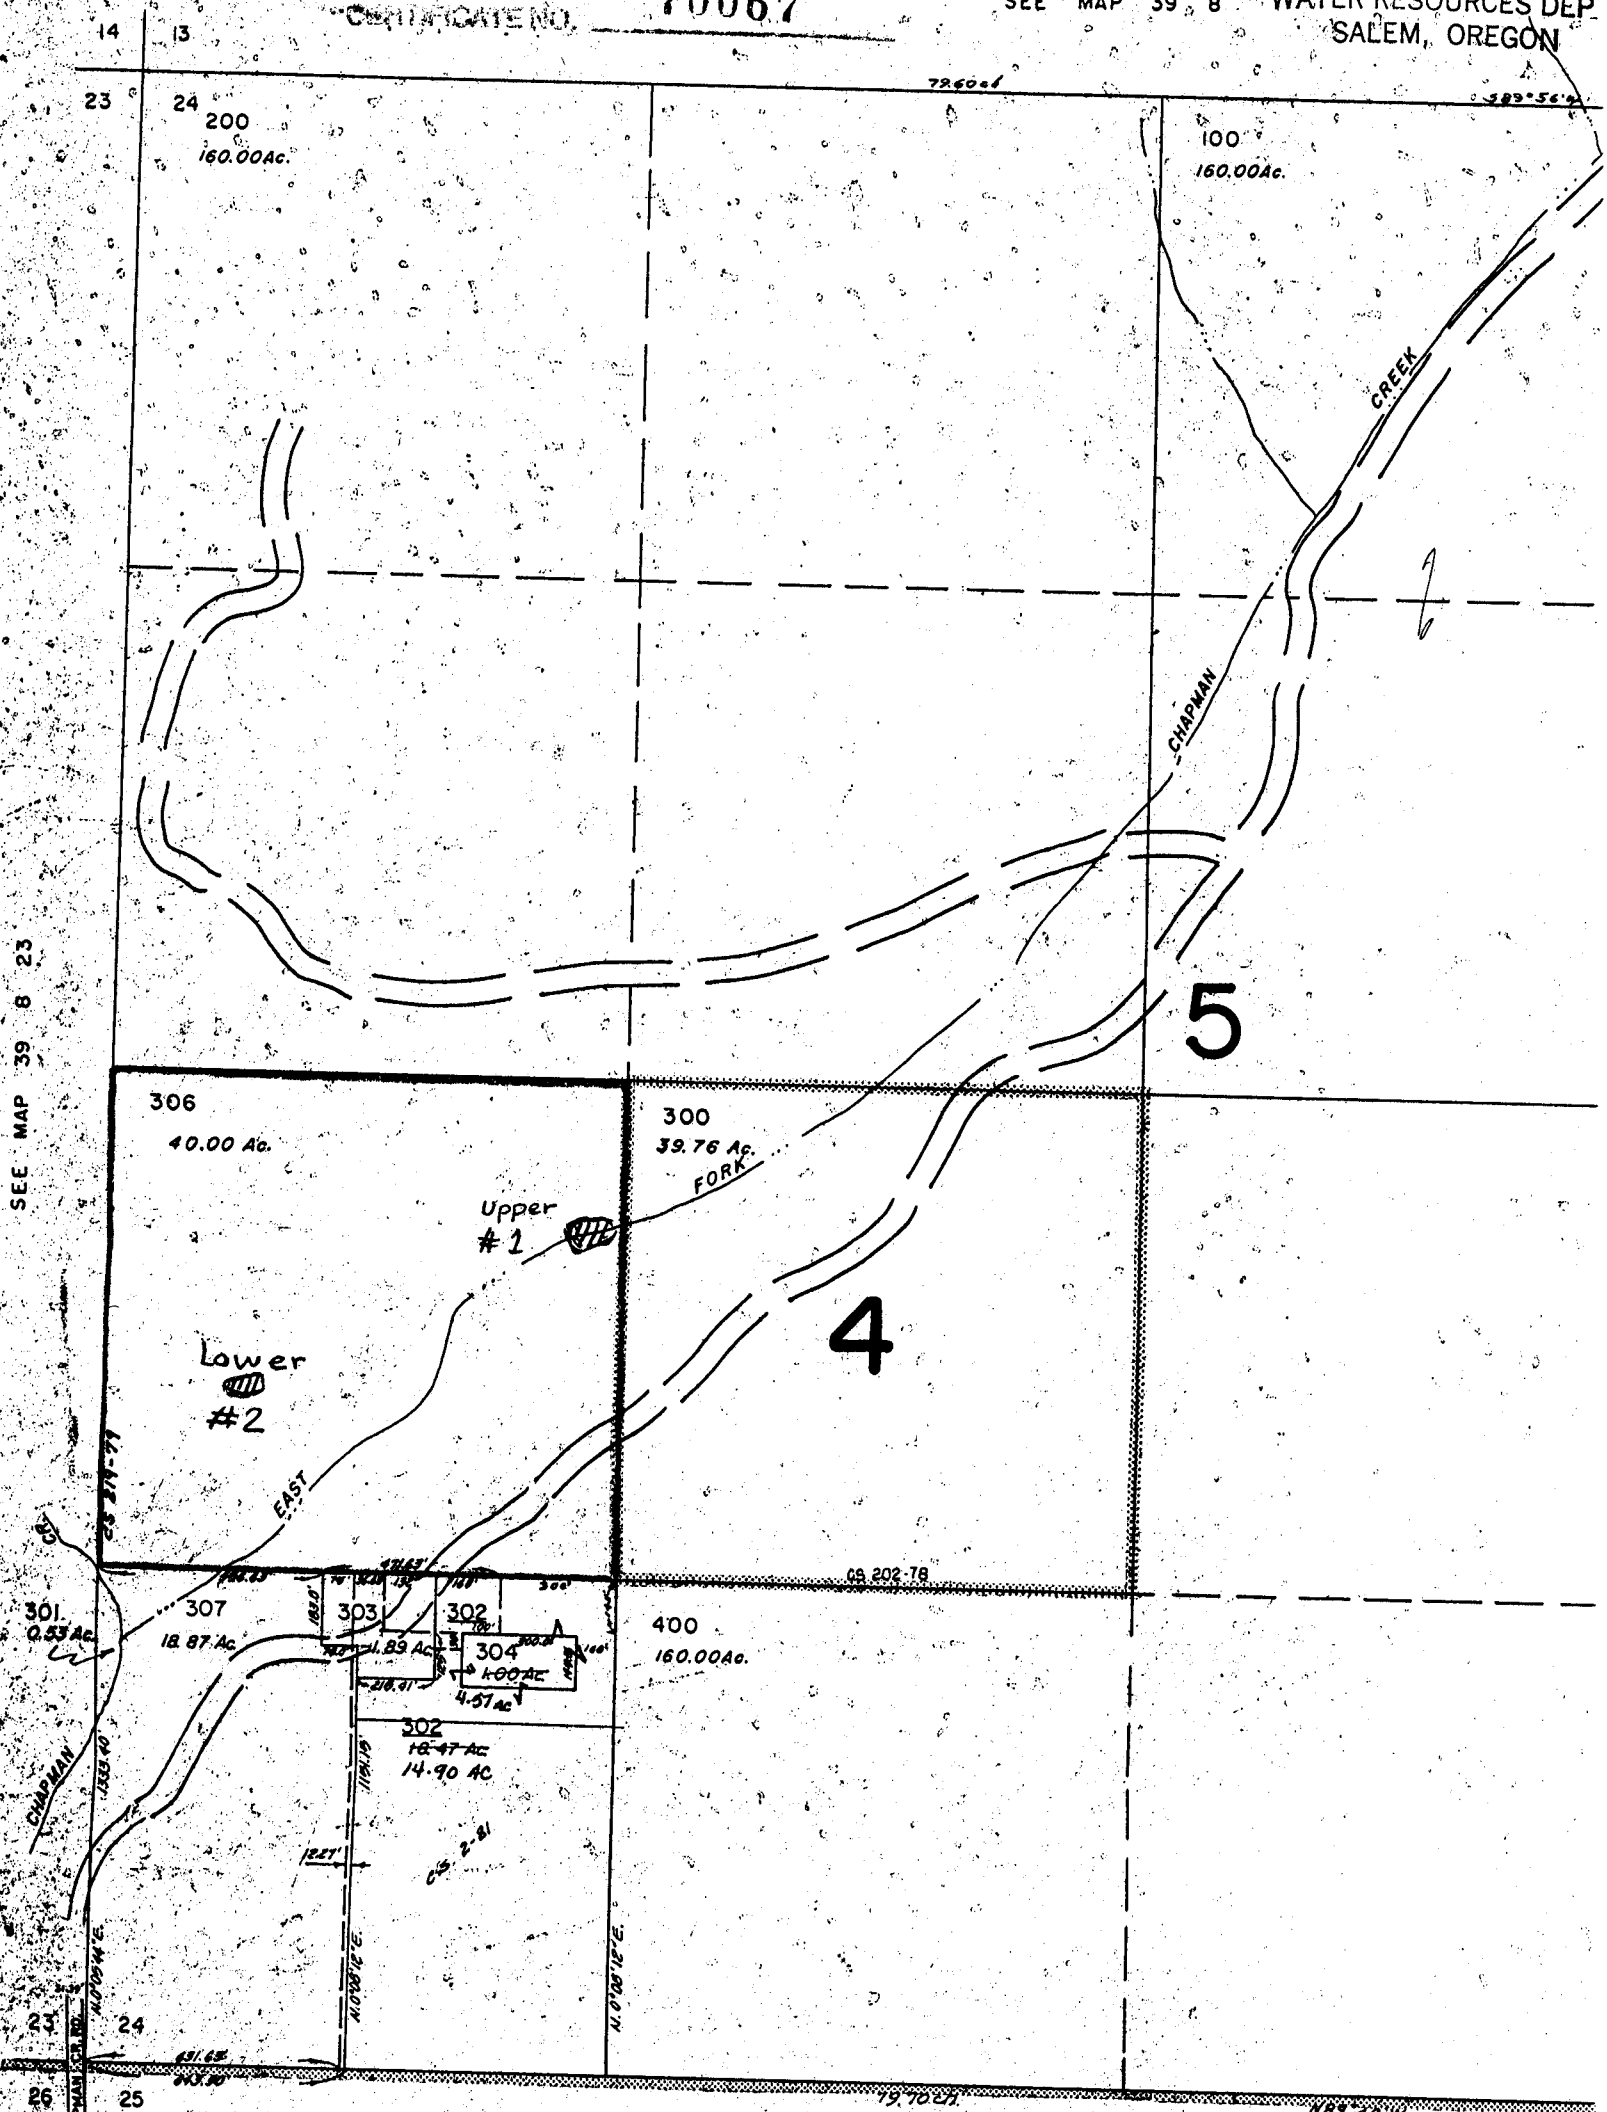

SEE MAP 39 8 25